

S.S. "Castello" No report 3912.


Iron Masts for No 238 S.S.

Scale $\frac{1}{4}$ " = 1 foot.

Dec 7/6/77
H



Fore Mast

Butts treble rivetted

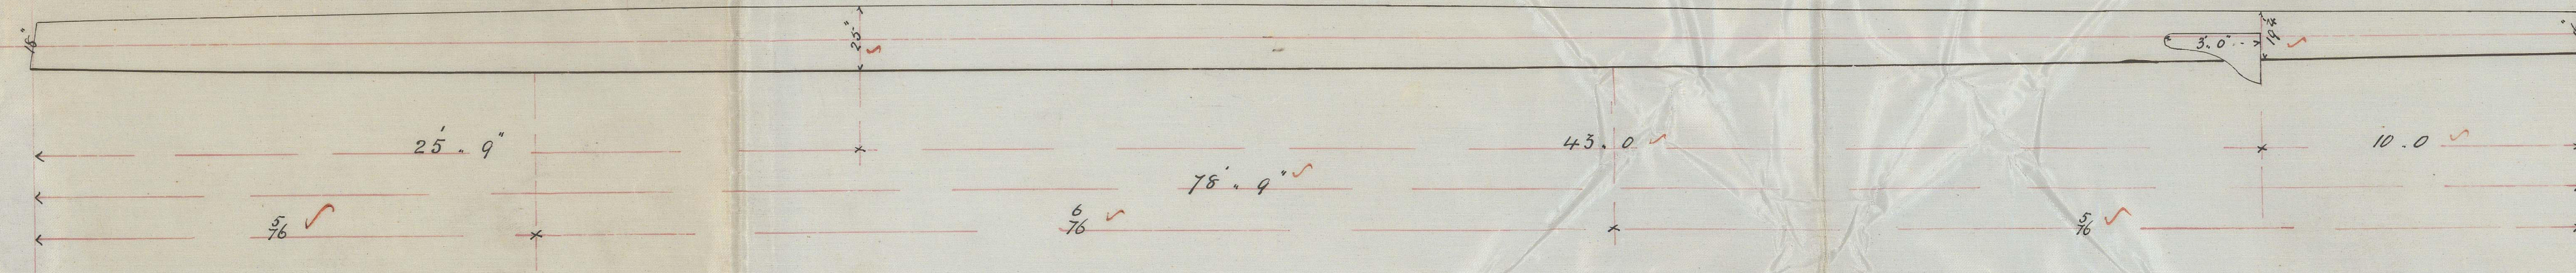


Main Mast

Butts treble rivetted

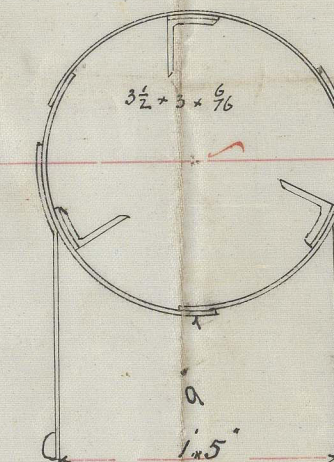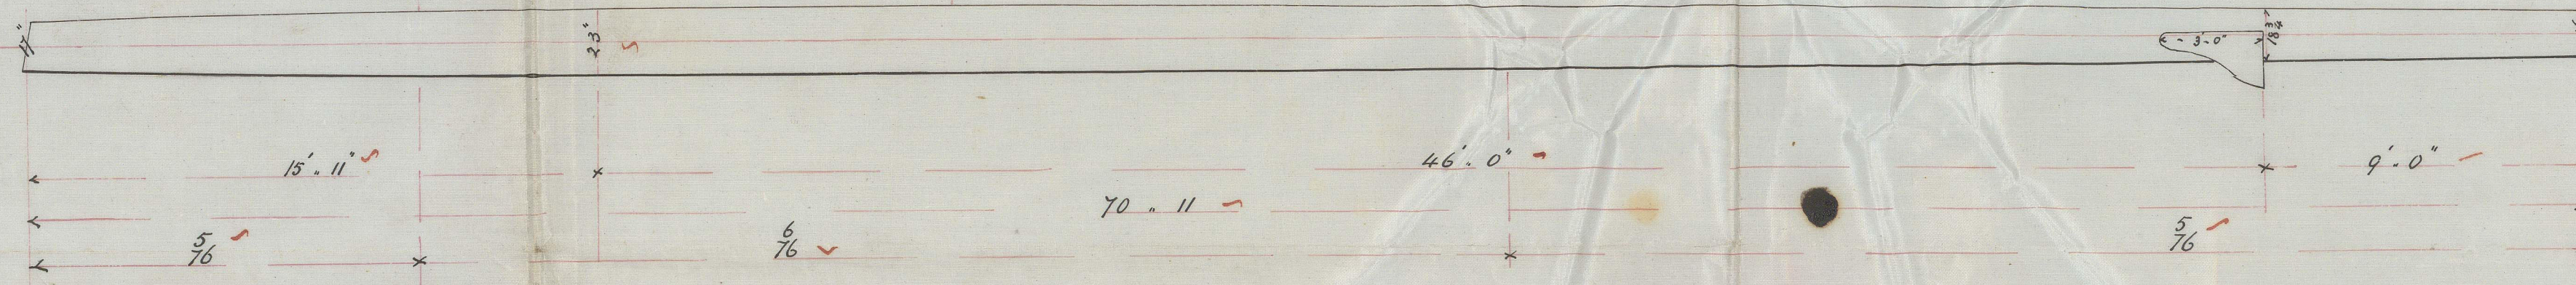

Cheeks $\frac{9}{16}$

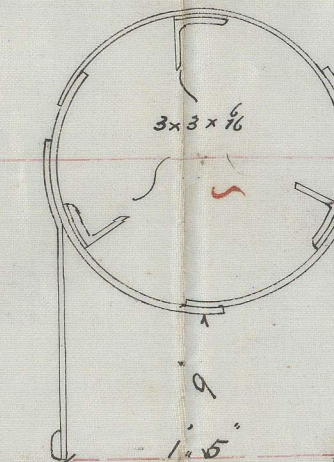

Cheeks $\frac{9}{16}$

Remarks.

- Seams single rivetted ✓
- Butts double rivetted except where marked treble ✓
- Three angles in each running whole length ✓
- Plates 9ft. long - Butts shifted 3ft ✓
- Straps 9" for double 18" for treble rivetting ✓
- Rivets $\frac{5}{16}$ all flush outside ✓
- Butt straps inside. ✓

RICHARDSON, DUCK & CO.,
Iron Ship Builders,
STOCKTON-ON-TEES.

June 4th 1877

IRON 524-0064

18m
8/6/77
© 2021
Lloyd's Register
Foundation