



Arrangement of Stringers & Ties on Upper Deck
 Scale 1/4" = 1 foot

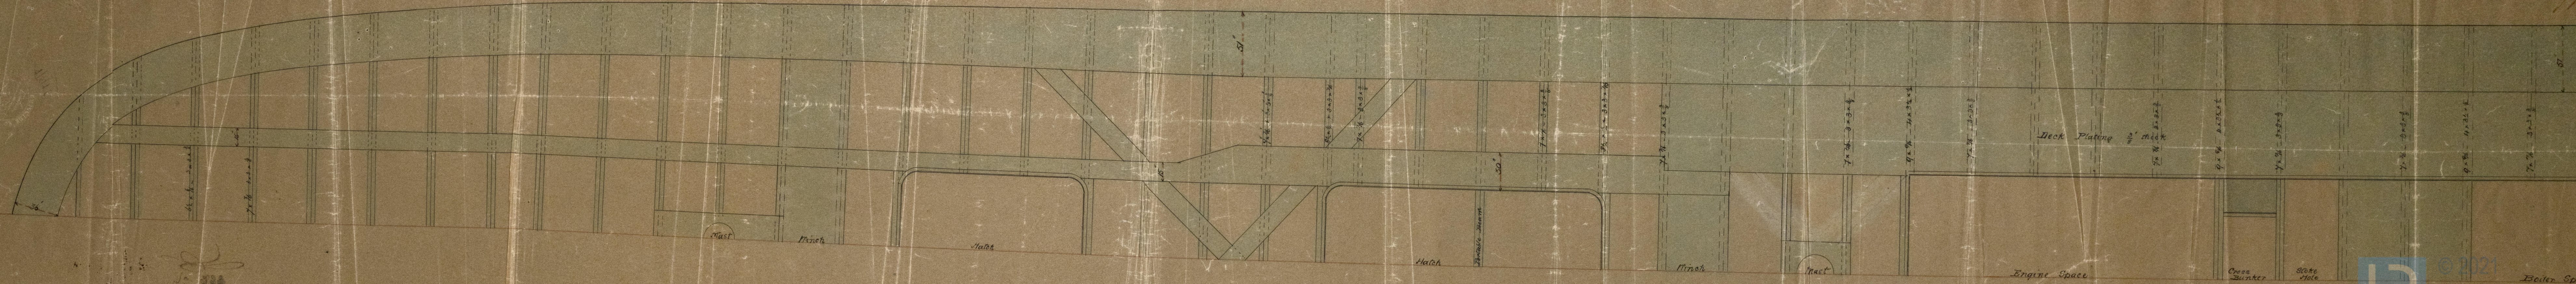

cc 11/5 89

S. S. "Castello" - No report 3912.

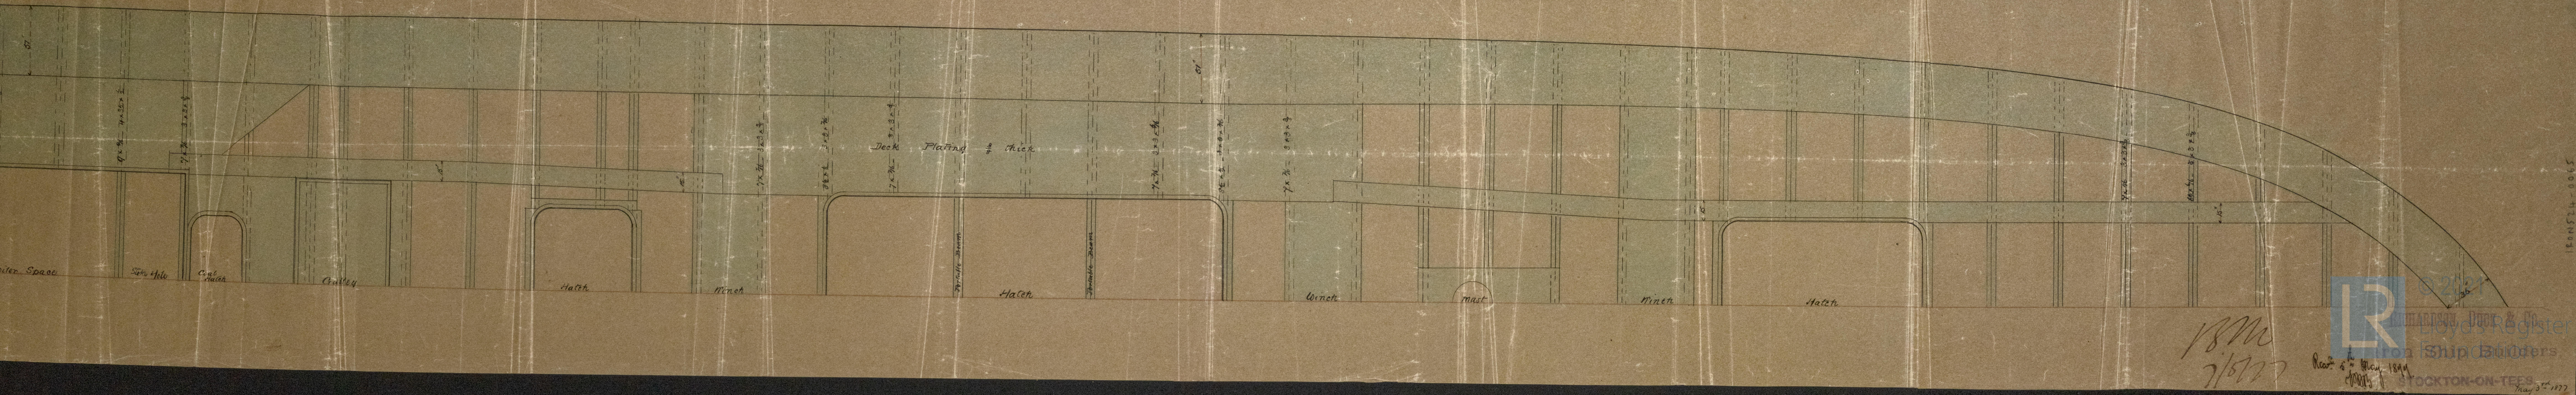

90 230



© 2021
Lloyd's Register
Foundation