


S.S. "Castello" No report 3912.

Plan of Midship Ballast Tank

No. 238 S.S.

Scale  $\frac{1}{2}$ " = 1 foot.

Rev 1/4/77

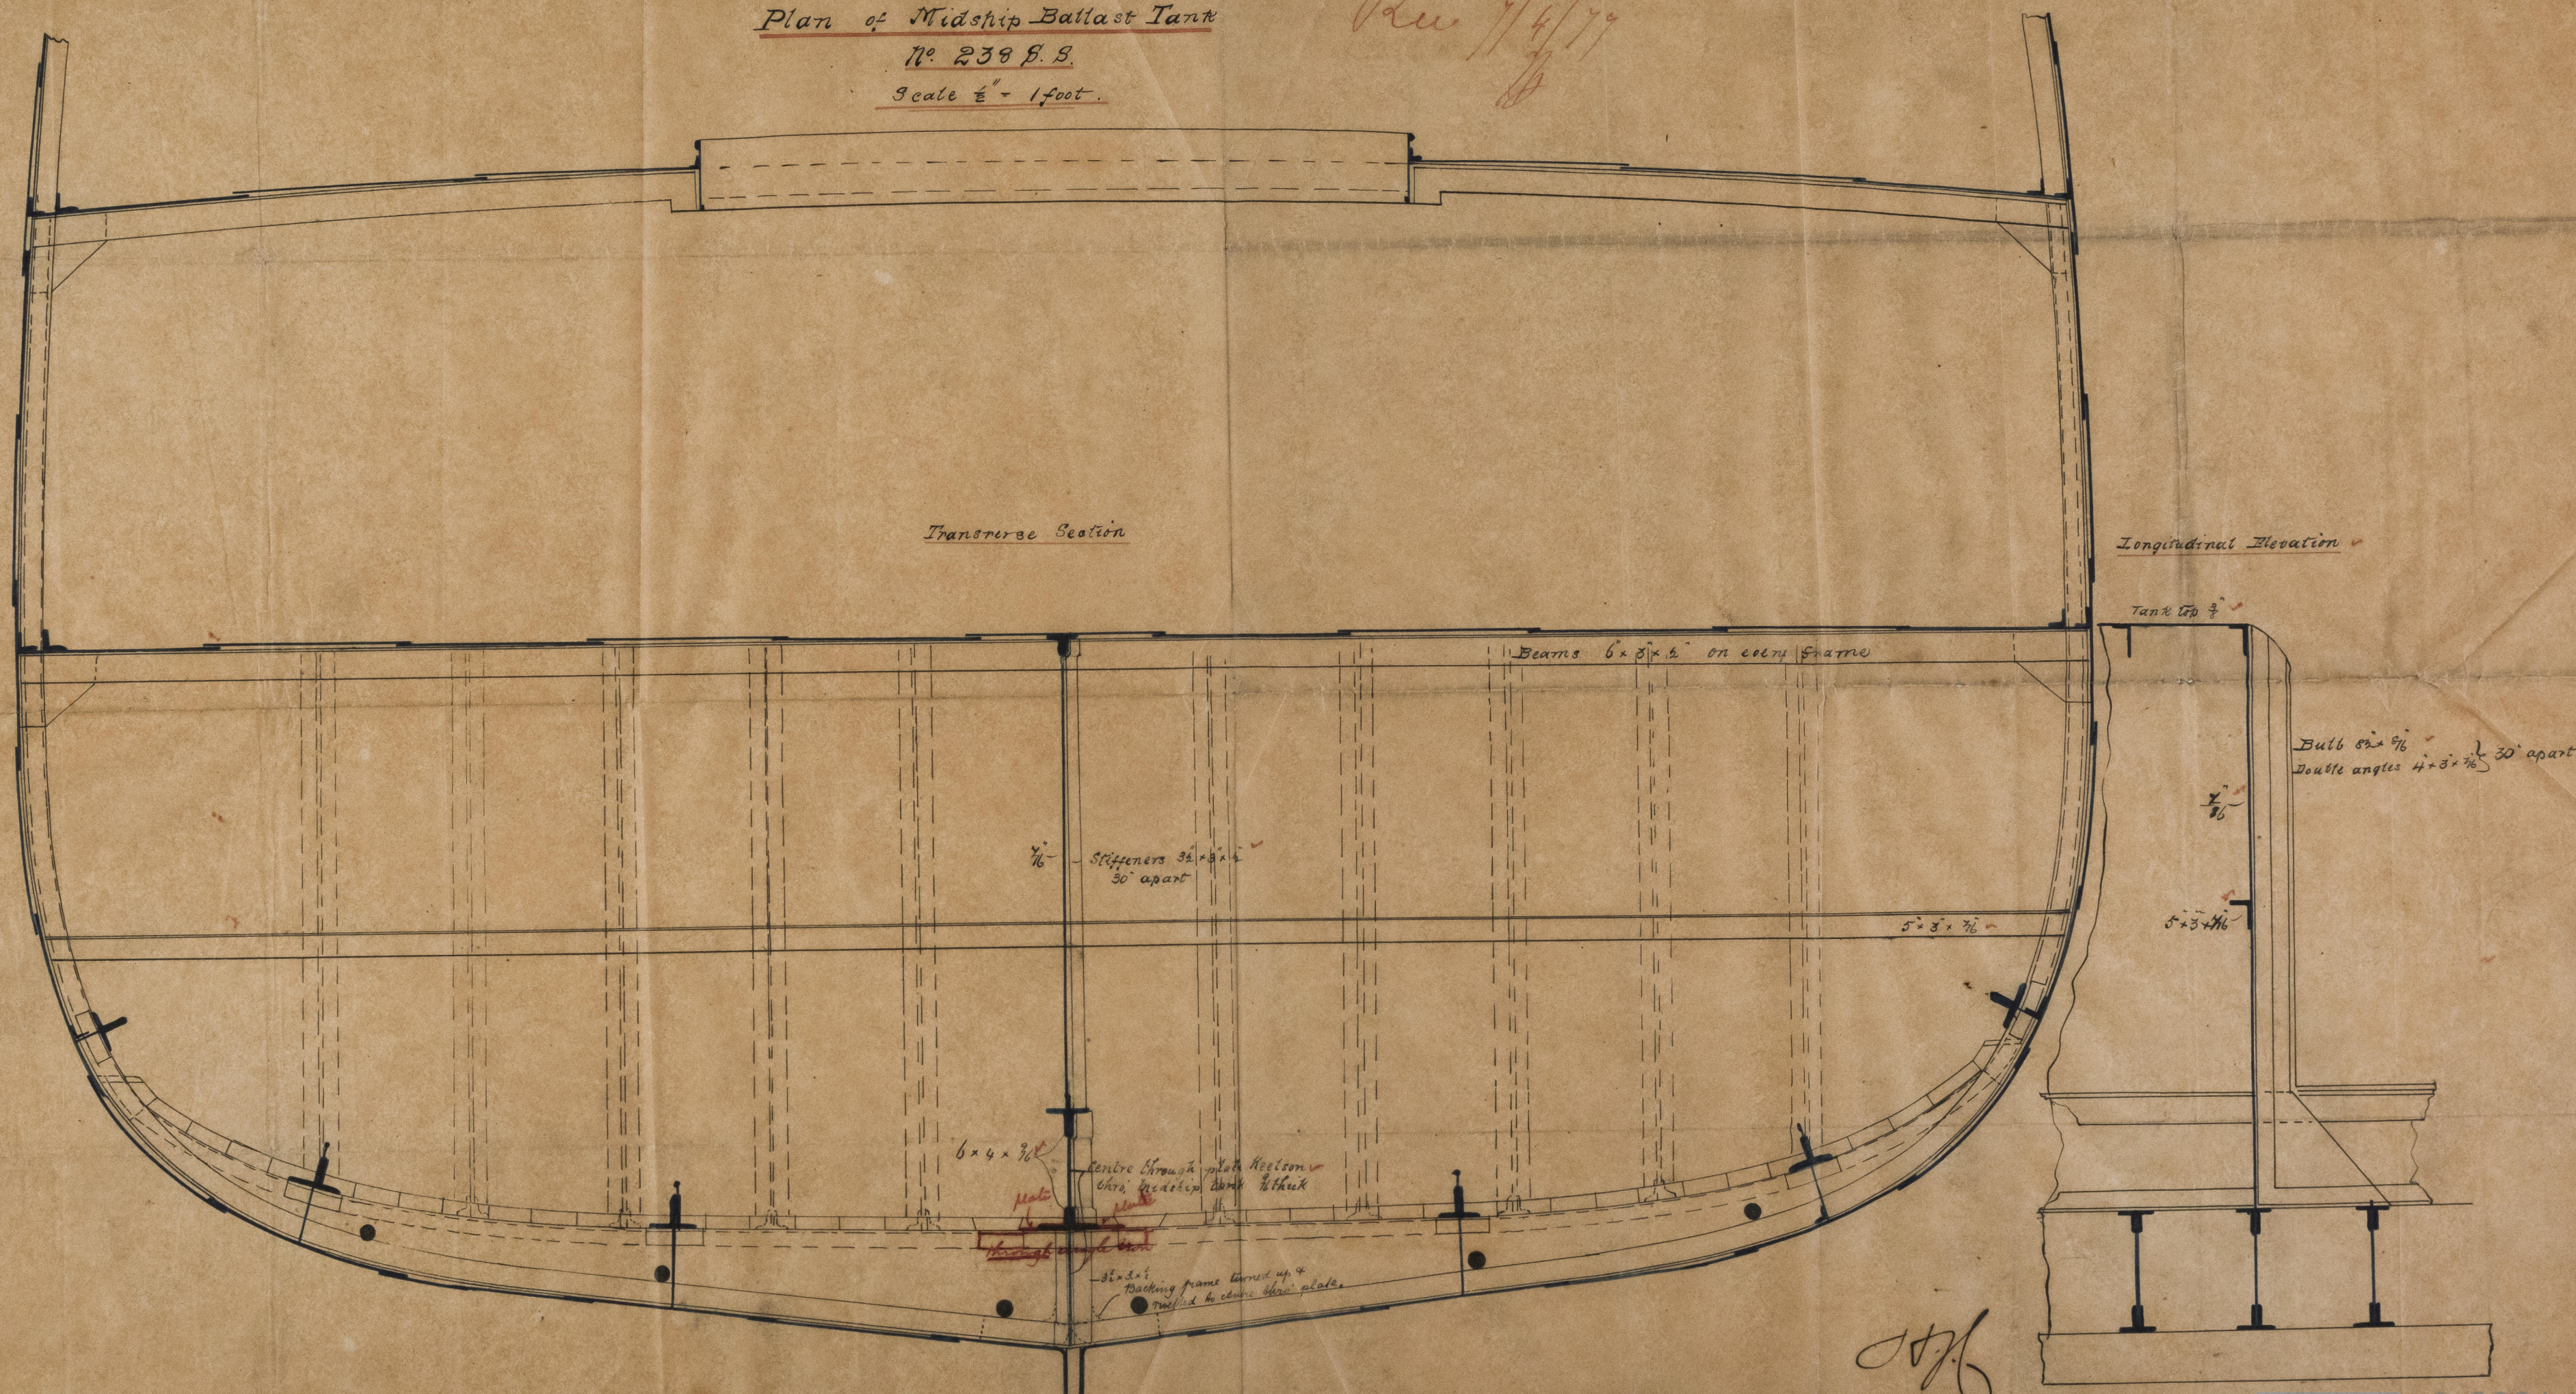

24/4/77

Rev 23<sup>rd</sup> 1899