


Scale $\frac{1}{2}'' = 1 \text{ foot.}$

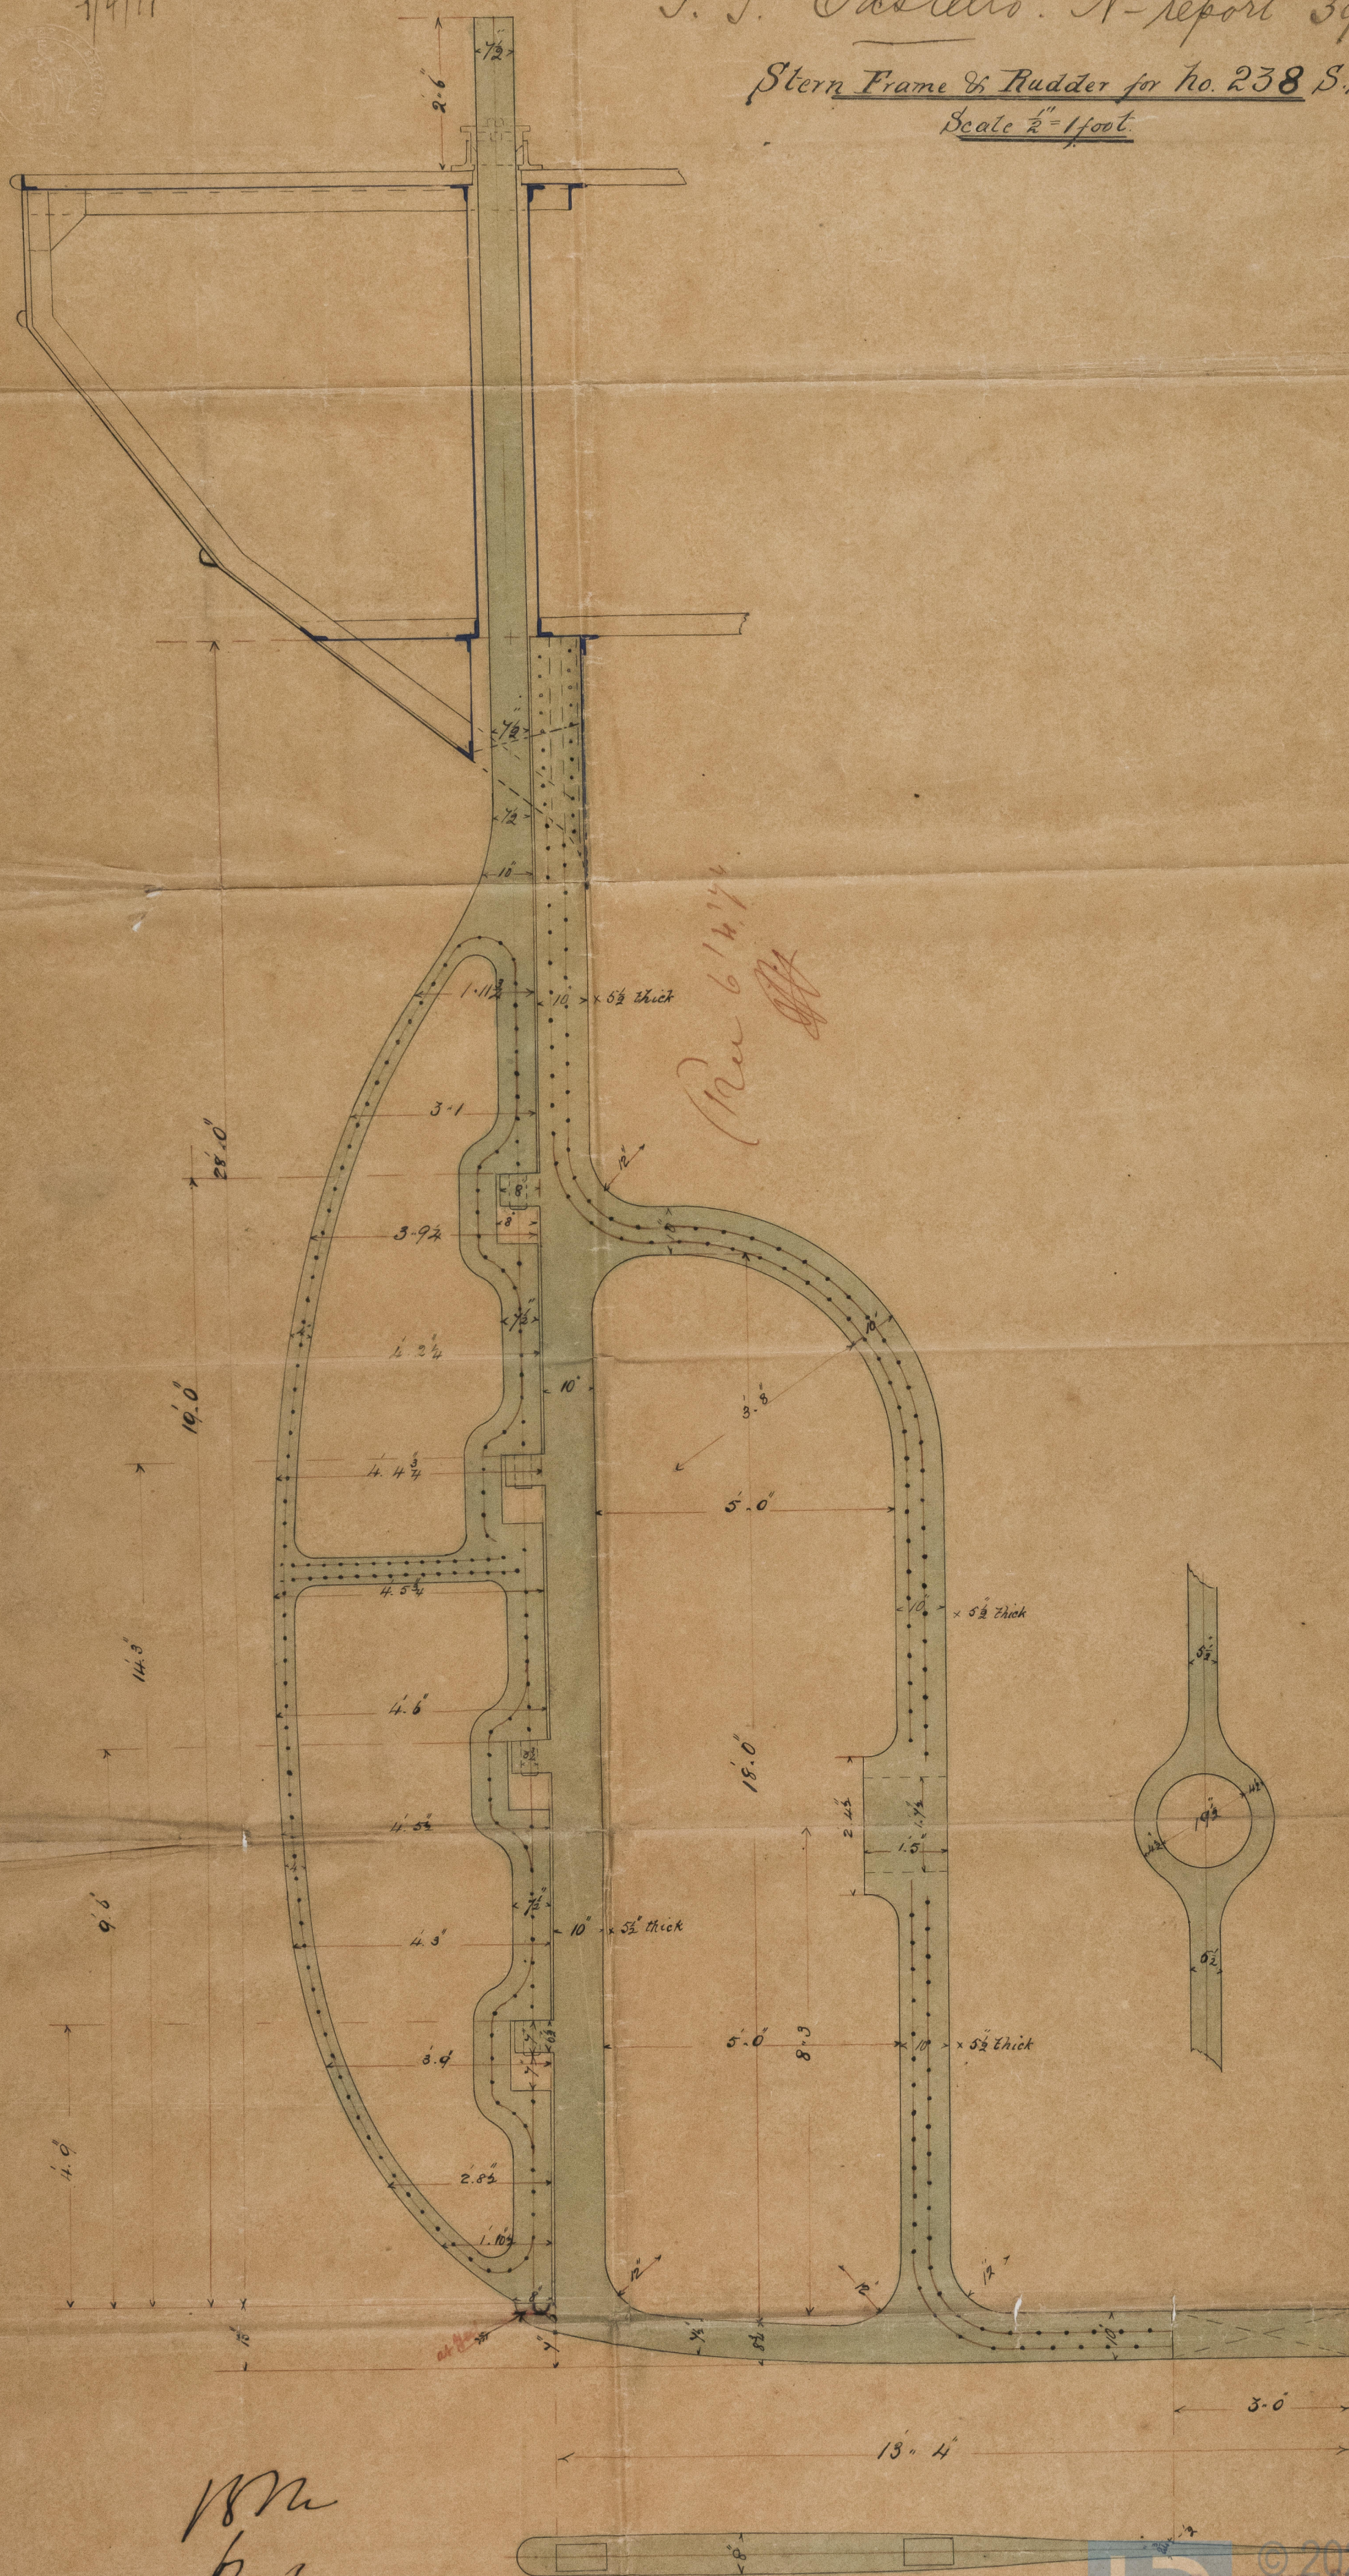

18m
64777


RICHARDSON, BUCK & CO.,

Iron Ship Builders Register

Foundation

March 20th = 18th year

120N524-0070