


S.S. "Castello" No.


No 238 S.S.

Gauge 4 - 1 foot

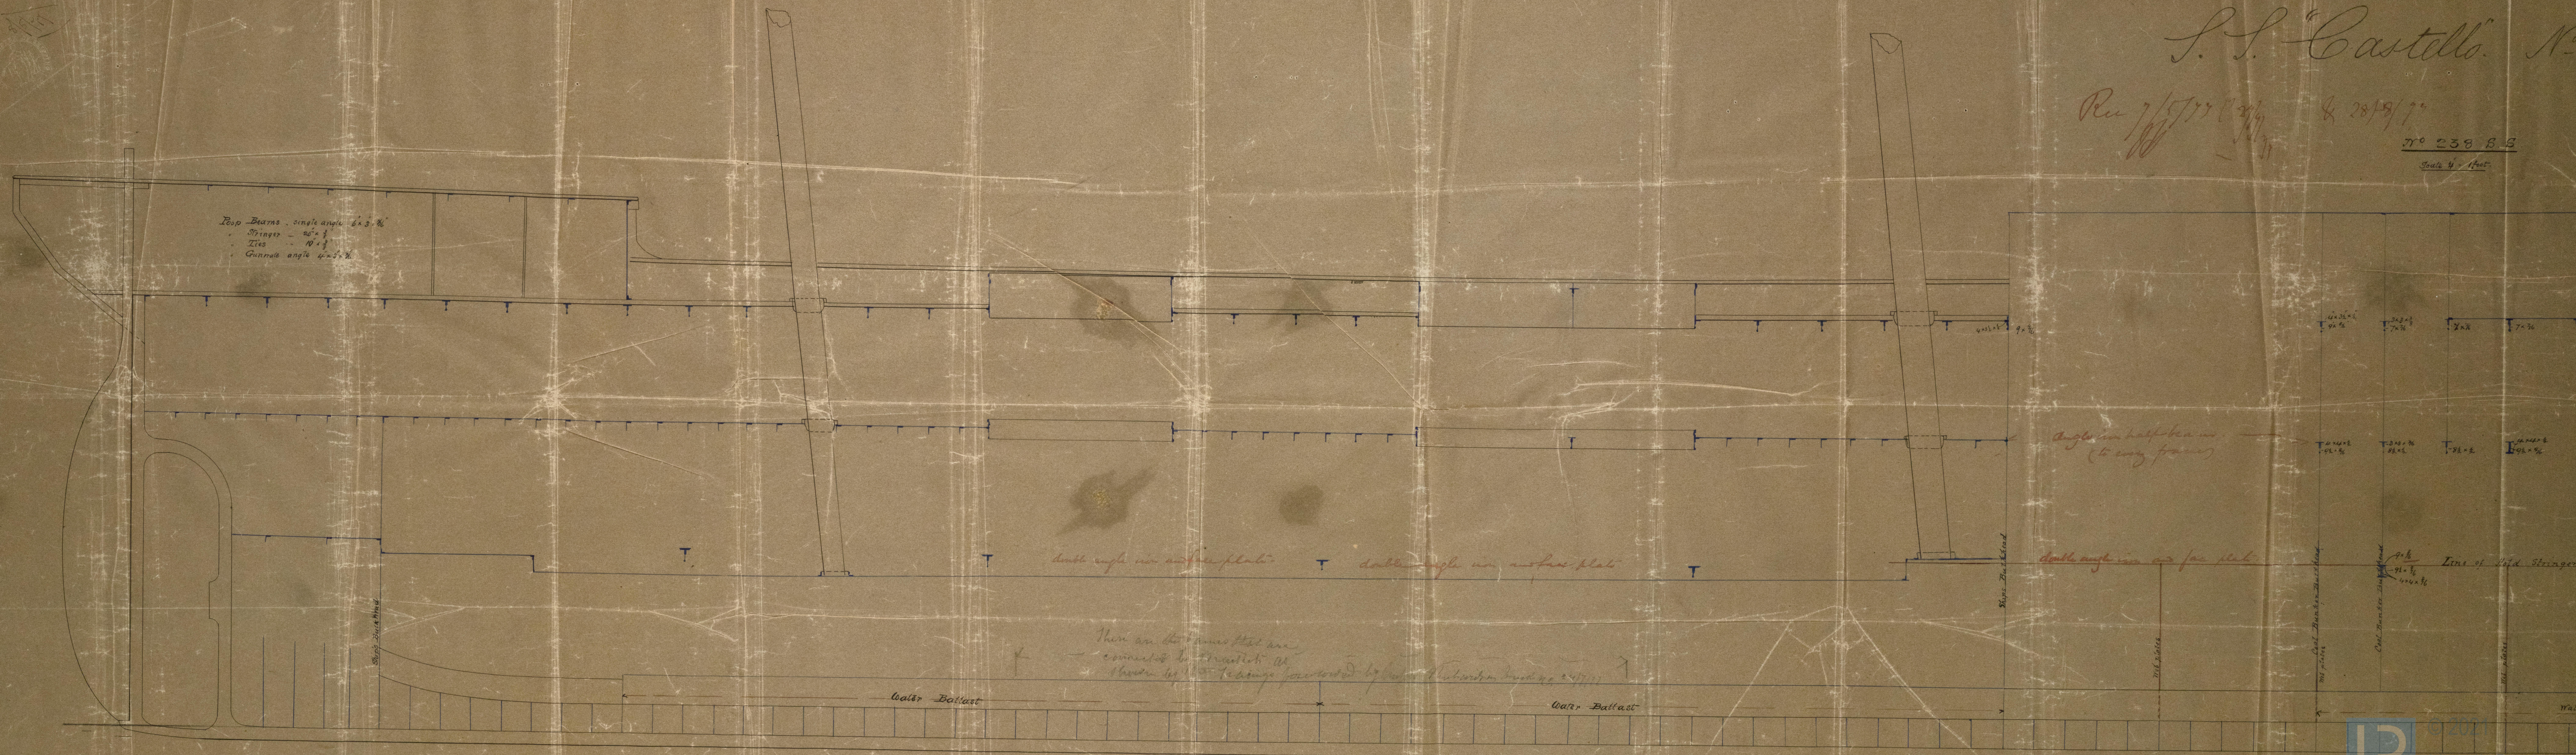

No report 3912.

3.5



18th
7/5/77

RICHARDSON, DICK & CO.
SHIP BUILDERS
STOCKTON-ON-TEES
May 1894

IRON 524-0071