


Dimensions.  
 Length from After part of Stem to Fore part of Post. 233'-<sup>7</sup>/<sub>8</sub>  
 Breadth Moulded. 32'-4"  
 Depth to Skirt. 19'-<sup>7</sup>/<sub>8</sub>  
 11-12 Depths to length.  
 7-<sup>7</sup>/<sub>8</sub> Breadths.

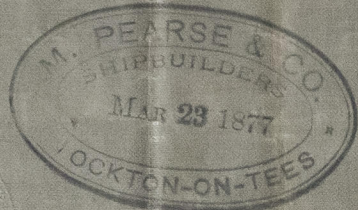

31/3/77

J. S. Dalton. No report 3915.

# MIDSHIP SECTION

OF  
 No 157 S.S.

Scale 1/2 Inch to one Foot

235'-0" x 32'-6" x 17'-11"

Class 100 A at Lloyd's.


Particulars	
T.G.F. Beams built	6 1/2 x 9/16
" " Angles	2 1/2 x 3/4
Bridge " "	6 3/4 x 7/16
" T.G.F. Stringer	2 1/2 x 3/4
" " Ties	10 x 7/16
" " Angles	3 1/2 x 3/4
" " Sides	6 1/2
" " Decks	5 x 3/4 P

32'-2"  
 16'-2"  
 17'-11"  
 1'-8 1/2"  
 67'-11 1/2" x 233'-9" = 15886'

65 x 158860  
 68 166800

32.16  
 19.00  
 51.16

Rev 28/3/77 & 4/4/77

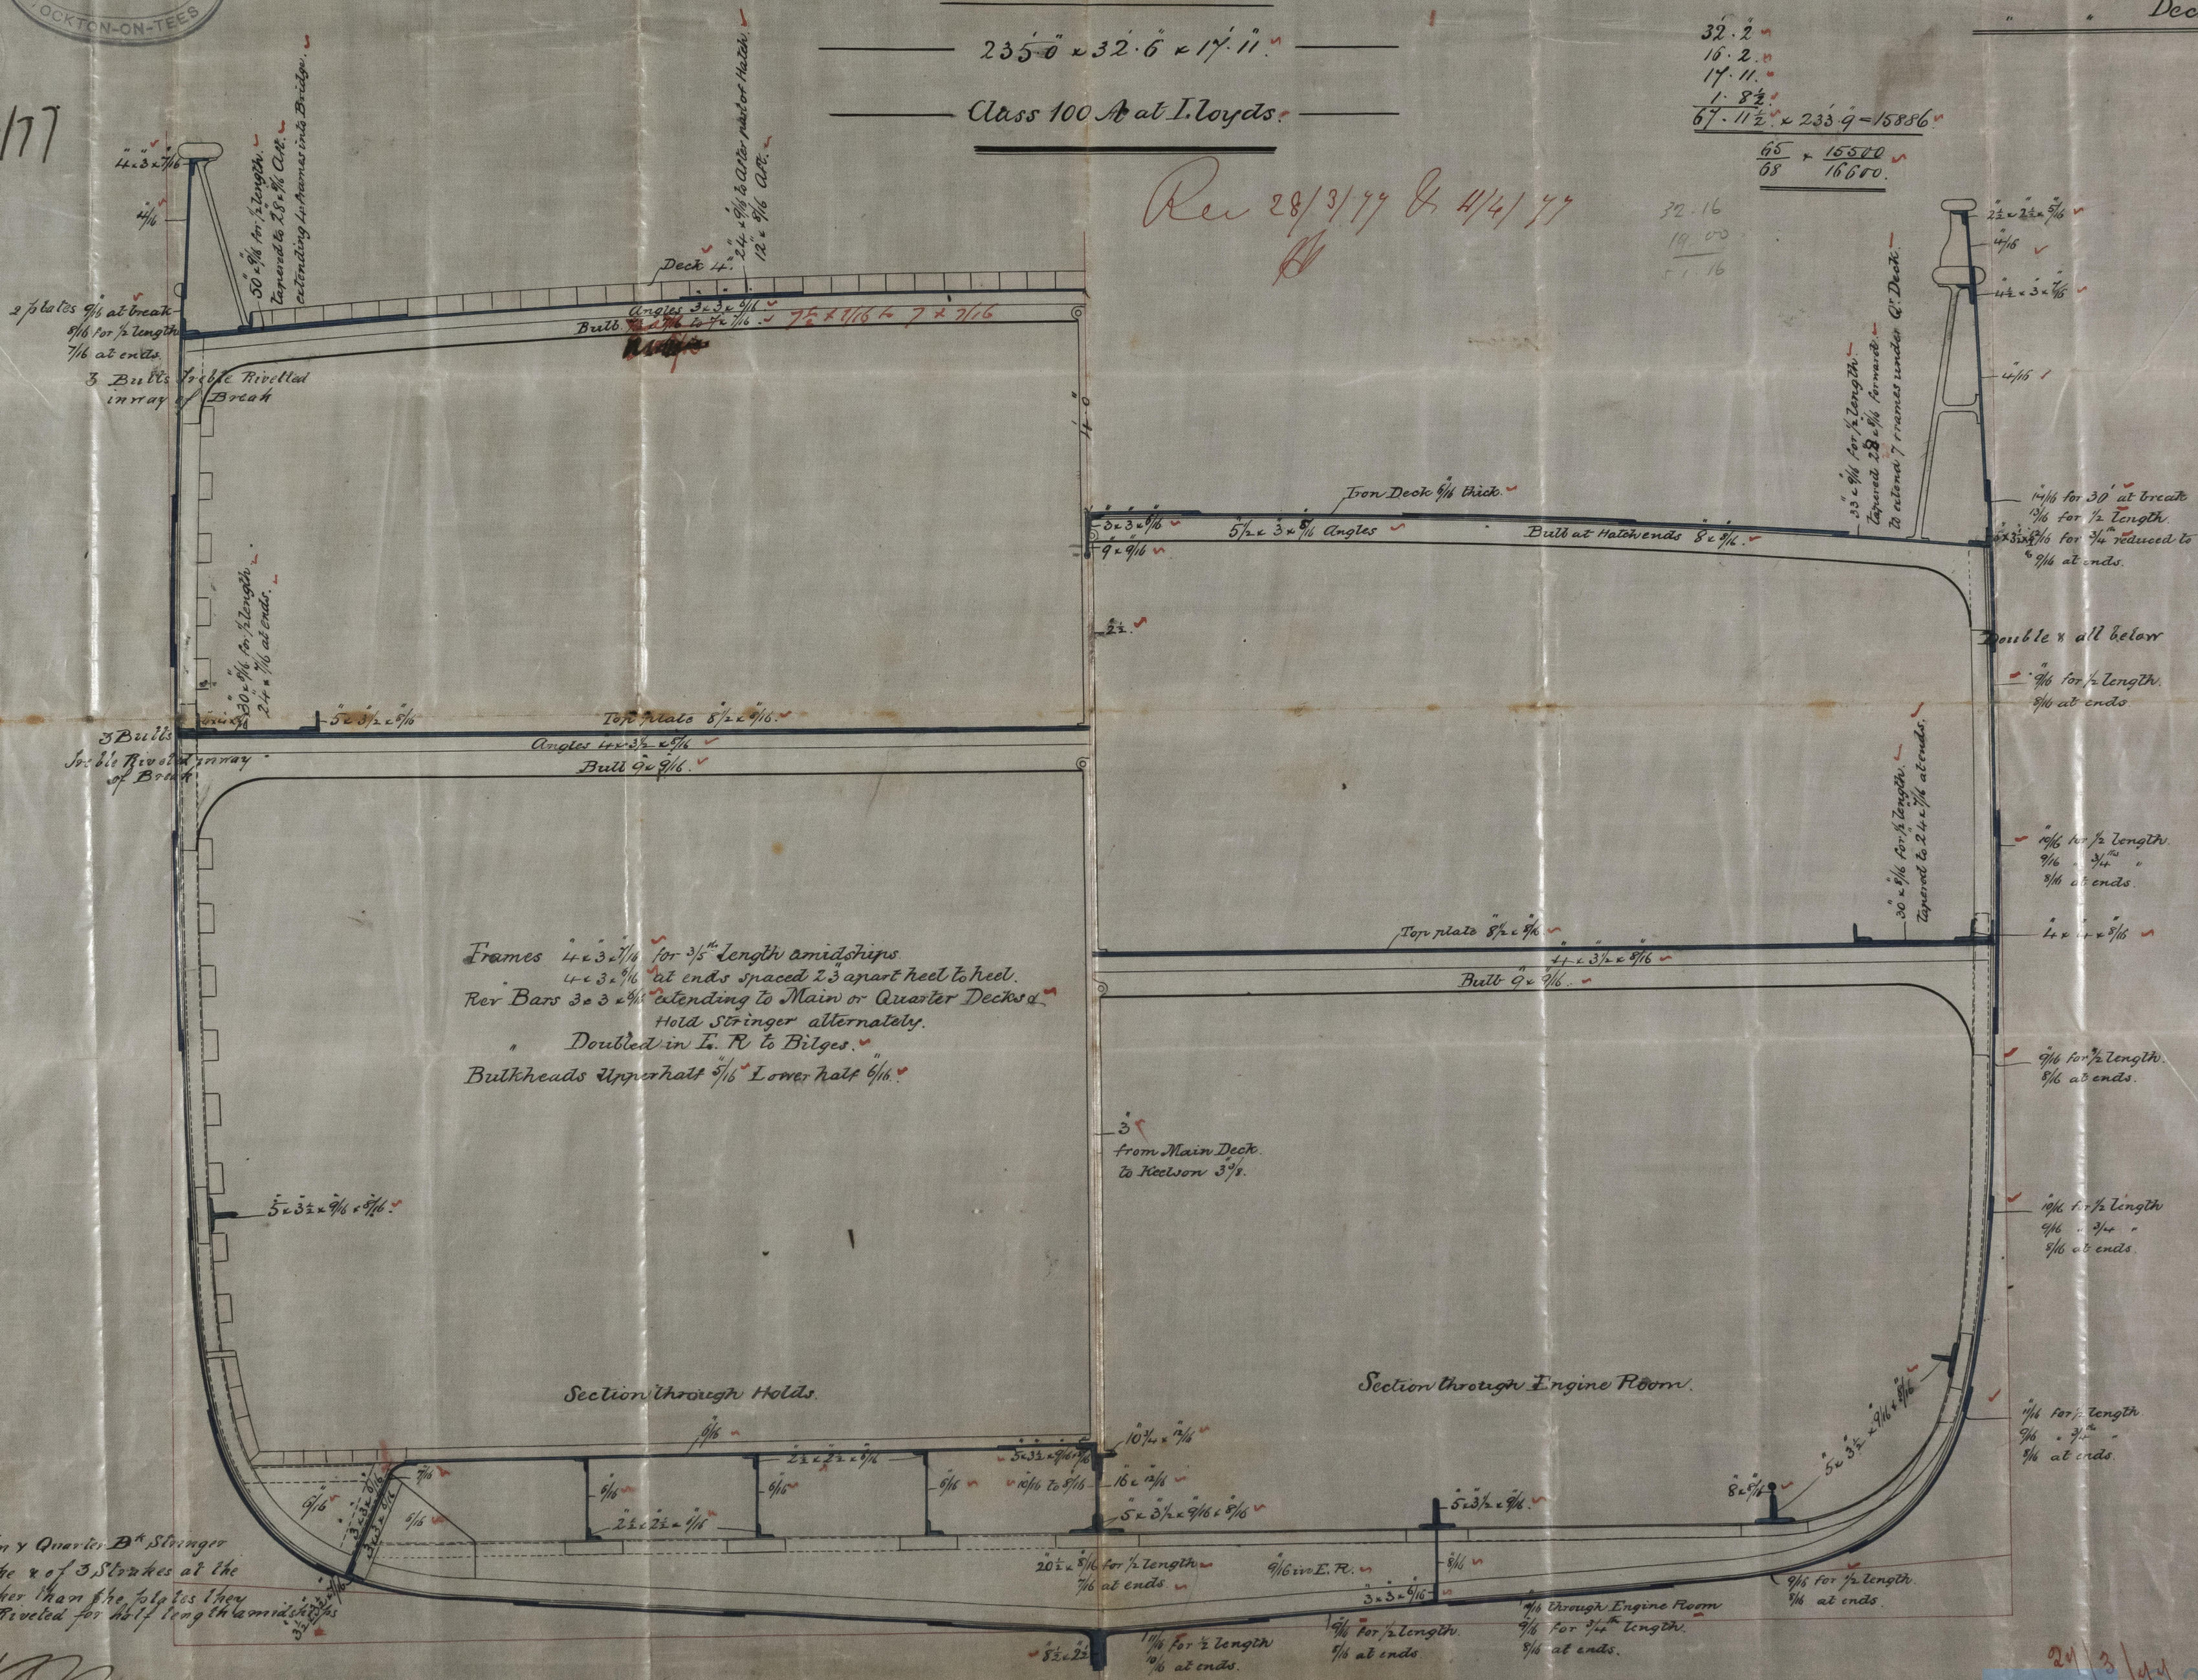

Built-up of Main & Quarter B<sup>d</sup> Stringer  
 plates Sheer Stroke & of 3 Strokes at the  
 Bilges to be thicker than the plates they  
 connect & stable riveted for half length amidships

1877  
 31/3/77

12/4/77


"Dalton"

MIDSHIP





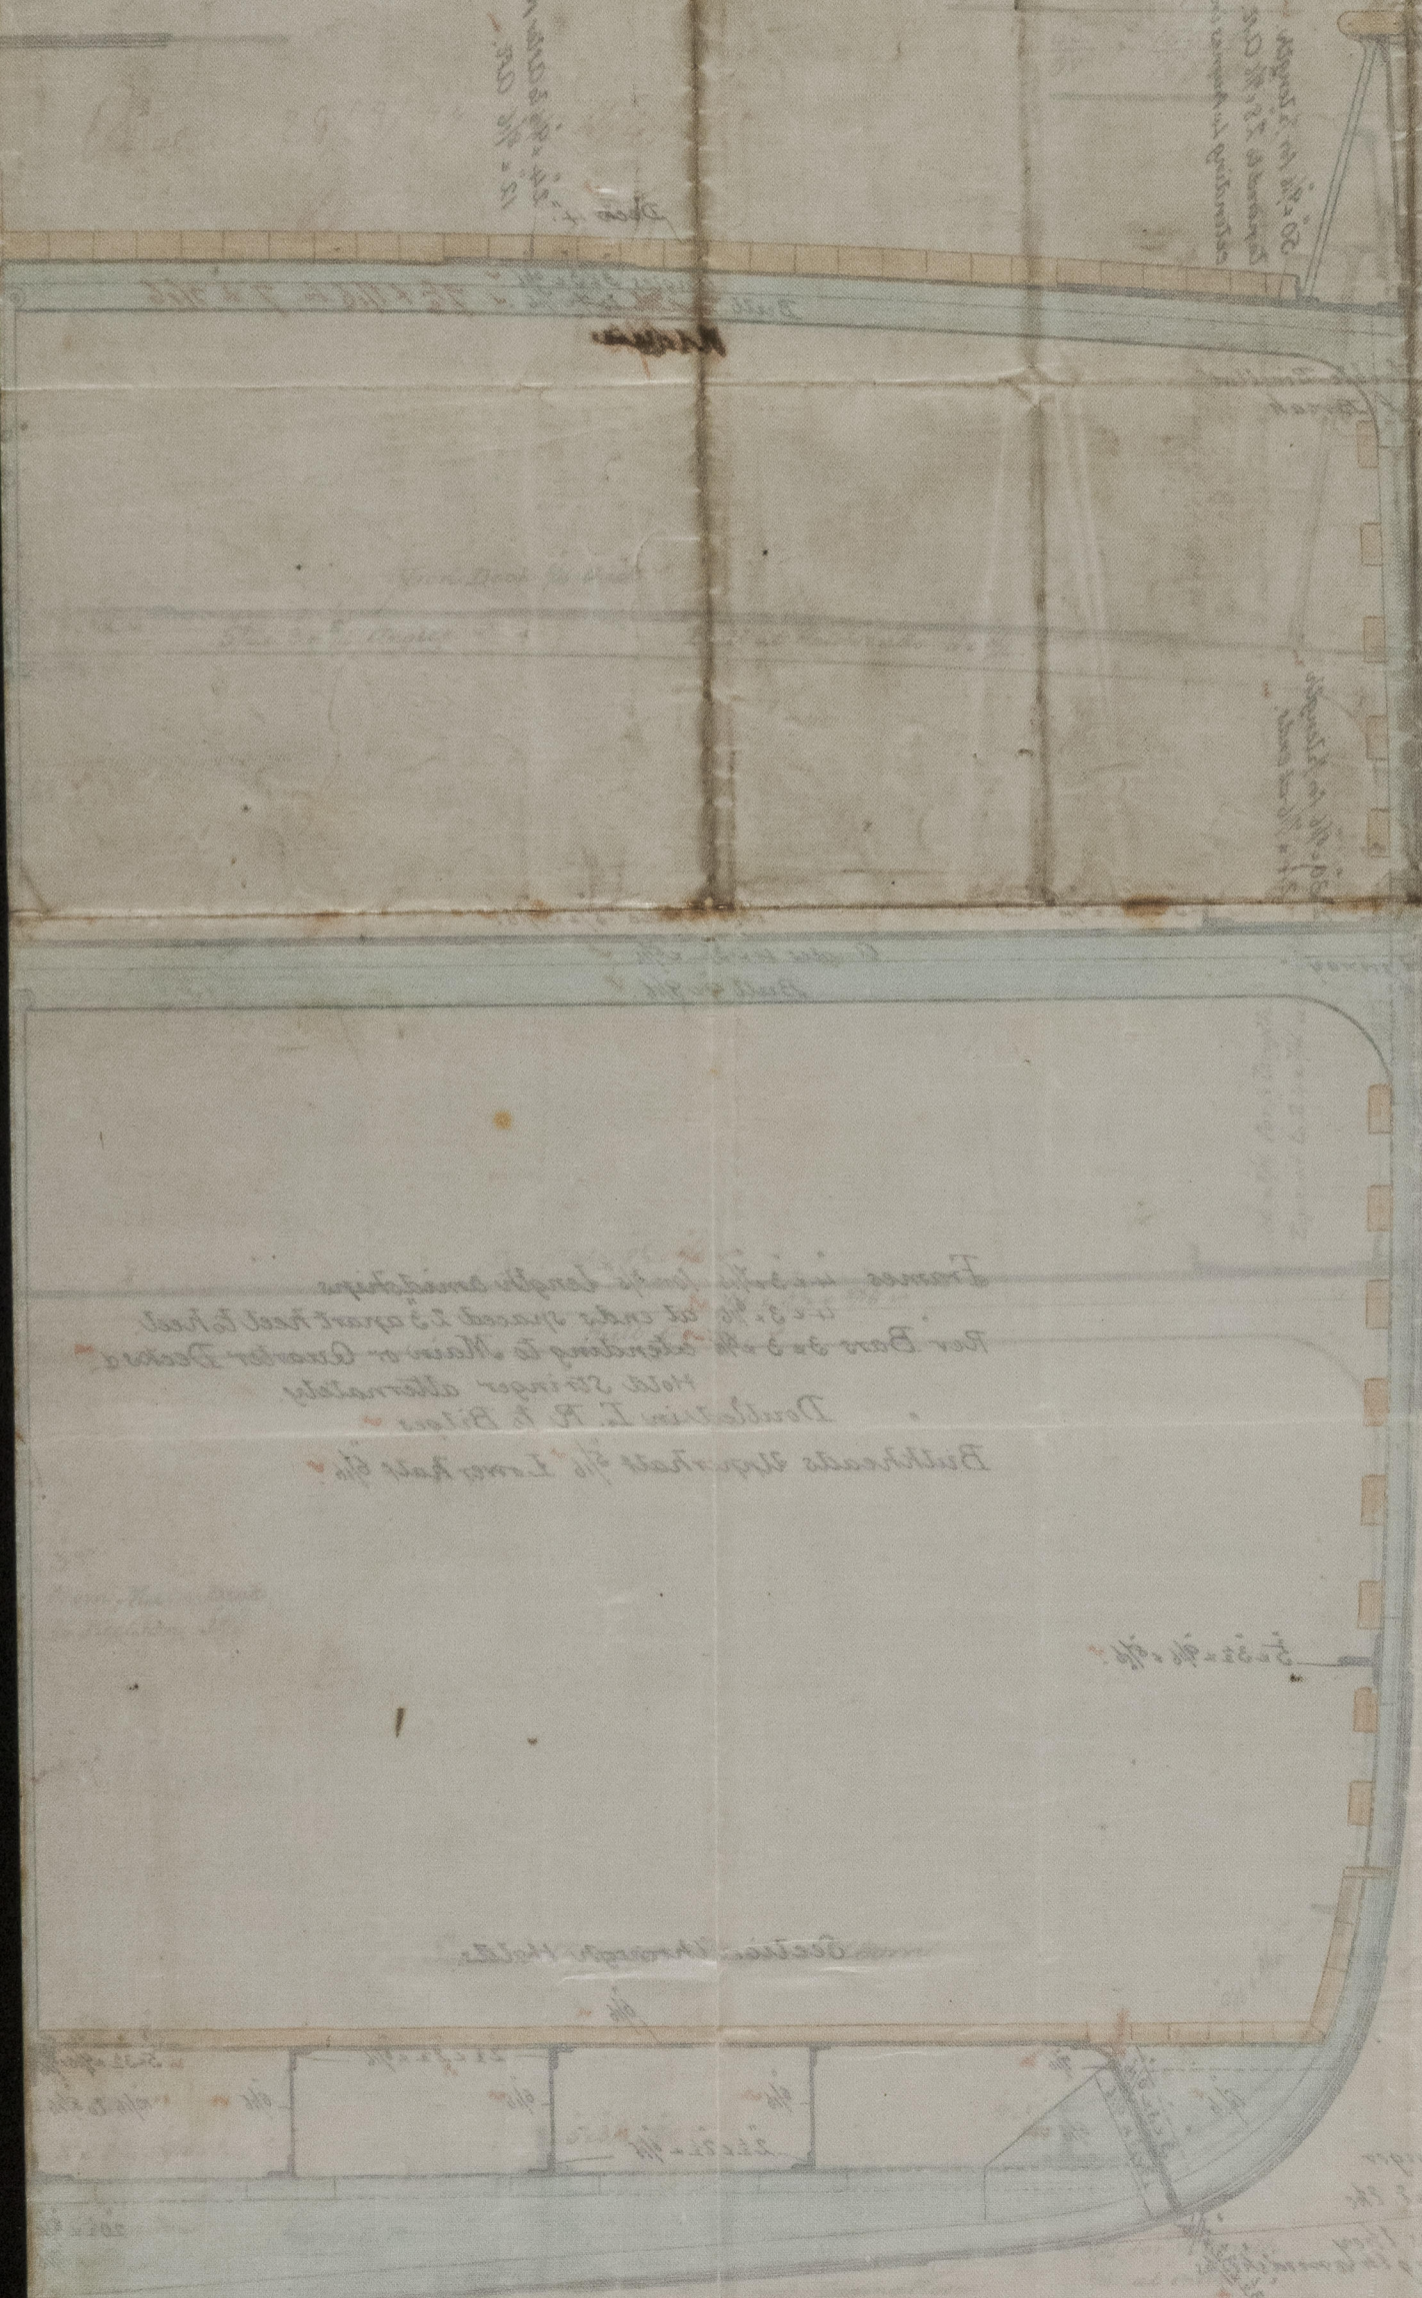




© 2021

Lloyd's Register  
Foundation