

Jenny Otto - Report no 12769.

26/2/77

No 101

MIDSHIP - SECTION

Scale $\frac{1}{2} = 1$ FT

To CLASS 100A AT LLOYDS

3 Deck rule Main Deck to be of iron
Water Ballast aft, & under Boilers & part Main Hold

LLOYDS NUMBERS

$\frac{1}{2}$ Breadth - - - - - 16.40
Depth - - - - - 24.75
 $\frac{1}{2}$ Girth - - - - - 36.75

Less


77.9
7.0

$70.9 \times 248.5 = 17643$

17618
25

10 Depths to Length
7.5 Breadths to Length
14 Depths to main D.K.

Rec 26/2/77
AA

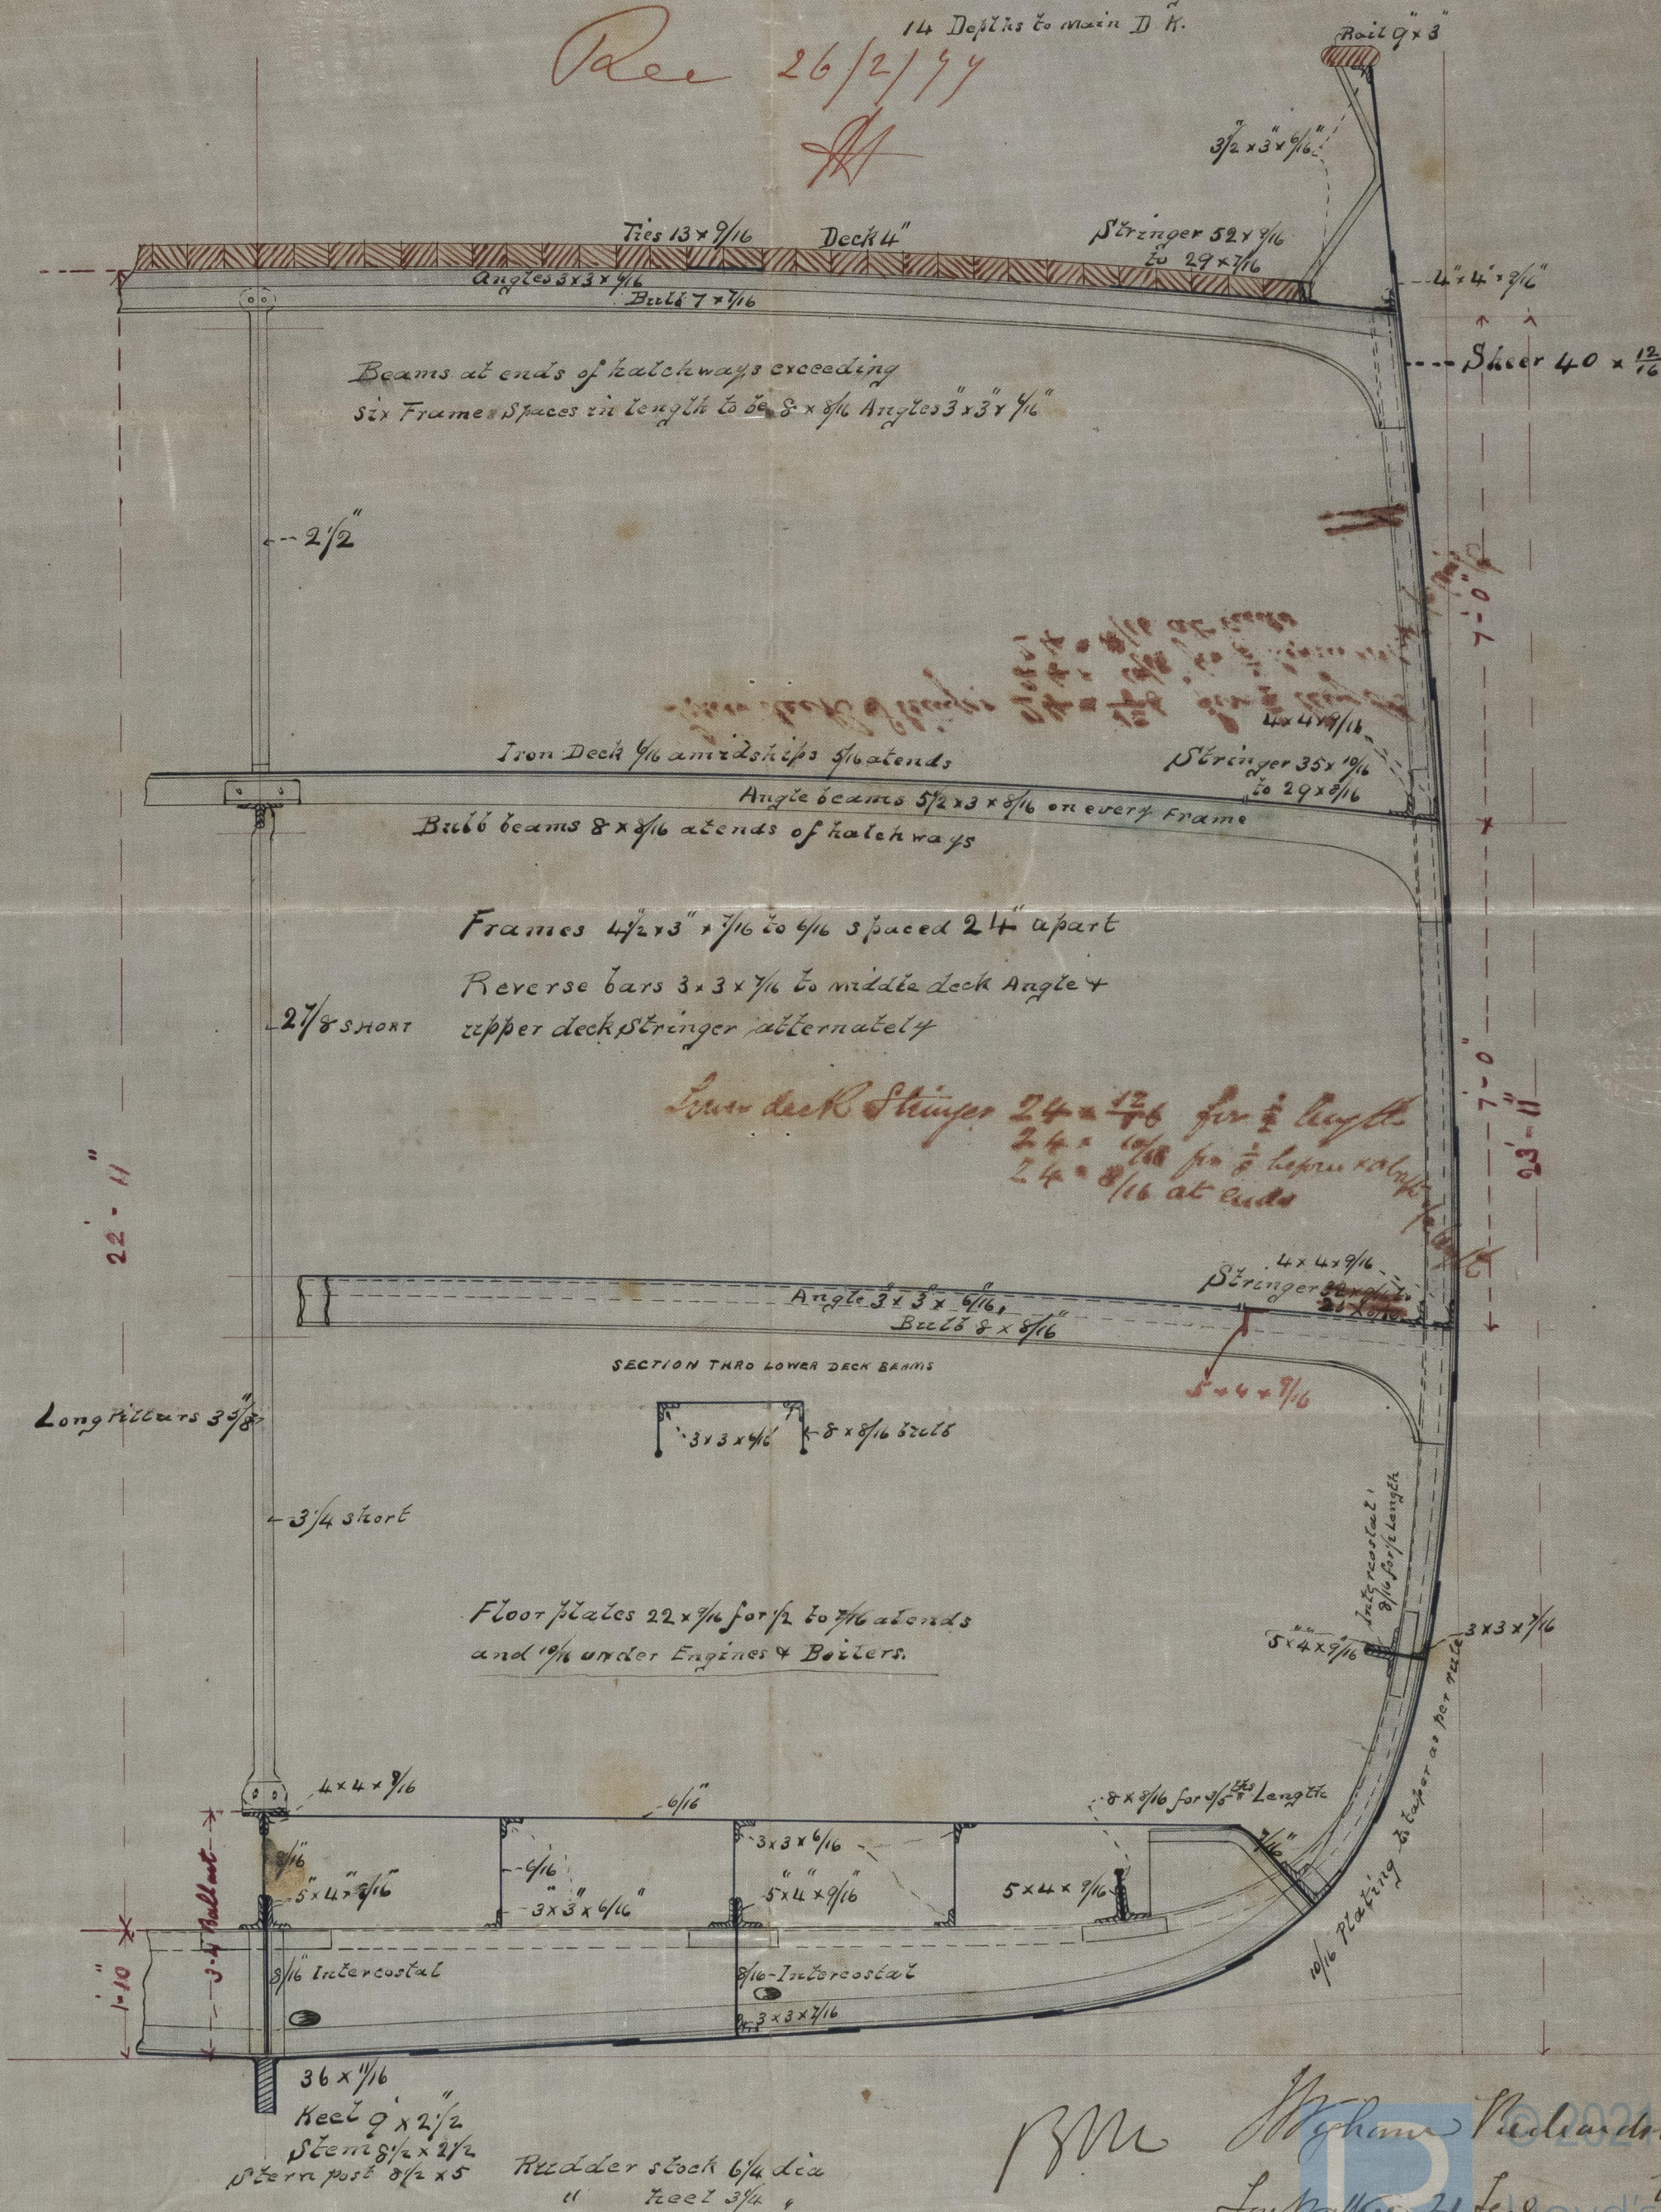

B.M.
26/2/77

Richardson
Lloyd's Register
Foundation

101


MIDSHIP - SECTION

Scale 1/2" = 1 ft

To CLASS 100A AT LLOYD'S


101

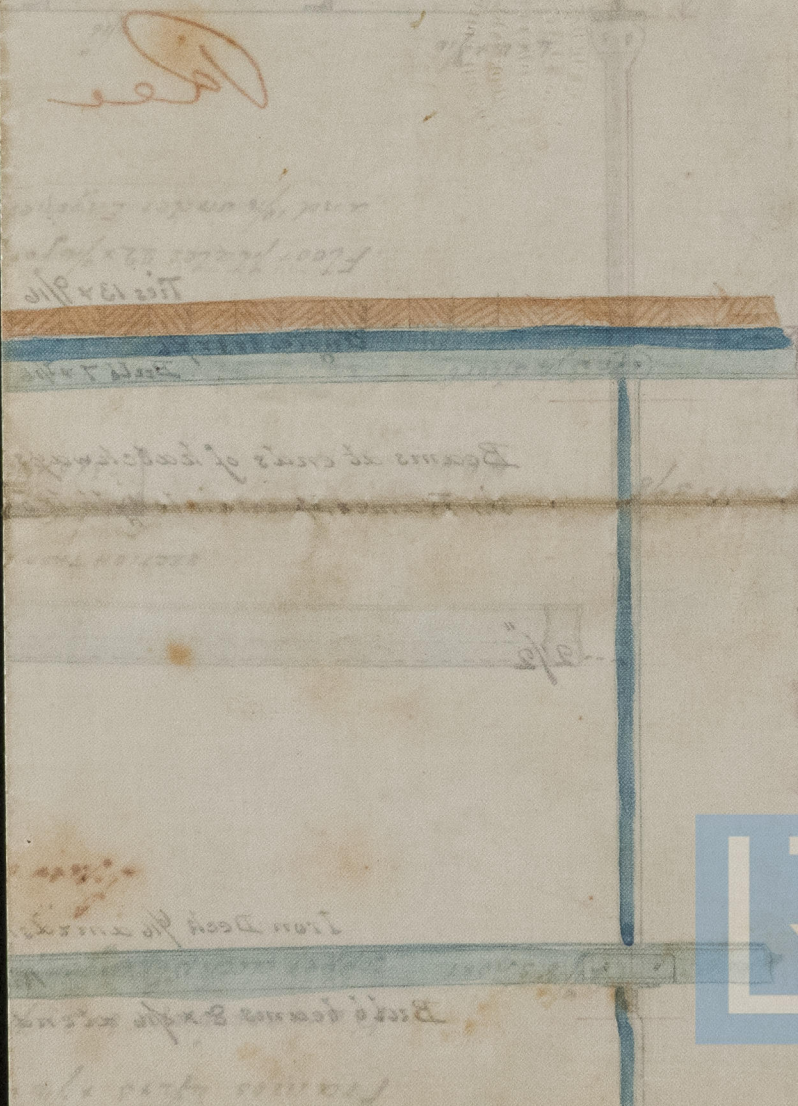

© 2021

Lloyd's Register
Foundation

180NS24-0084