


2/3/77


N<sup>o</sup> 100

# ELEVATION

SCALE  $\frac{1}{8}'' = 1 \text{ FT.}$

Recd 9/3/77  
H

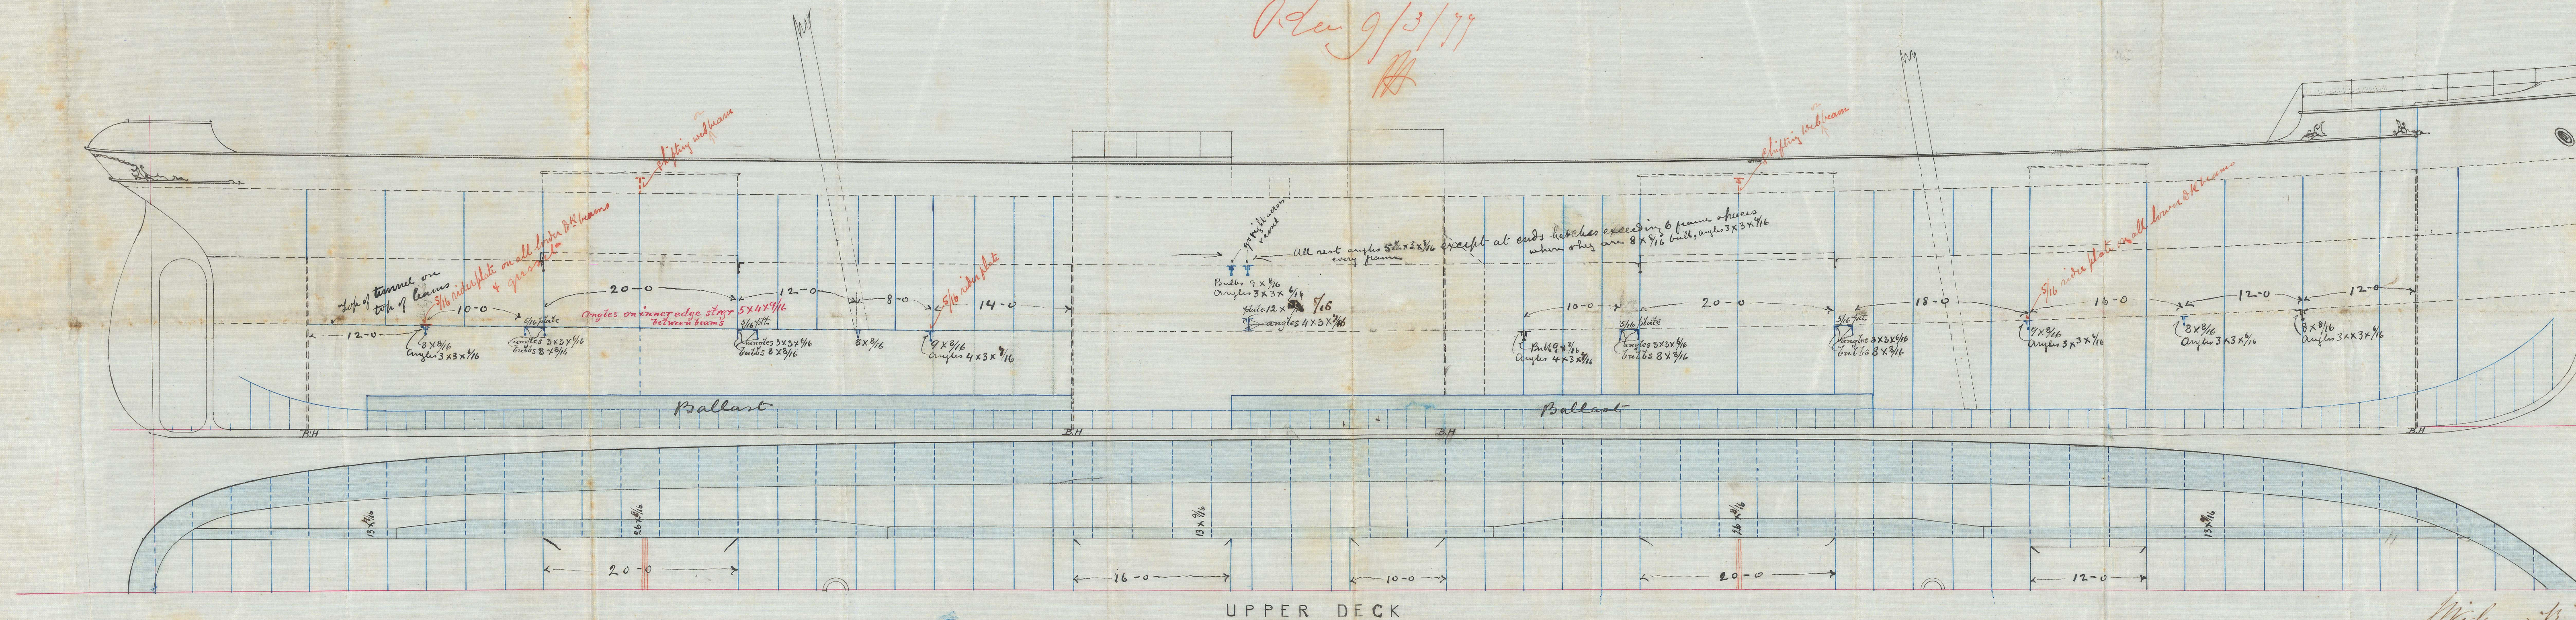


  
 1871  
 9/3/72  
 William Richardson of  
 © 2021

1822

9/3/77

© 2021

1877  
Lloyd's

## Foundation



1R0N524-0085

101



© 2021

Lloyd's Register  
Foundation