


S.S. No 347

Scale 1/2" to 1 foot *Rev 2/2/77*

Dec: 19th 1876

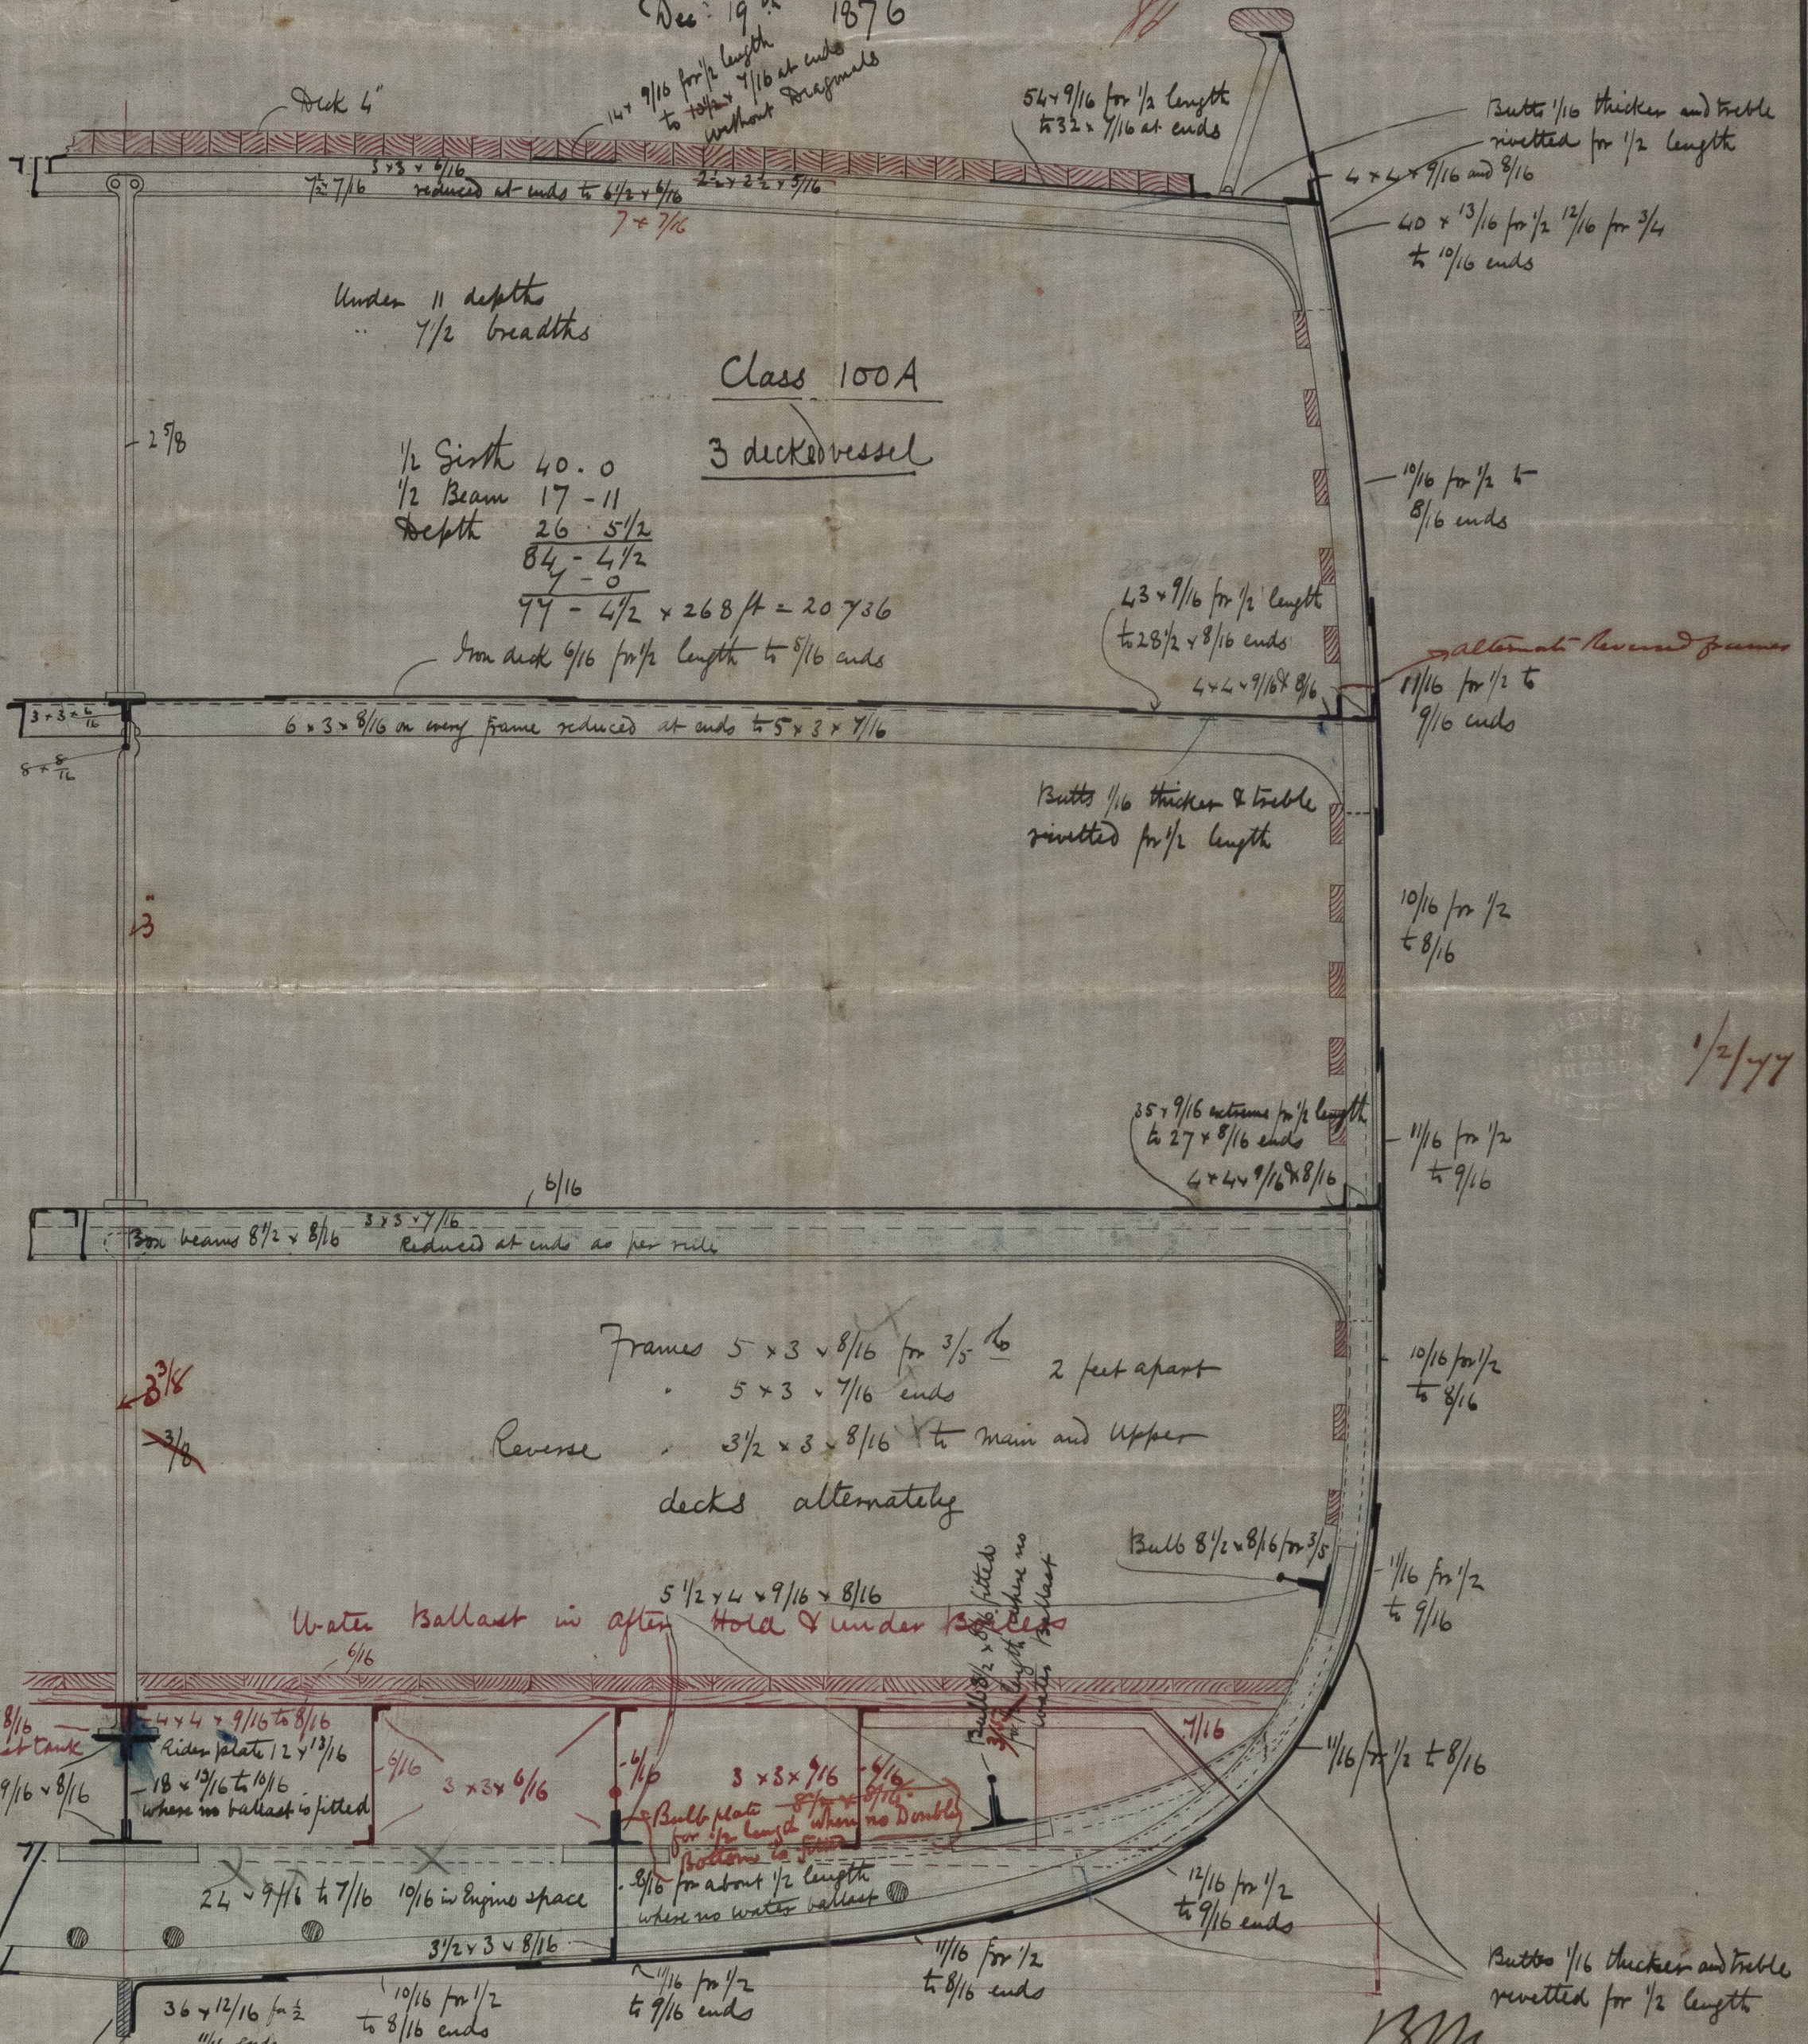

Keel 9 1/2 x 2 1/2
Stempost 9 x 5
Rudder stock 6 3/4
Pinches 3 1/2

Plates in way of Ballast Tank to be reduced 1/16 in thickness

