

Iron Barque Lizzie Bell Report No 11.818

Red-14
16/7/77
L

No 86

FOREMAST 77'-6"

2 LOWER YARDS 74'-0"



BOWSPRIT

MAINMAST 79'-6"

2 LOWER TOPSAIL YARDS 62'-0"

21'-6" outside of Bed

Rec 16/7/77

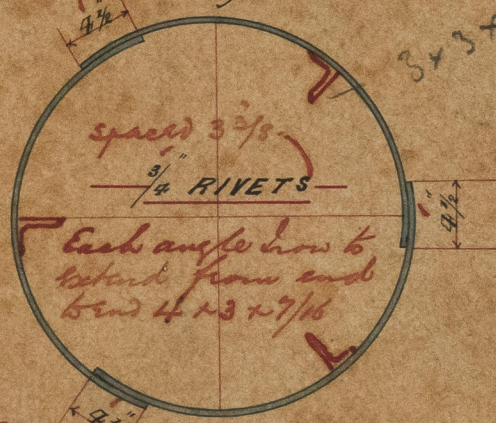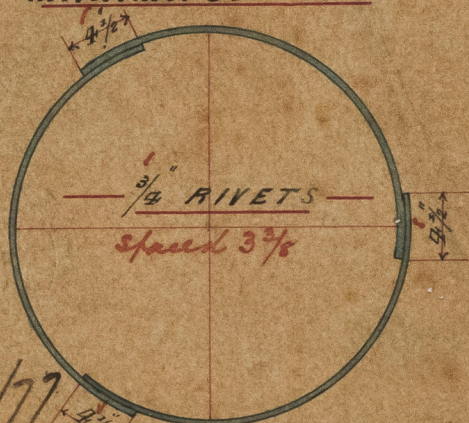

SCALE 1 inch = 1 FOOT

	PARTNERS		HEEL		HOUNDS		HEAD		CHEEKS	
FOREMAST	27"	7/16	19 1/2"	6/16	21"	6/16	17 1/2"	6/16	9/16	
MAINMAST	28"	7/16	20"	6/16	22"	6/16	18"	6/16	9/16	
	CENTRE		1 ST QUARTER		2 ND QUARTER		3 RD QUARTER		ENDS	
2 LOWER YARDS	18"	5/16	17 1/2"	3/16	16 1/2"	5/16	15 1/2"	3/16	9 1/2"	3/16
2 LOWER TOPSAIL YARDS	15"	3/16	14 5/8"	3/16	13 1/2"	3/16	11 3/4"	3/16	7 1/2"	3/16
			BED		HEEL		CAP			
BOWSPRIT			27"	3/16	22"	6/16	17 1/2"	6/16		

ROBERT THOMPSON, JR.
SOUTHVIEW LANE,
SUNDERLAND

Lloyd's Register
Foundation
16/7/77

2010-4524091

IRON 524-0105