

Recd 23/4/77


24/4/97

ROBERT THOMPSON, JUN.
Iron and Gunpowder Shipbuilders,
SOUTHWICK YARD,
SUNDERLAND.

Length B.P.	208.0
Beam extreme	34.4
Depth in hold to floors . .	21.5½

Class 100 A.

Scale $\frac{7}{2} = 1$ foot.

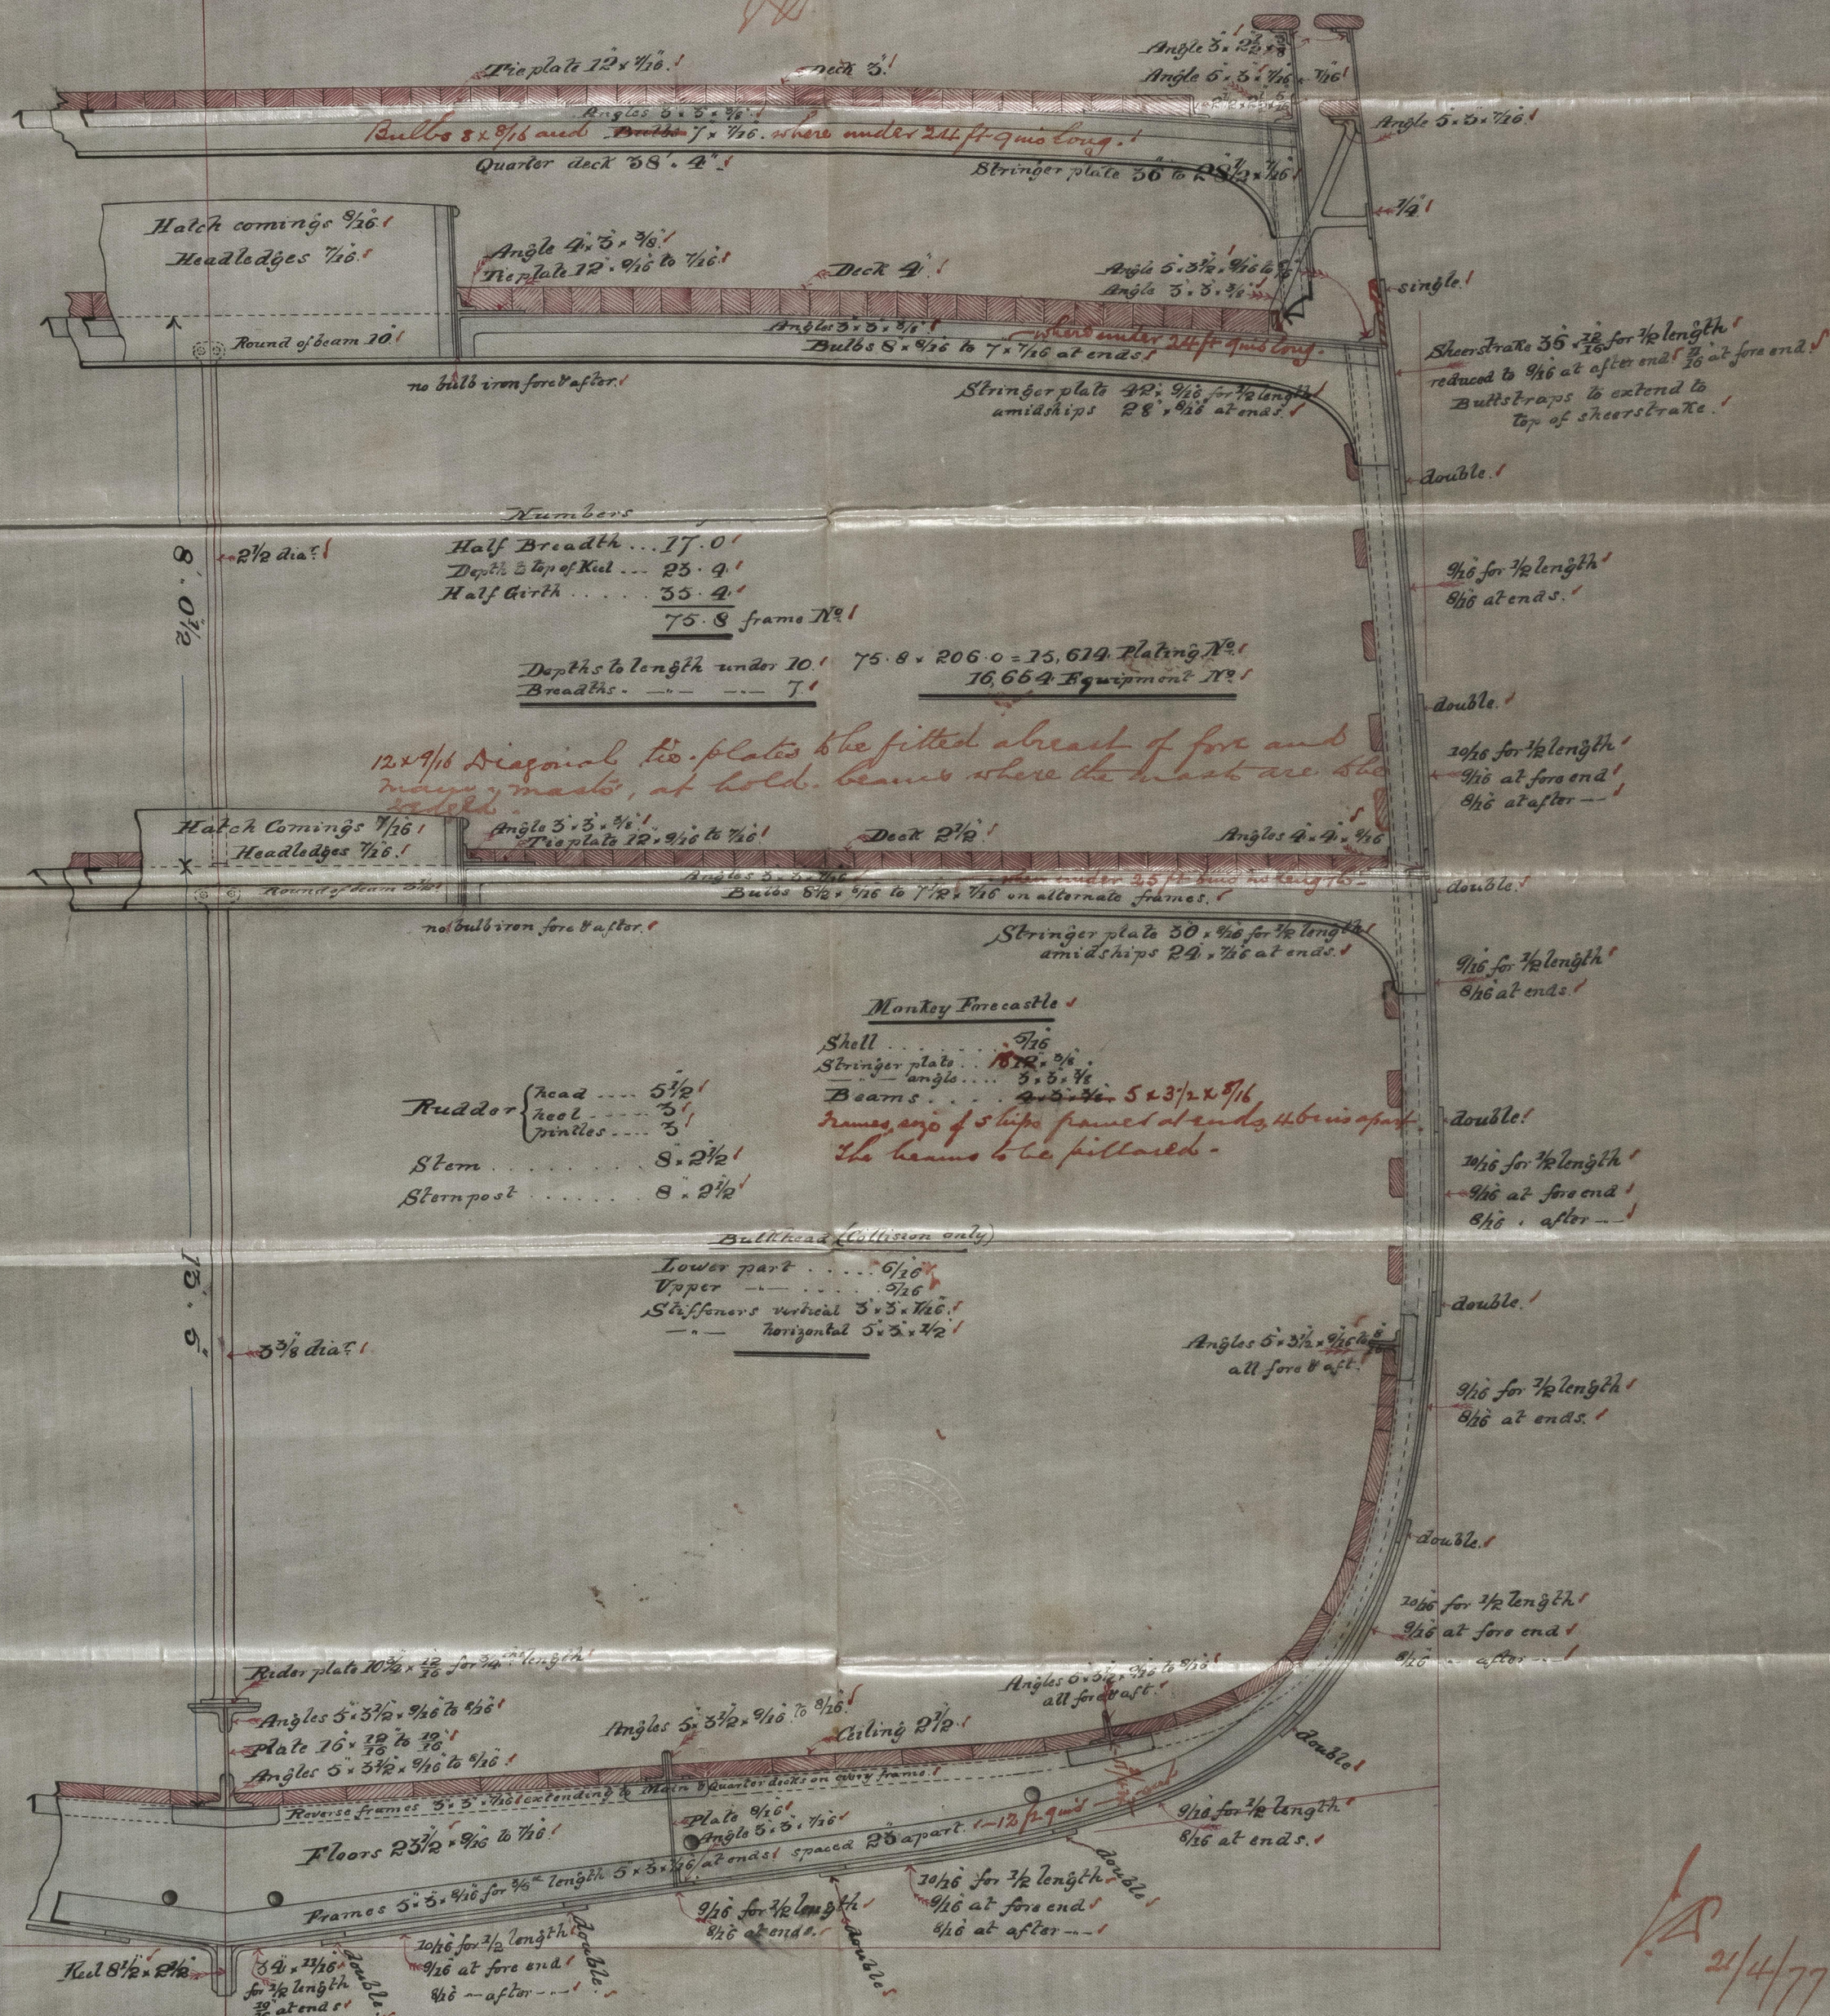

Bulls traps of Main deck stringer plate, sheers trunks
and of three strakes of plating at the bilge
to be $\frac{1}{16}$ thicker than the plates they
connect & treble riveted for half length
amidships. ✓

21/4/77

23/4/77