


2/6/77

S.S. H^{103} 11 x 12. S.S. "OTTER"

Scale $\frac{1}{4}$ " = 1 foot
Rev 85/6/77

Glasgow Report No. 4569

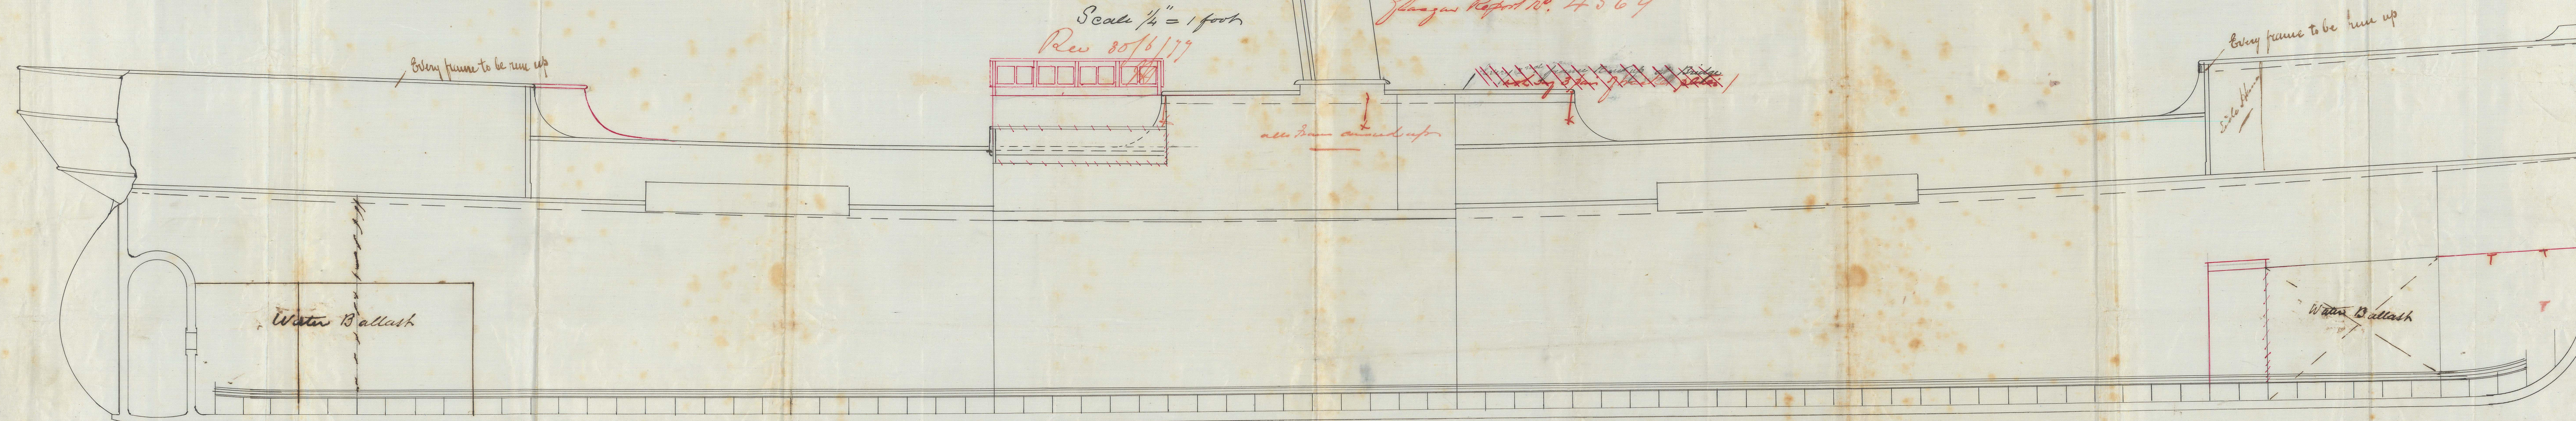

H. MCINTYRE & CO.,
Iron Shipbuilders,
PAISLEY.

28/6/77

18/7/77
© 2021
Lloyd's Register
Foundation

180524-0120