


Nº 176 S S

	<u>Warblers.</u>	<u>Flores.</u>
Length between Tars. -----	241. 0	Length 239
Breadth Extreme. -----	33. 0	1/2 breadth 16
Breadth moulded. -----	32. 10	Girth ----- 32.
Depth of Hota. -----	18. 3	Depth ----- 20
Classed 100A at Lloyd's.		
11 x under 12 Depths. ✓	ms for Games	69. 2
7 x under 8 Breadths. ✓	" " Rating	165. 8
	" " Equipment	

Rec 11/5799
A

 

IRON 524 - 0121 $\frac{1}{2}$

IRON 524-0121²/₂

W. GRAY & CO.
IRON SHIPBUILDERS

REPAIRERS,
Lloyd's Register
Foundation