

Midship Section of S.S. 88


Scale 2" = 1'

By Messrs. Thos. Turnbull & Son

Whitby

S.S. "Bedmon"
Report No. 3917

Rev 7/3/77
A

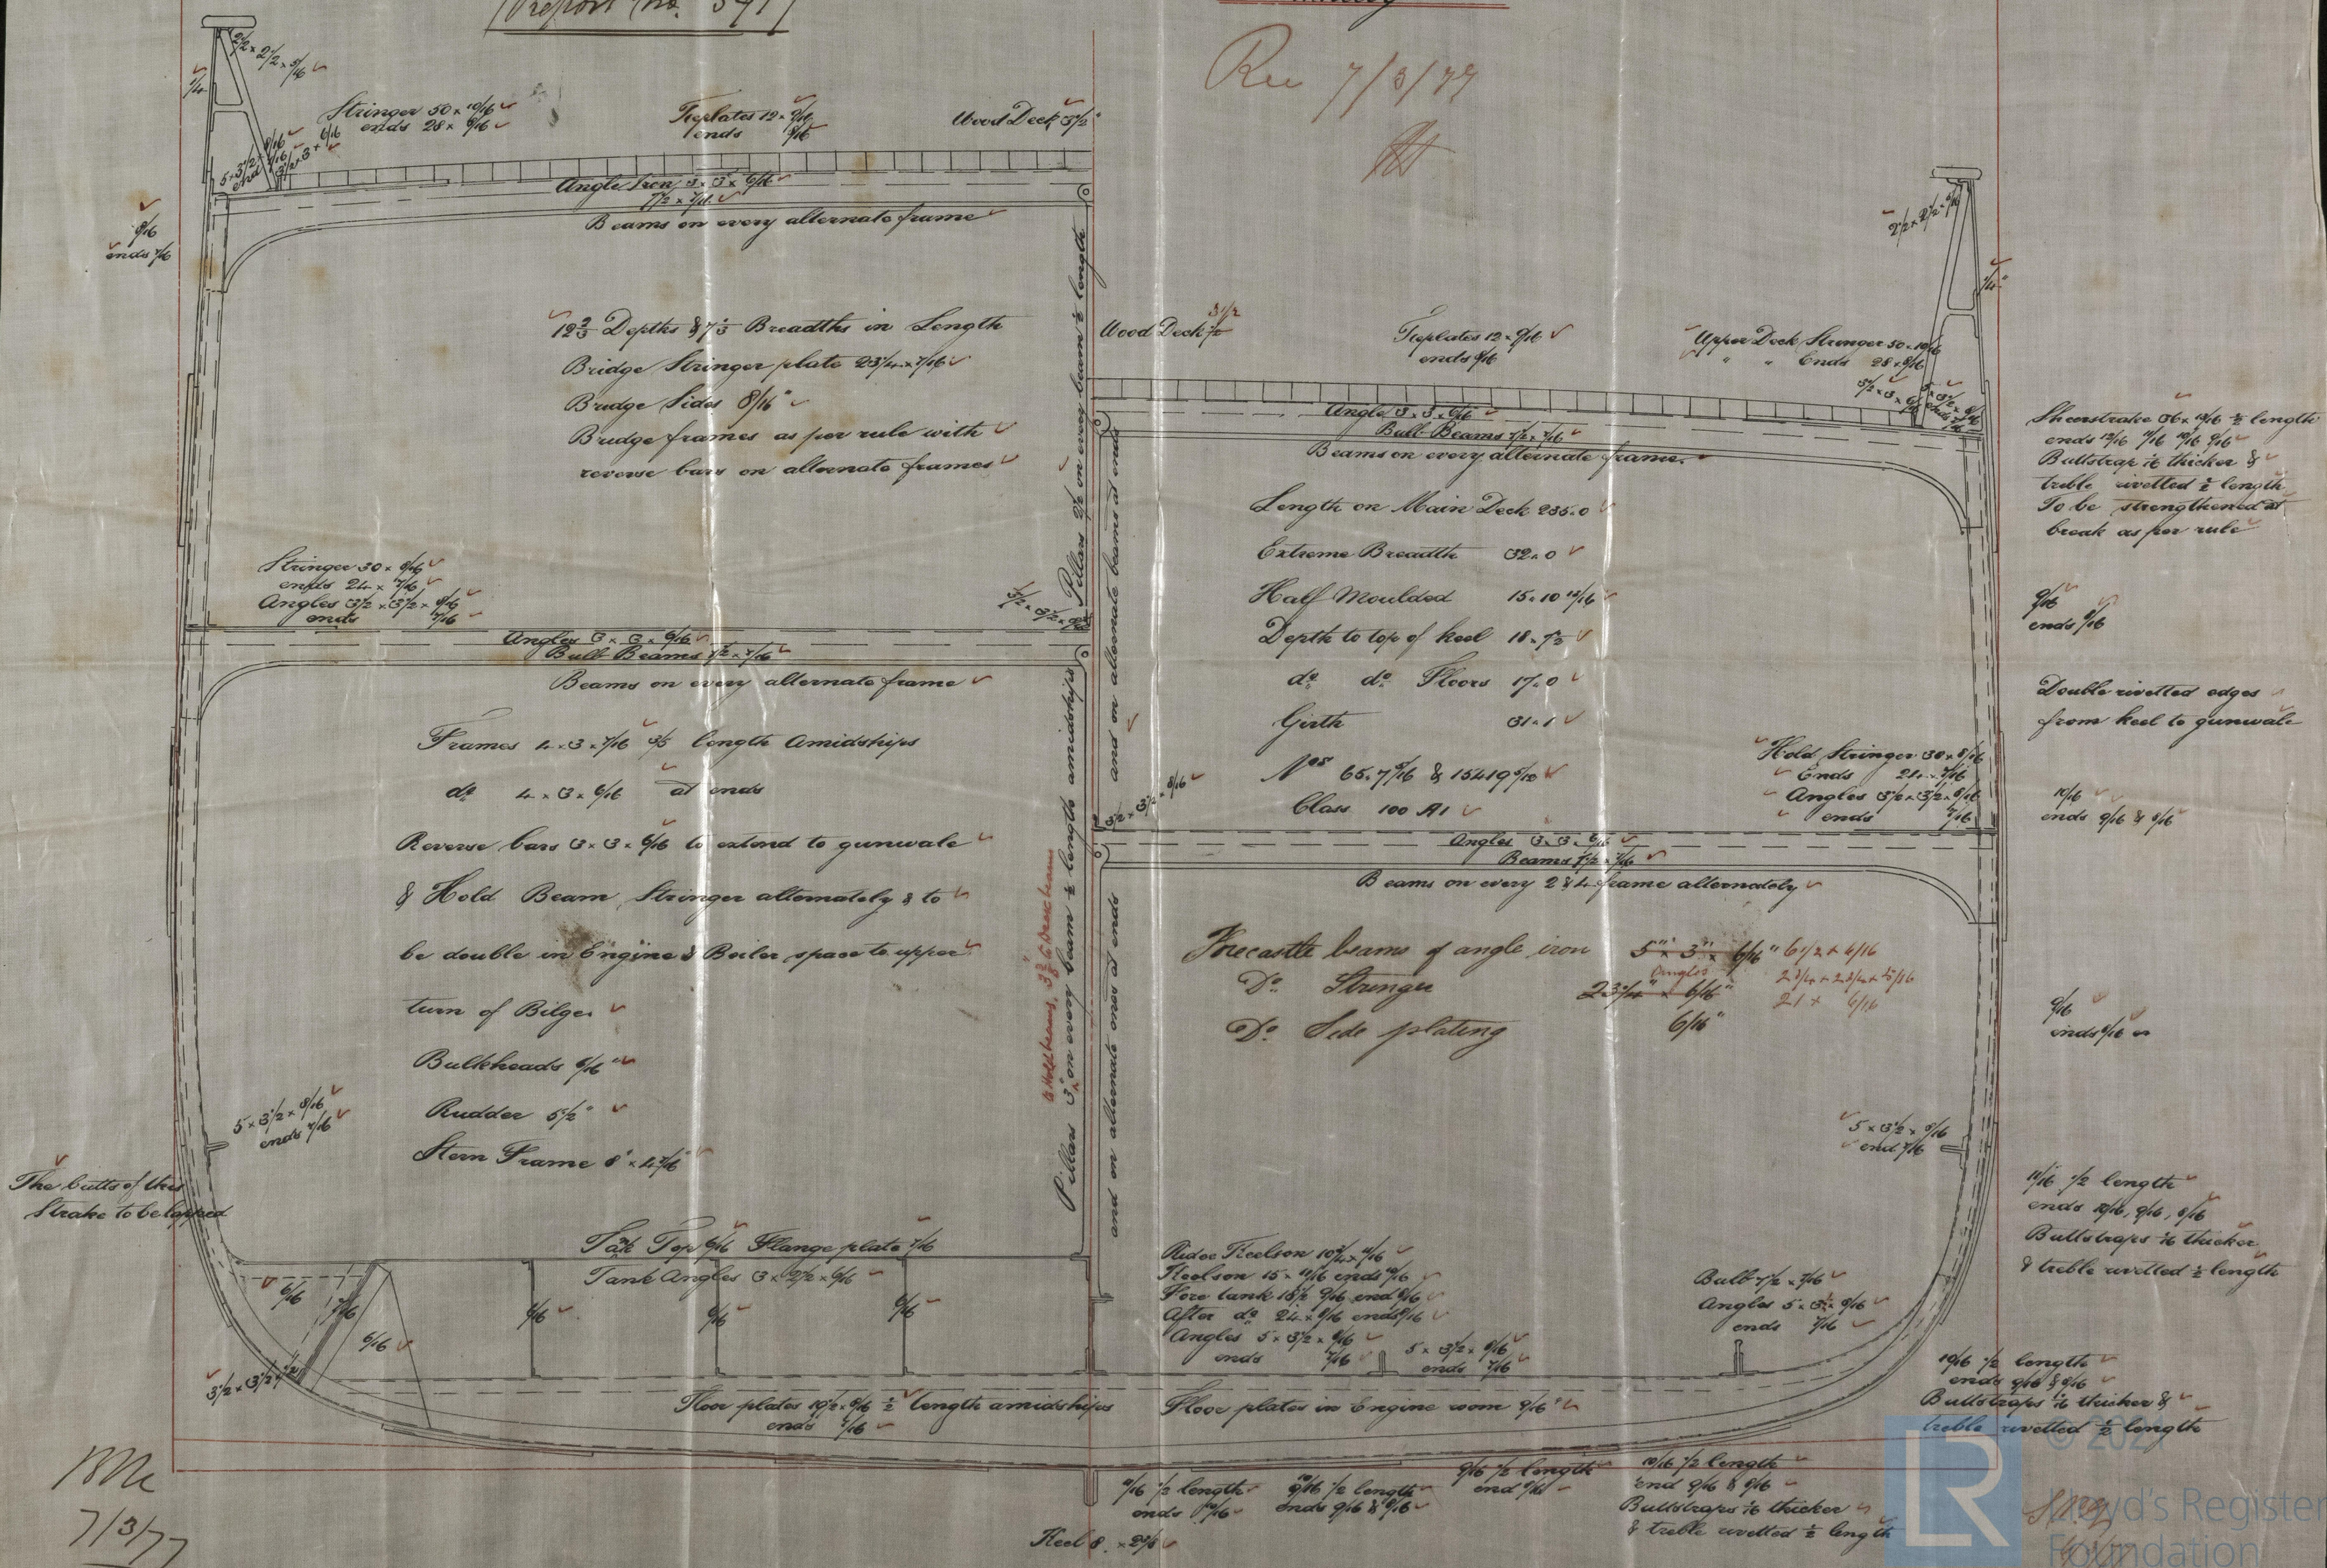

Ma
7/3/77