

12/12

MIDSHIP SECTION

S.S. N° 208


DIMENSIONS

LENGTH TWIXT PERPENDICULARS	220.0	LENGTH PER RULE	218.67
BREADTH MOULDED	31.0	BREADTH D° D°	31.0
DEPTH IN HOLD TO MAIN DECK	14.0	DEPTH D° D°	15.62
D° AWNING DECK	21.0	DEPTHS TO LENGTH	13.9


NUMBERS FOR SCANTLING 15.5 + 15.62 + 26.83 = 57.95 218.67 + 12671 + 2111.8 = 14782 = NUMBERS FOR EQUIPMENT.

GRADE 90 A.I.

Rec 29/1/17

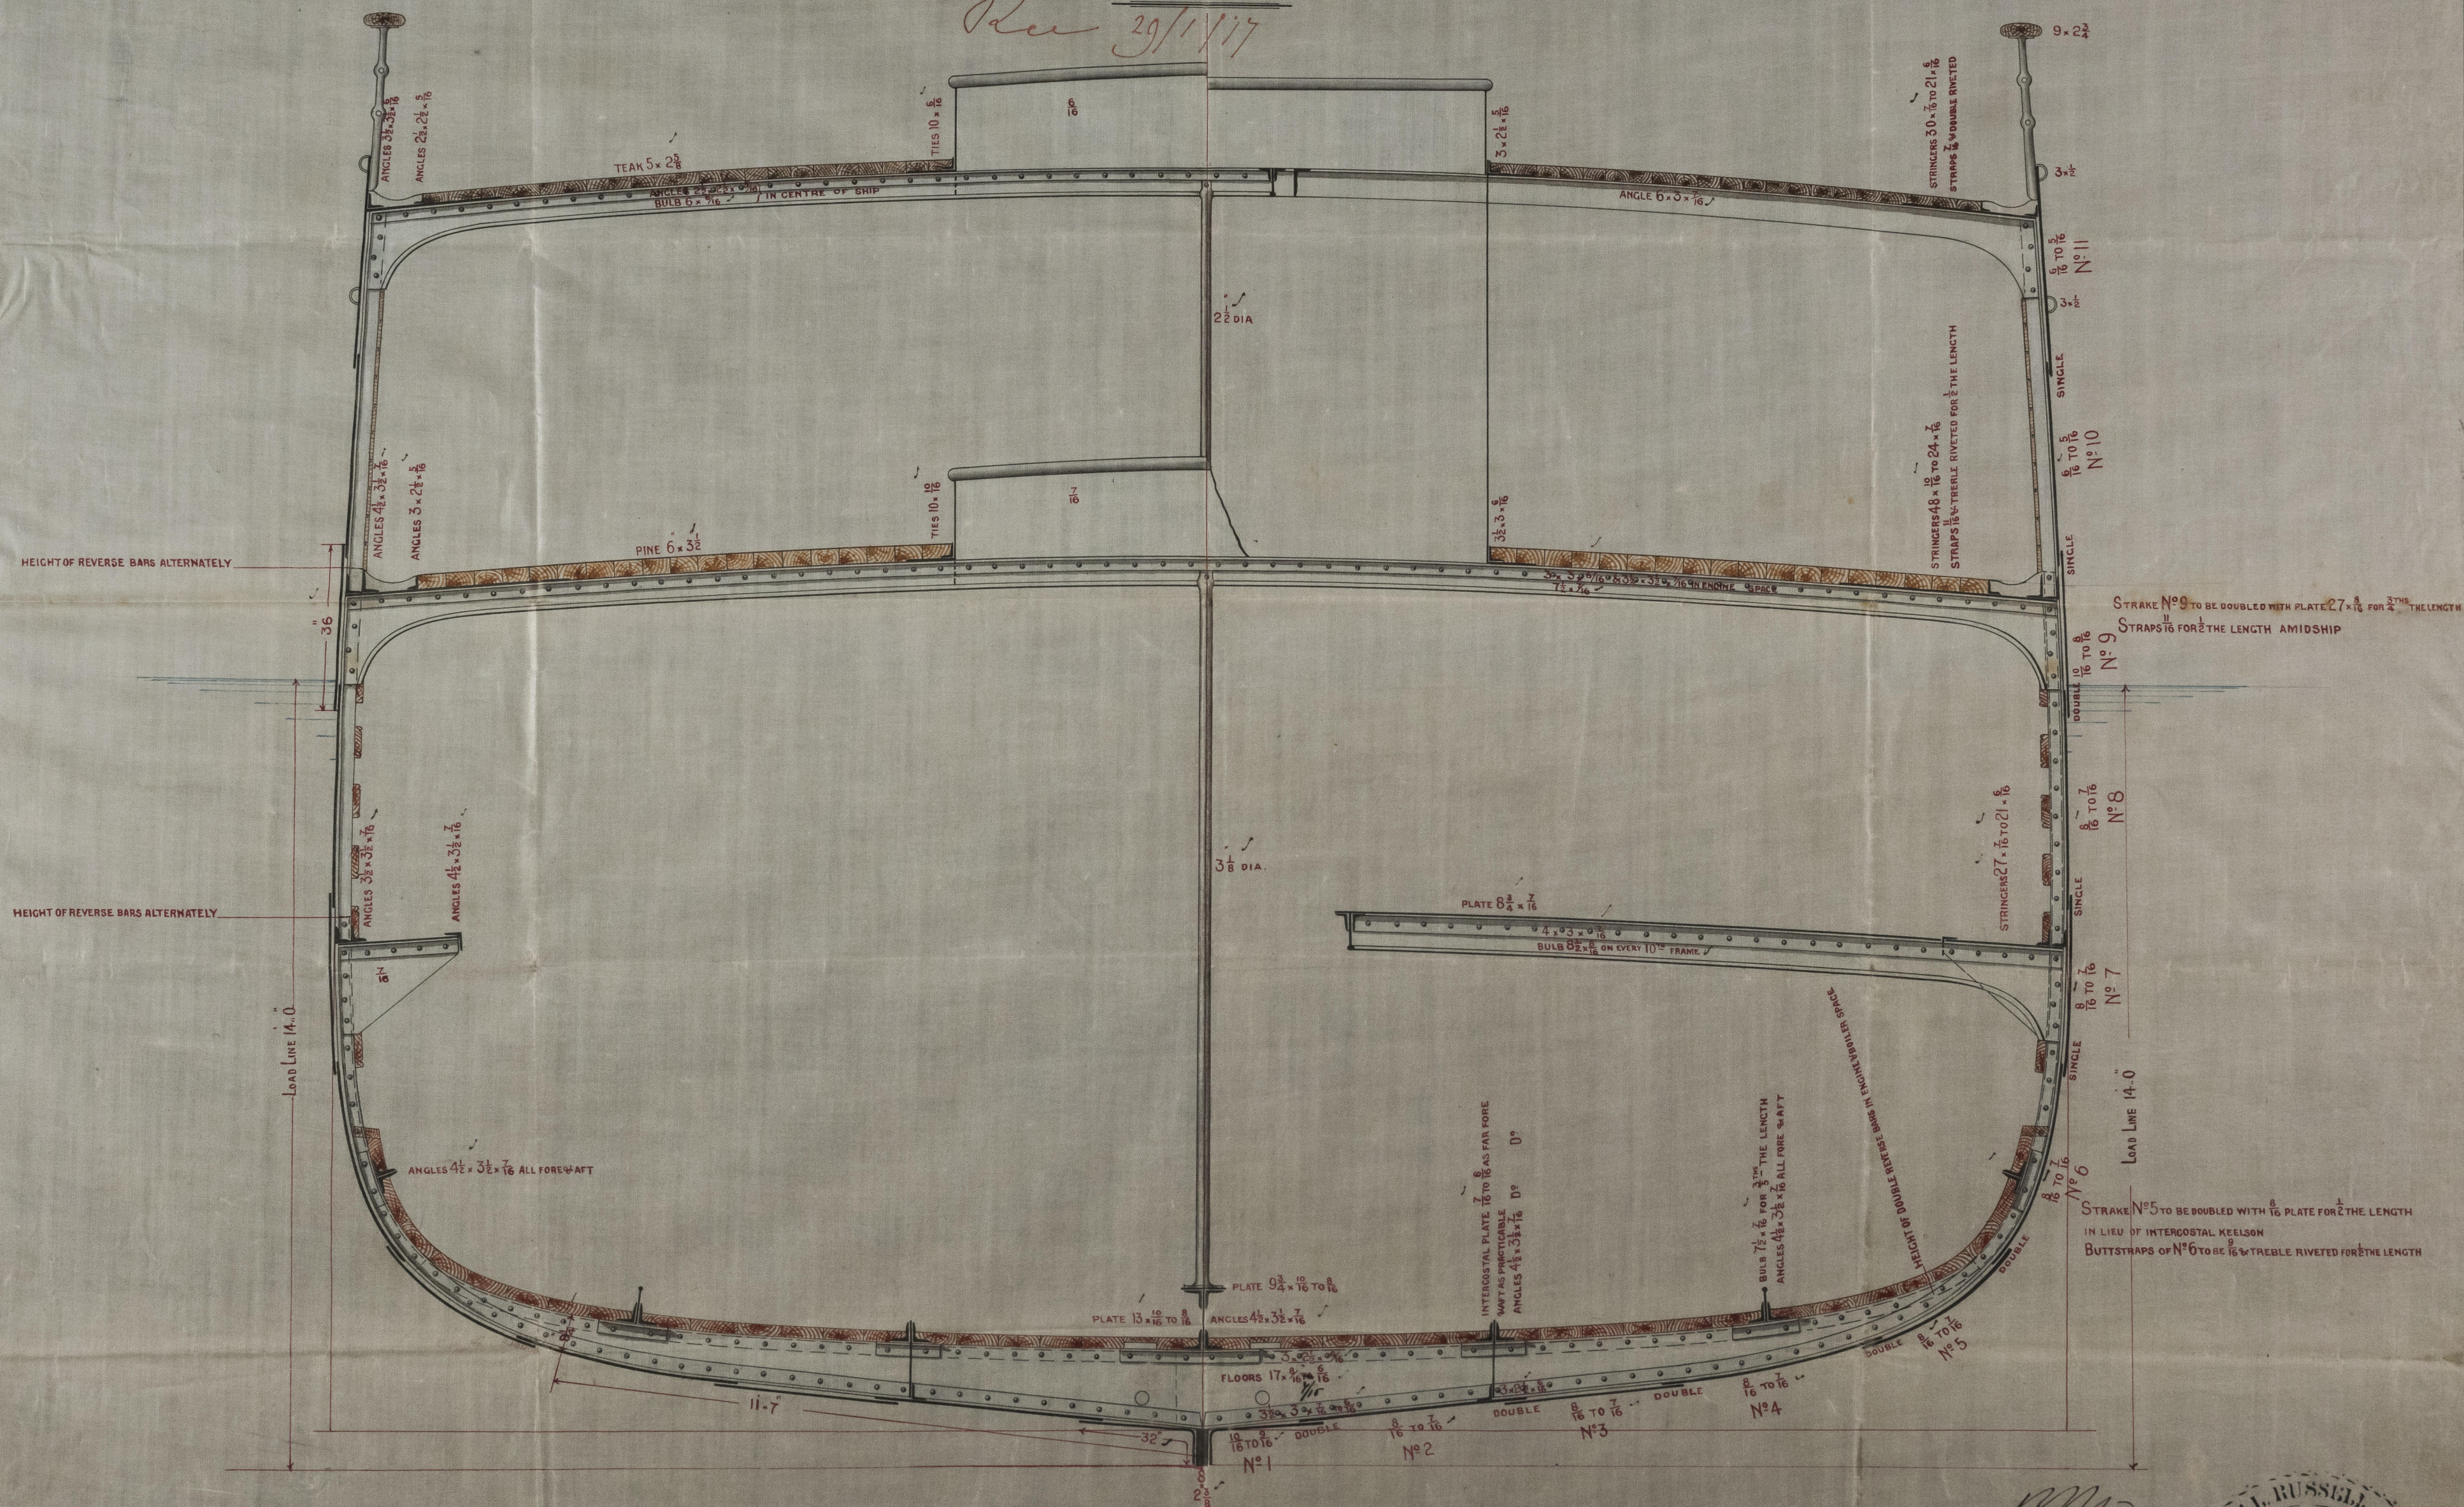

SCALE 1/2 INCH TO ONE FOOT

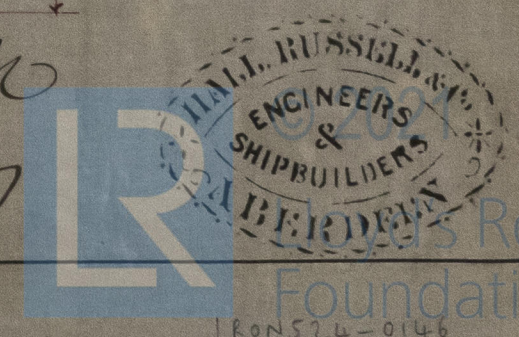

Register Foundation
180524-0146