


12/2/77

PROFILE N^o 215 - BARQUE "MABEL YOUNG"

Scale $\frac{1}{4}$ Inch to 1 Foot

Glasgow Report No 4560

Per 10/2/77 & 14/2/77
H

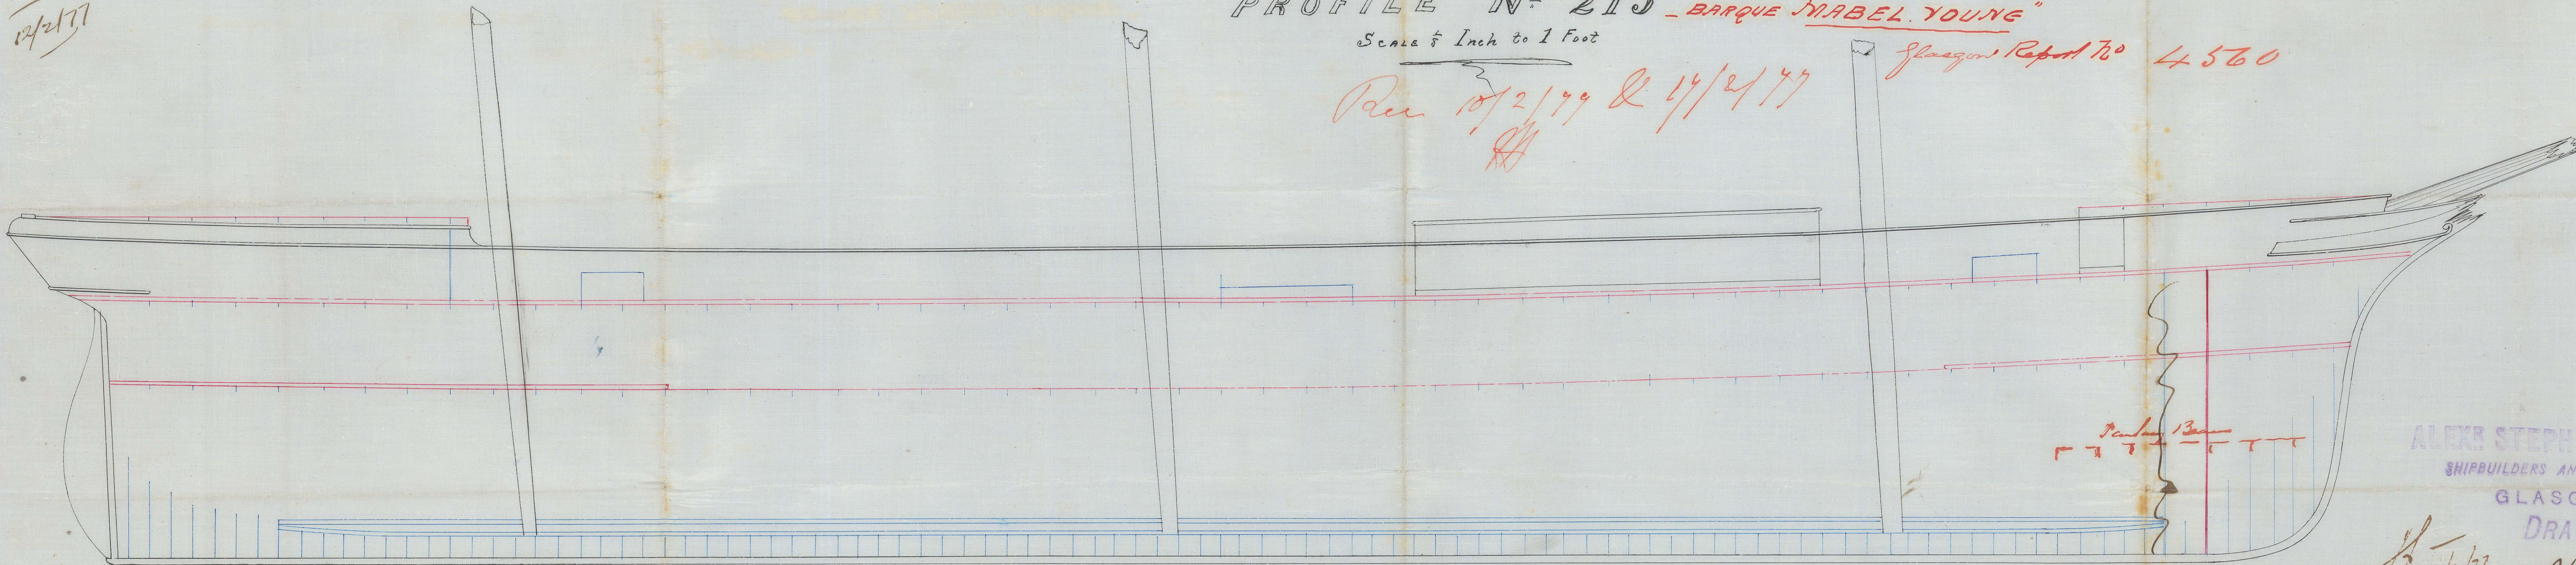

Panama Beam
11 11 11 11 11

ALEXR STEPHEN & SONS,
SHIPBUILDERS AND ENGINEERS,
GLASGOW.

DRAWING No. 758

Ed. 9/2/77

12/2/77
14/2/77
18/2/77

18/2/77



© 2021

Lloyd's Register
Foundation

~~549/4~~
8/5

Lloyd's Register
Foundation


[Faint handwritten notes or scribbles]

15

1771

2000