

MIDSHIP SECTION

Iron Sailing Barque.

N^o 215

MABEL YOUNG

To class 100 A.1 at Lloyds

Glasgow Report No 4560

Per 10/2/77

Dimensions.


Length as per rule 202.
Breadth Half moulded 16.65
Depth from Top of Keel 22.66
Half midship breadth 34.7

Numerals

16.65 + 22.66 + 34.7 = 74.01 Hullworkship
" + " + " x 202 = 14950.02 Longitudinal
" + " + " x " + " = 15946.68 Outfit...

6 x 4 Yellow Pine.

11 x 7/16 for 1/2 to 7/16

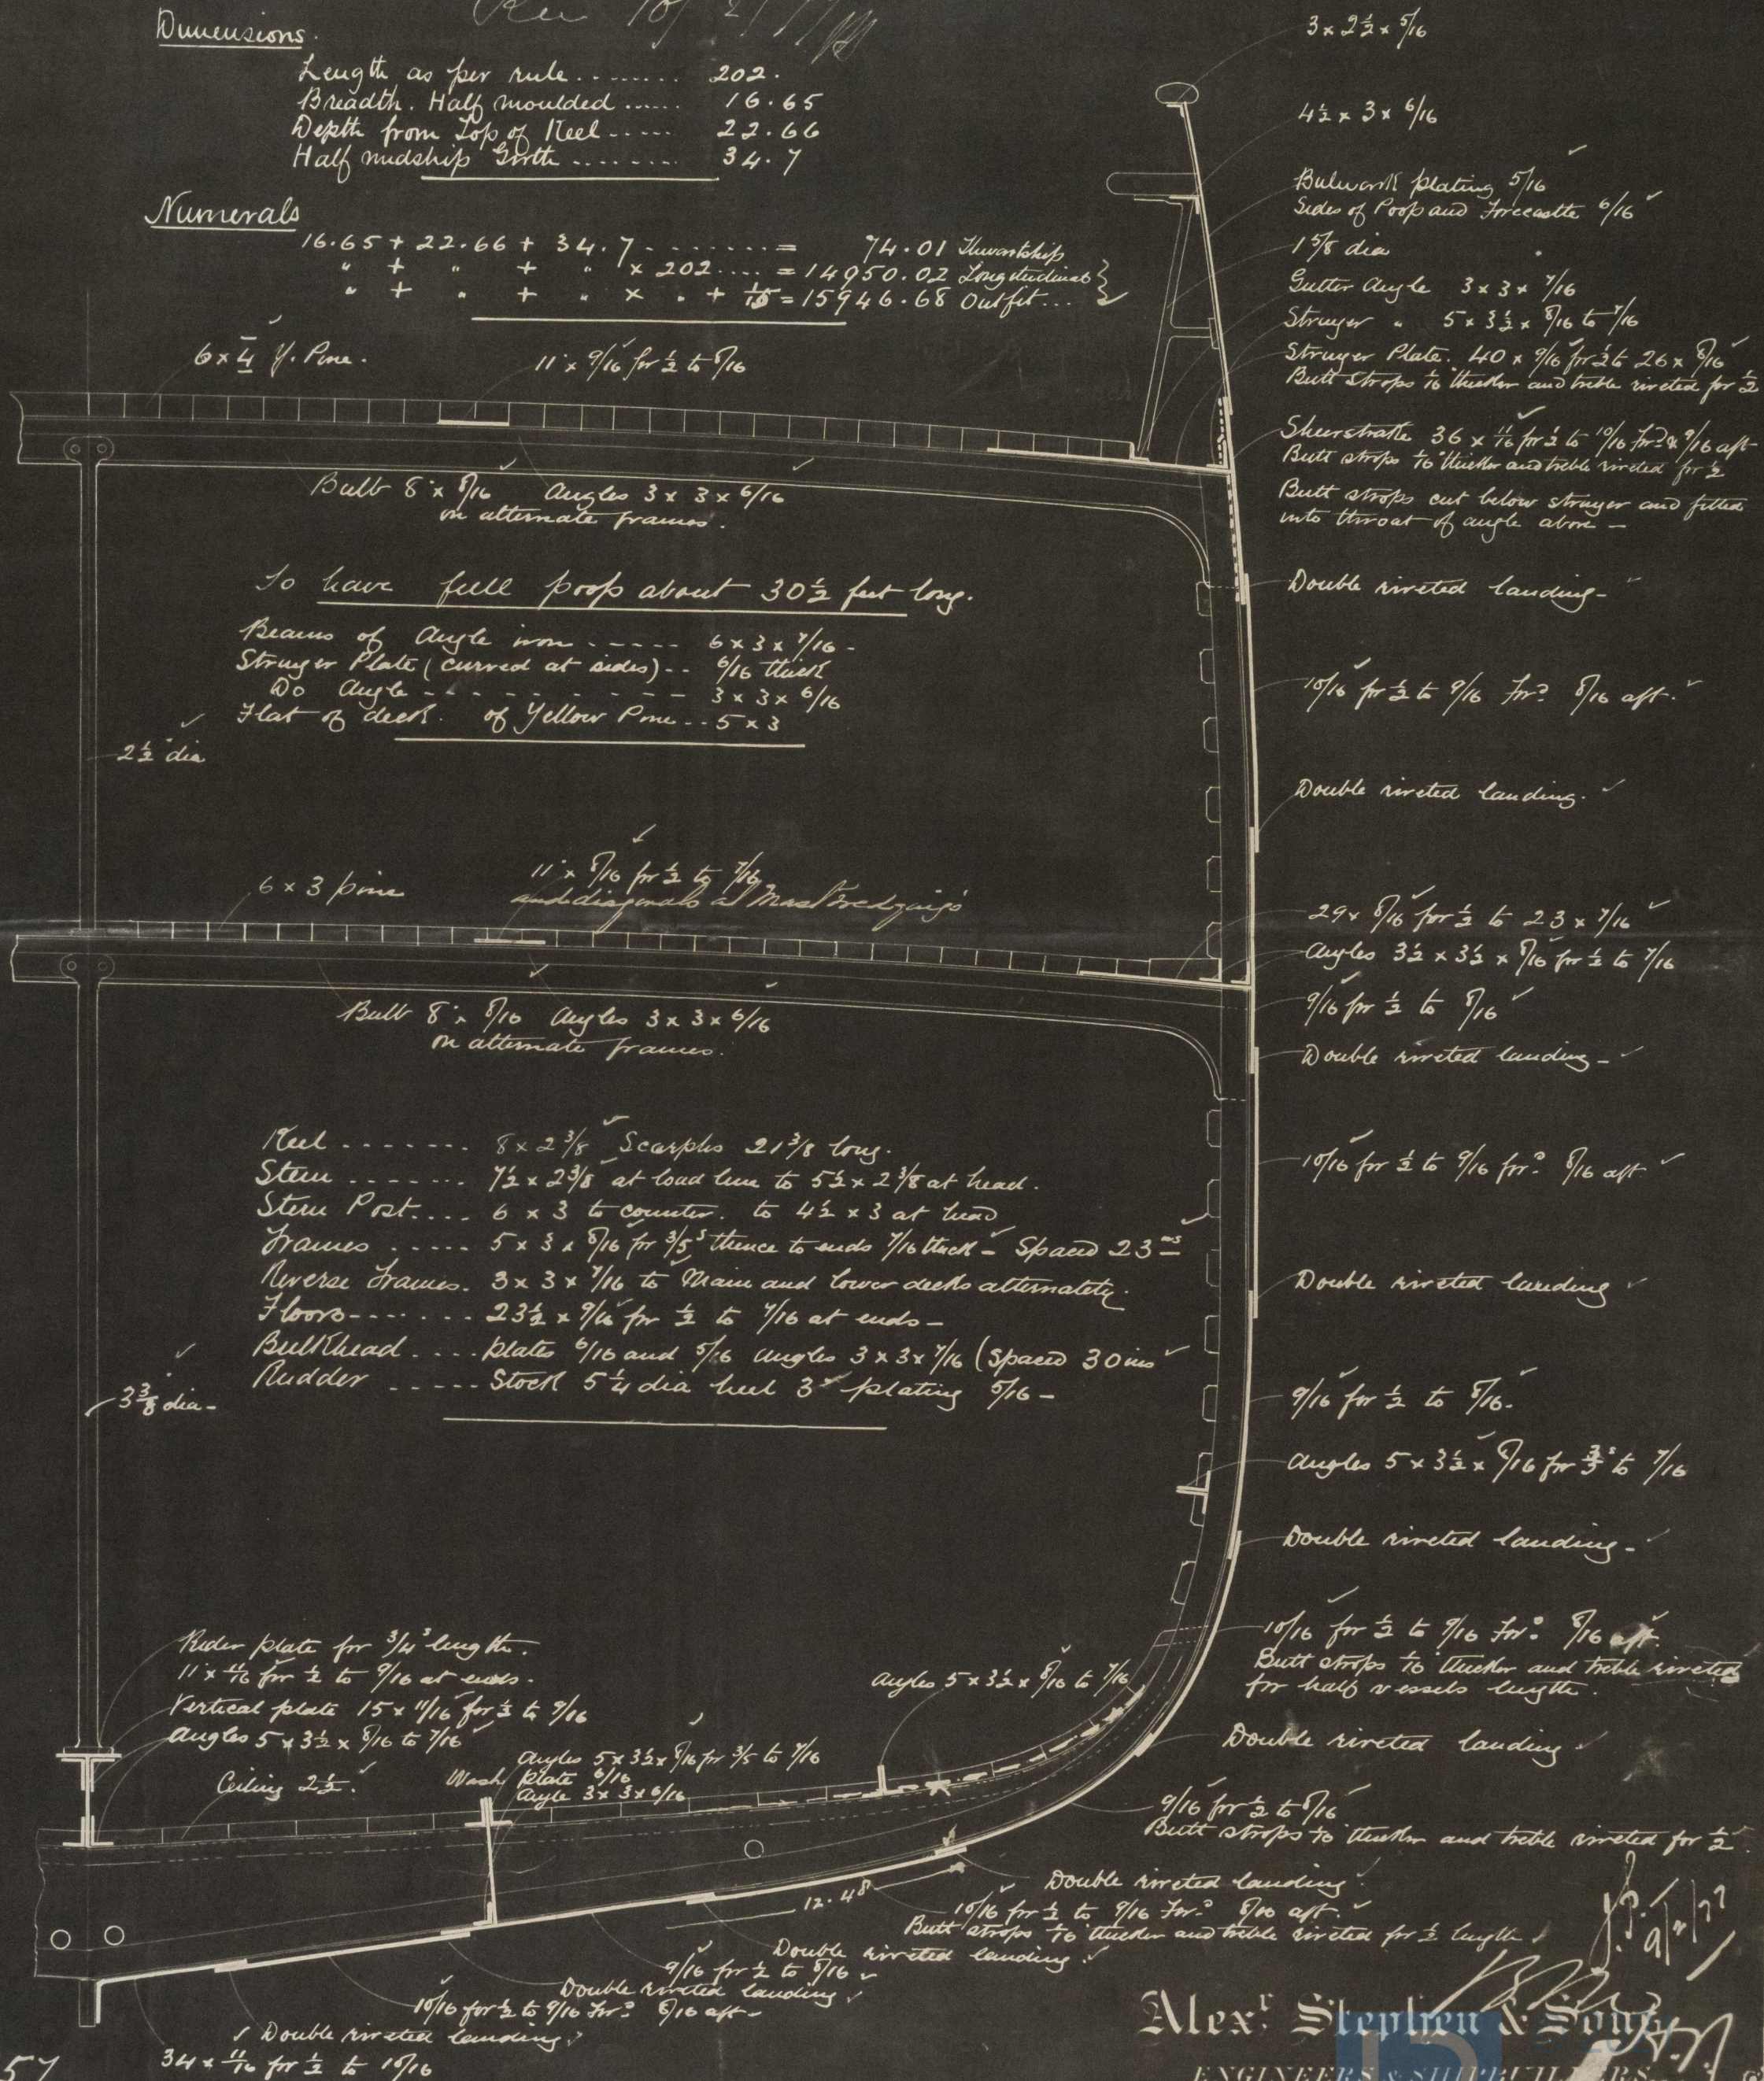

DRAWING No 757

Ex- 9/2/77

Scale 1/2 Inch to one Foot

Alex. Stephen & Son

ENGINEERS & SHIPBUILDERS

GLASGOW

Foundry