

Keel 82 feet  $16 \times 1\frac{1}{2}$

Beams  $1\frac{1}{2} \times 2 \times \frac{3}{8}$

Frames  $8 \times 2\frac{1}{2} \times \frac{3}{8}$

Stem and Stem Post  $6 \times 1\frac{1}{2}$

Reversed Angle Iron  $2\frac{1}{2} \times \frac{5}{8}$

Engine Bearers  $2\frac{1}{2} \times 2\frac{1}{2} \times \frac{3}{8}$

Side Plate  $4 \times \frac{5}{8}$

Upper Plate  $7 \times \frac{3}{8}$

Floors  $10 \times \frac{7}{16}$

Heath Abbey Iron Co  
May 25<sup>th</sup> 1876


Length 82 feet  
Breadth 17  
Depth 9.7 in  
Half girth 15.4 1/2

First No 33.5 1/2  
Second No 27.4 1/2

1/6/76

Scale 1/2 to the Foot

Recd 29/5/76

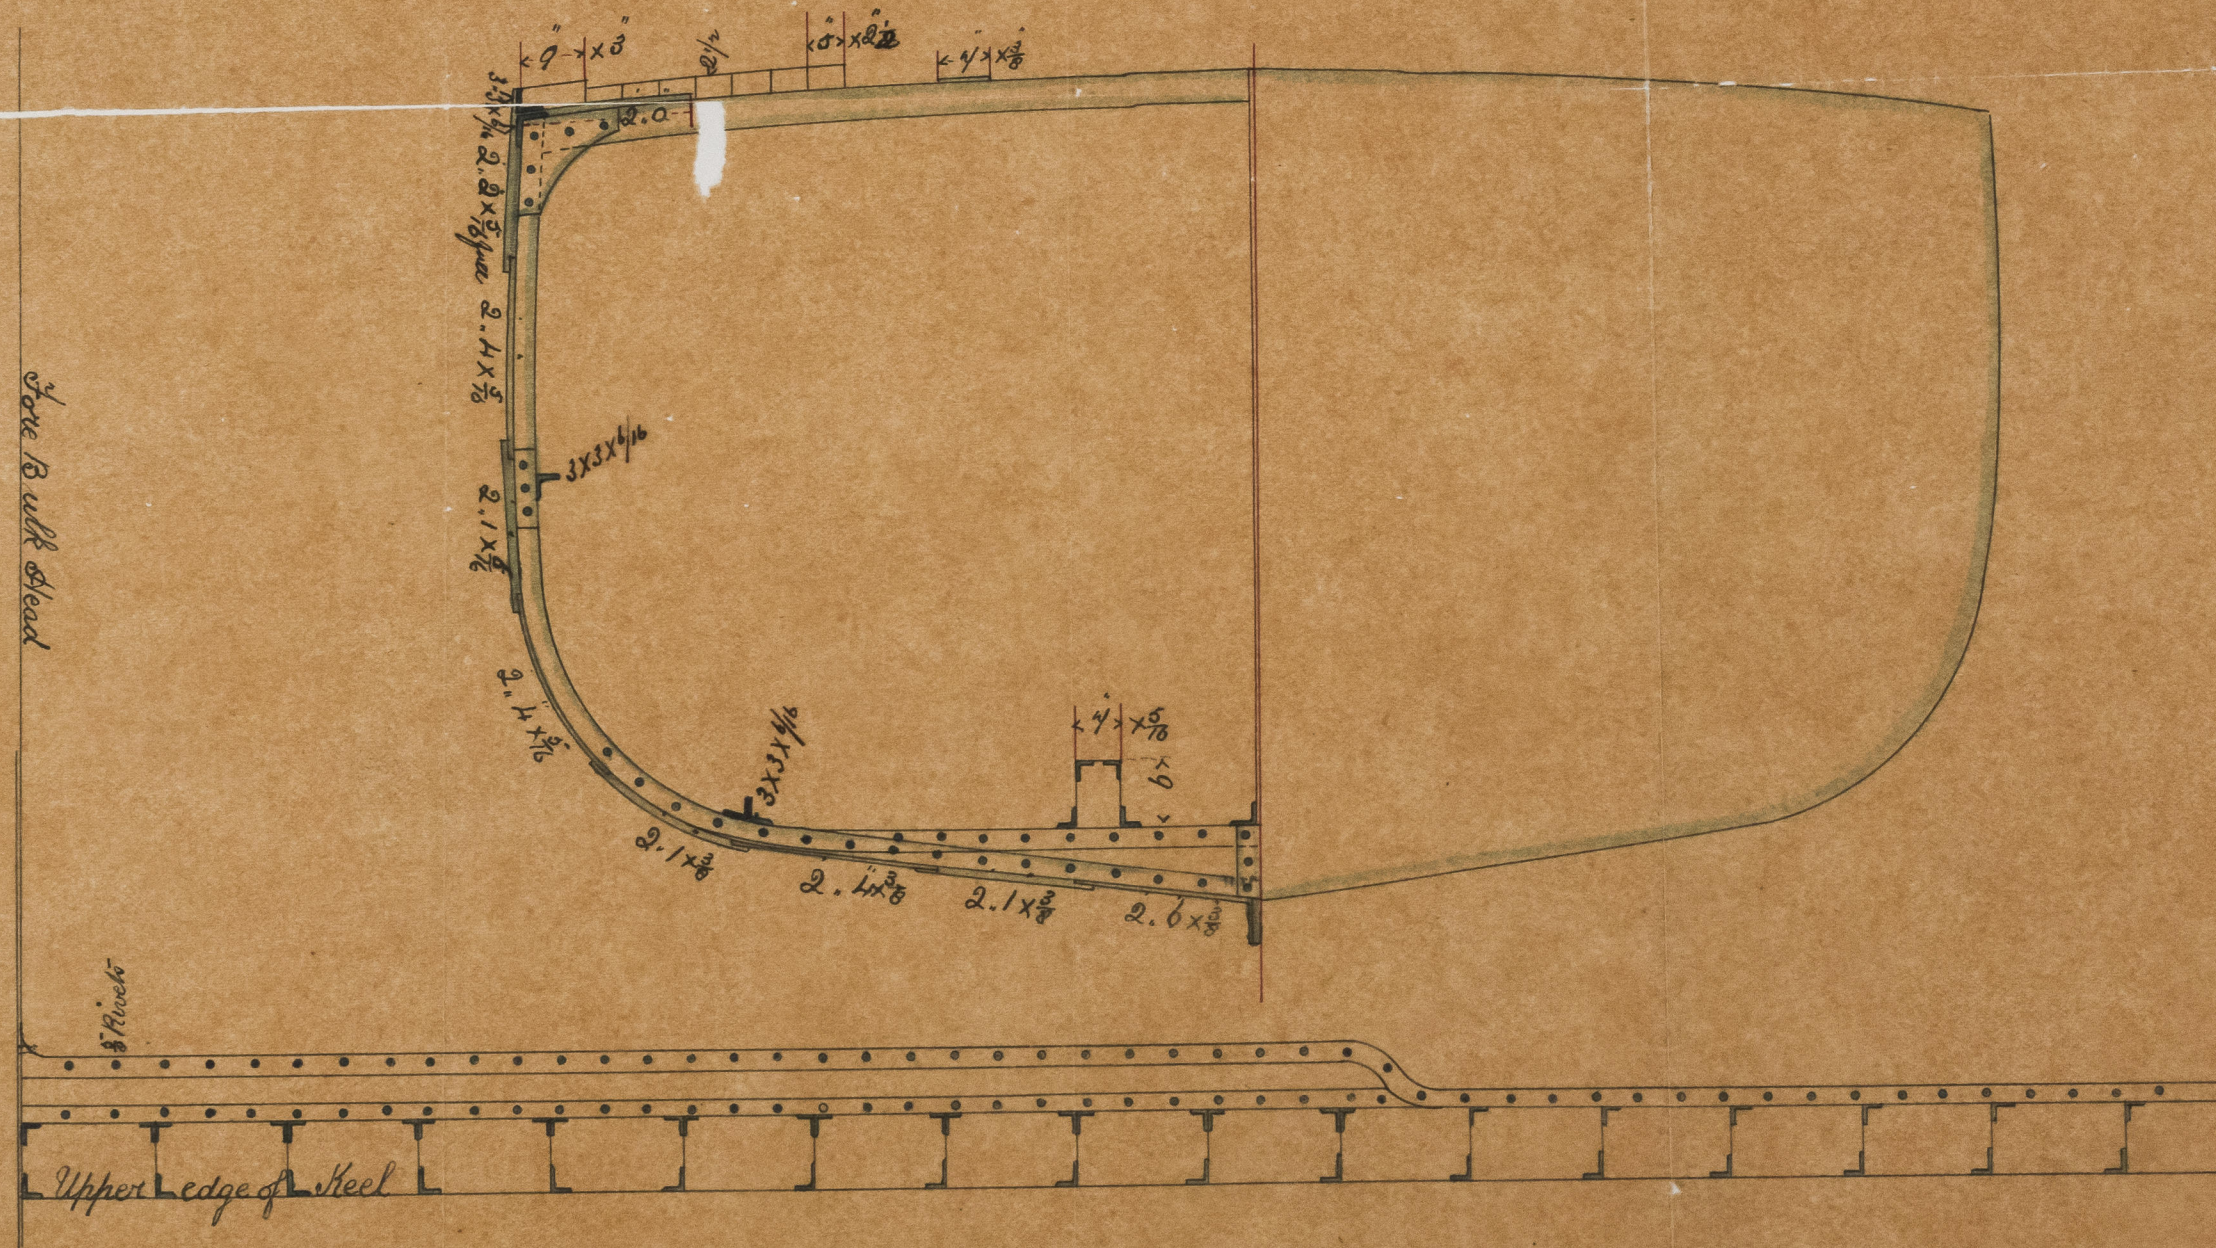

30/5/76

To be continued to aft of Bulk Head



© 2021  
Lloyd's Register  
Foundation