


$\frac{1}{2}$ Girth 17. 92
 $\frac{1}{2}$ Breadth 9. 75
Depth 11.
 $\frac{38.67}{167.5} = 1^{st} \text{ Numerat}$
 $\frac{19335}{27069}$
 $\frac{23202}{3867}$
 $\frac{6444.225}{3867} = 2^{nd} \text{ Numerat}$

SCALE $\frac{1}{2}$ INCH TO A FOOT


Sheer Strake and Guard Strake double rivetted seams
-Remainder Single 22 Butts double rivetted.

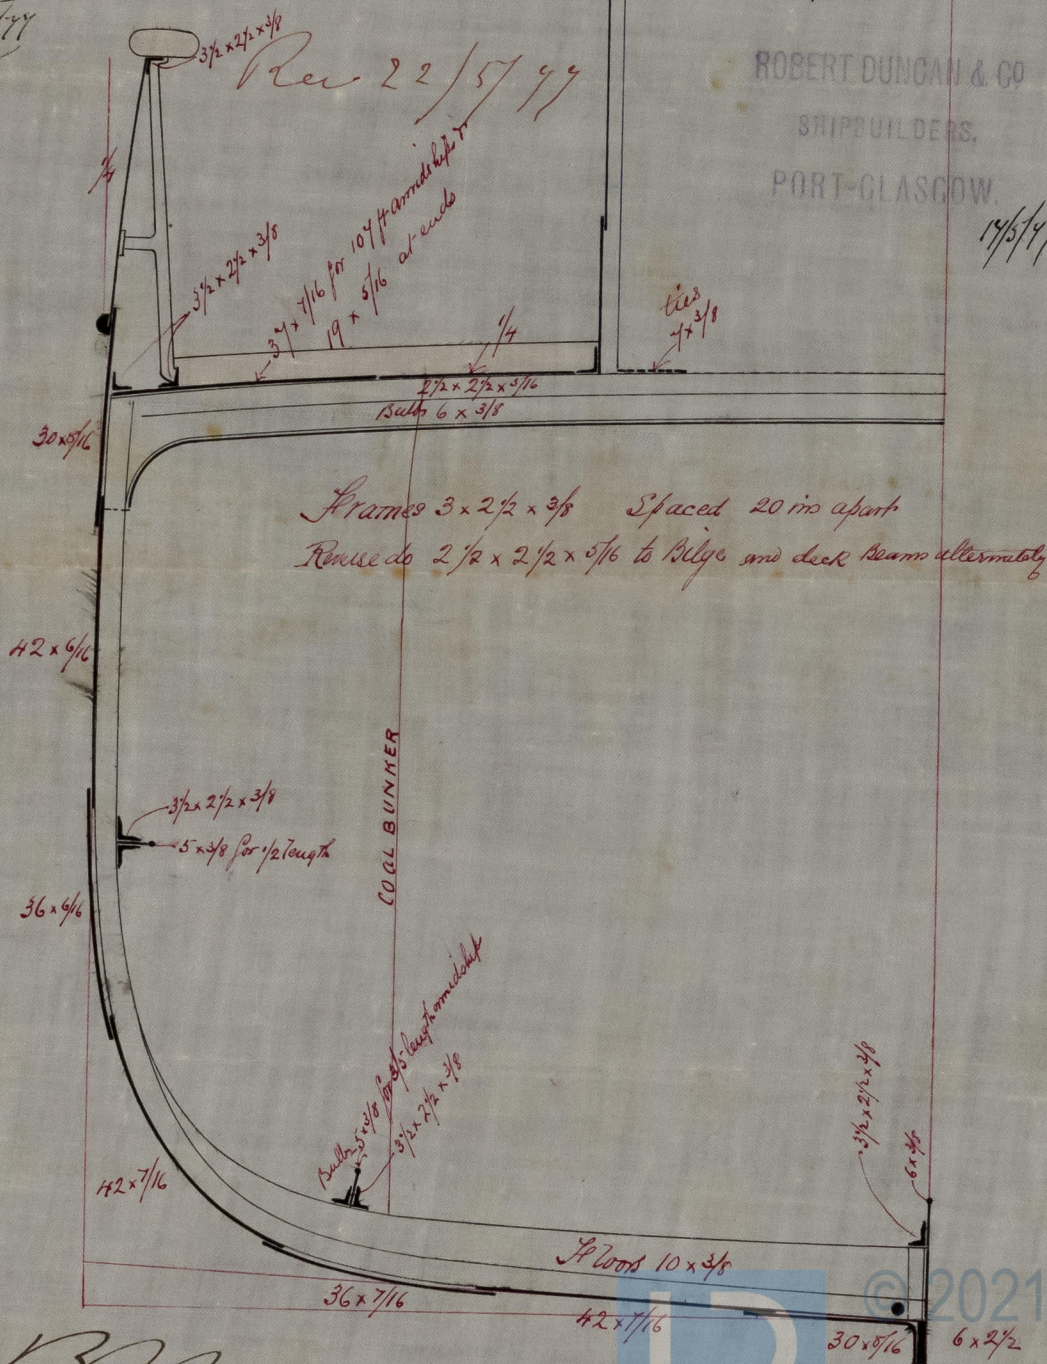

18M
22/5777

W. J.
2.2/5777

IRON 525-0012