


10/9/77

Rec 10/9/99

S.

175

Northsands

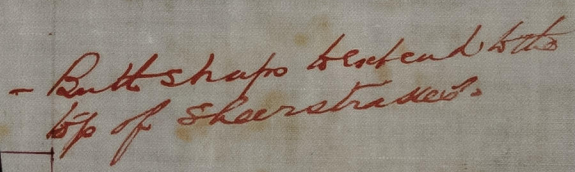

36 $\frac{11}{16} \times \frac{9}{8}$ Bull straps $\frac{1}{16}$ thicker
 $\frac{3}{4}$ length 9 Trellis rivelled $\frac{1}{2}$ length

having as profits of the submitted
showing transverse strength in
Engine rooms, Collisions bulkhead
and other unusual informants

William Lloyd.

Note Reverse Bar not cut

One Strake $\frac{1}{2}$ thicker at bilge $\frac{1}{2}$ length
Two Strakes $\frac{1}{2}$ thicker butt straps
& Treble rivelled $\frac{1}{2}$ length ✓
Boss Plates $\frac{8}{16}$ ✓

13

13/6/77

Lloyd's Register
Foundation

IRON 525 - 0028