


Midships Section of S. S. No 356.

Scale $\frac{1}{2}$ " = one foot.

Rev 22/5/77

18/5/77

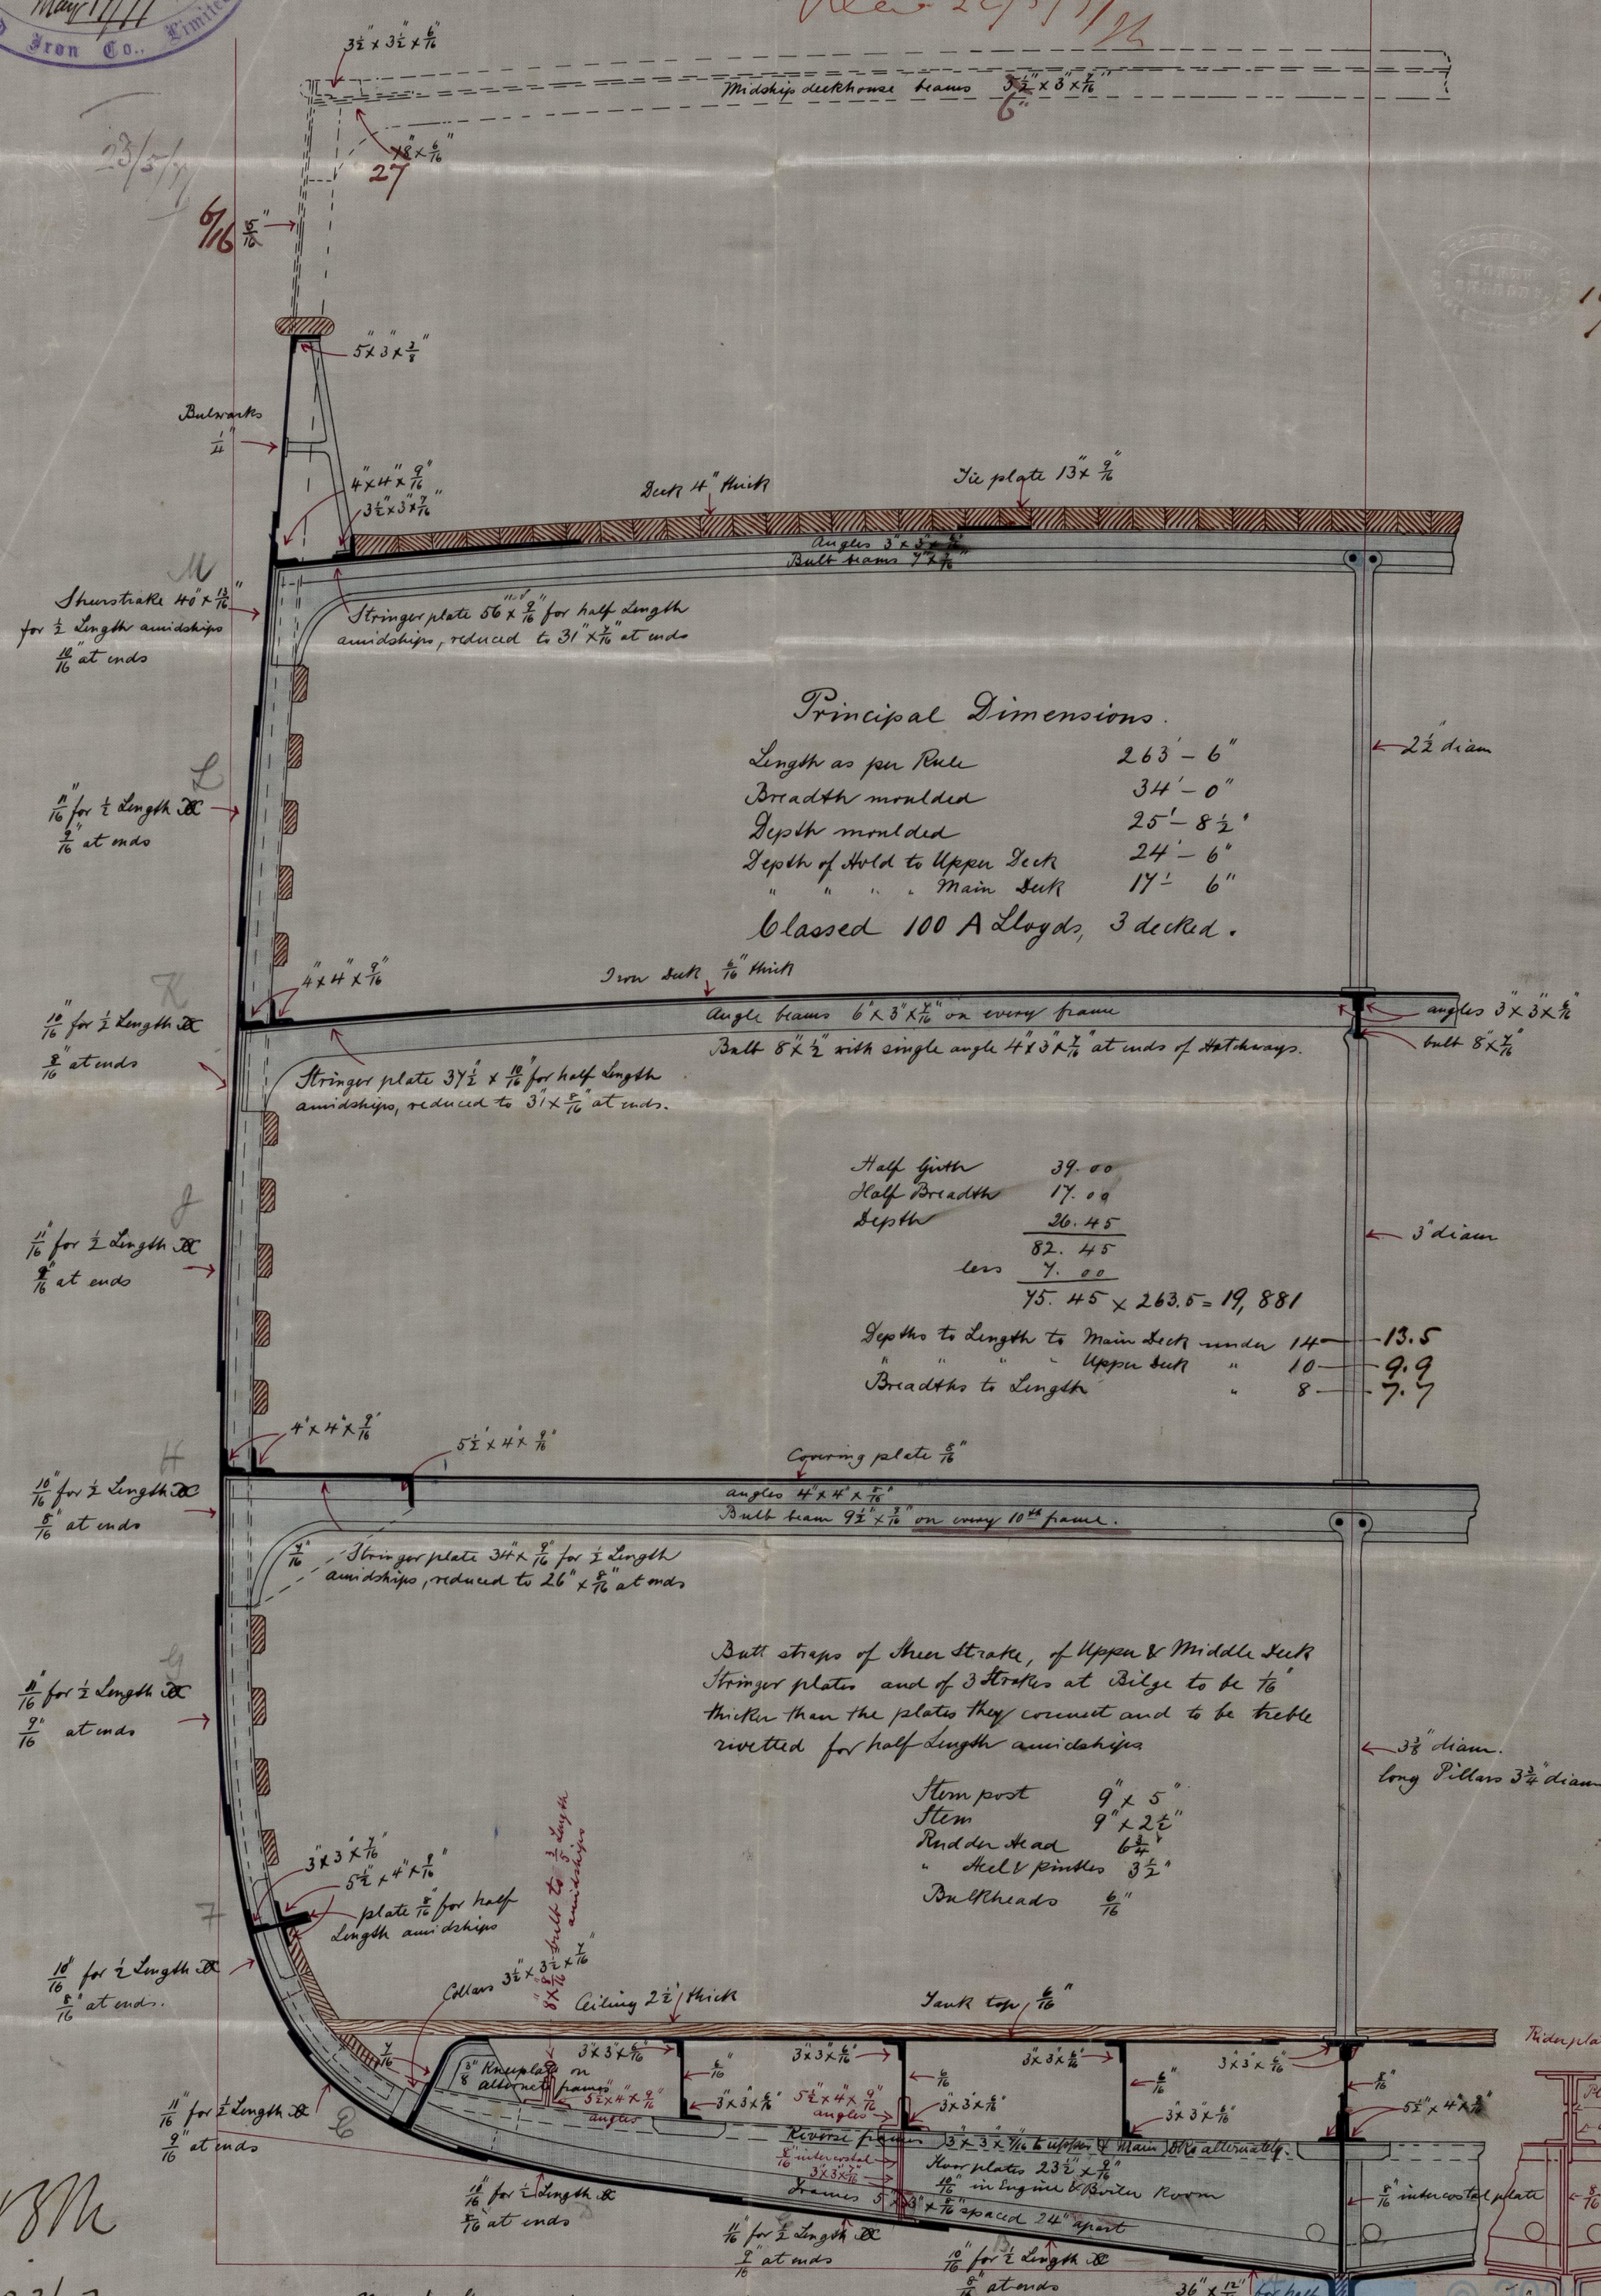

Principal Dimensions.

| | |
|-----------------------------|------------|
| Length as per Rule | 263'-6" |
| Breadth moulded | 34'-0" |
| Depth moulded | 25'-8 1/2" |
| Depth of Hold to Upper Deck | 24'-6" |
| " " " Main Deck | 17'-6" |

Classed 100 A Lloyd's, 3 decked.

| | |
|--------------|-------|
| Half girth | 39.00 |
| Half Breadth | 17.09 |
| Depth | 26.45 |
| | 82.45 |
| less | 7.00 |
| | 75.45 |

75.45 x 263.5 = 19,881

Depth to Length to Main Deck under 14' - 13.5

" " " Upper Deck " 10 - 9.9

Breadths to Length " 8 - 7.7

Note: Shell plating in way of Tank bottom to be reduced $\frac{1}{16}$ " in thickness.