


5/4/94

S.S. "TITUS" Glasgow. Report No 45-94

Nº, 220,

Rev 7/7/77 & 14/7/99
JF

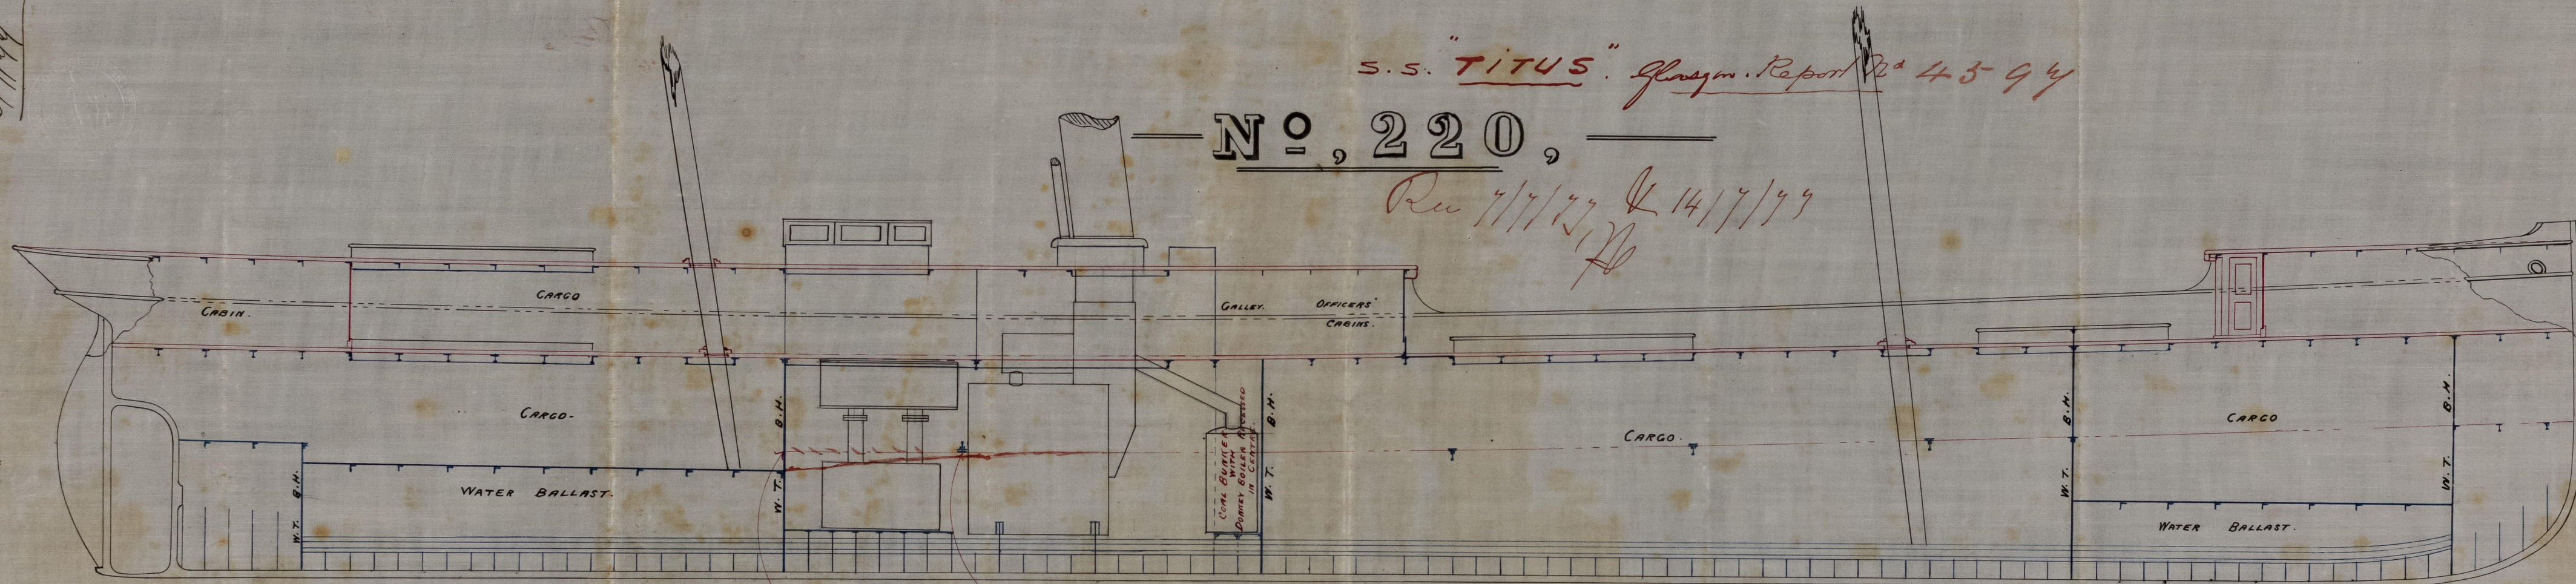

Beam. Same Scantling as Hold Beams.
riveted on top of Stringer Plate.
Hold Stringer plates here
riveted on to Bulkhead.

DRAWING Nº 875-
Ed: 5/4/77

SCALE 1/8 INCH TO A FOOT

Alexr Stephen & Sons.

ENGINEERS & SHIPBUILDERS

GLASGOW

1/7/77

100525-0071