


B. B. Cadzow Forest of Glasgow
 Snemock Report N^o 1381.
 Rev 11/2/78
 H

1.10.77

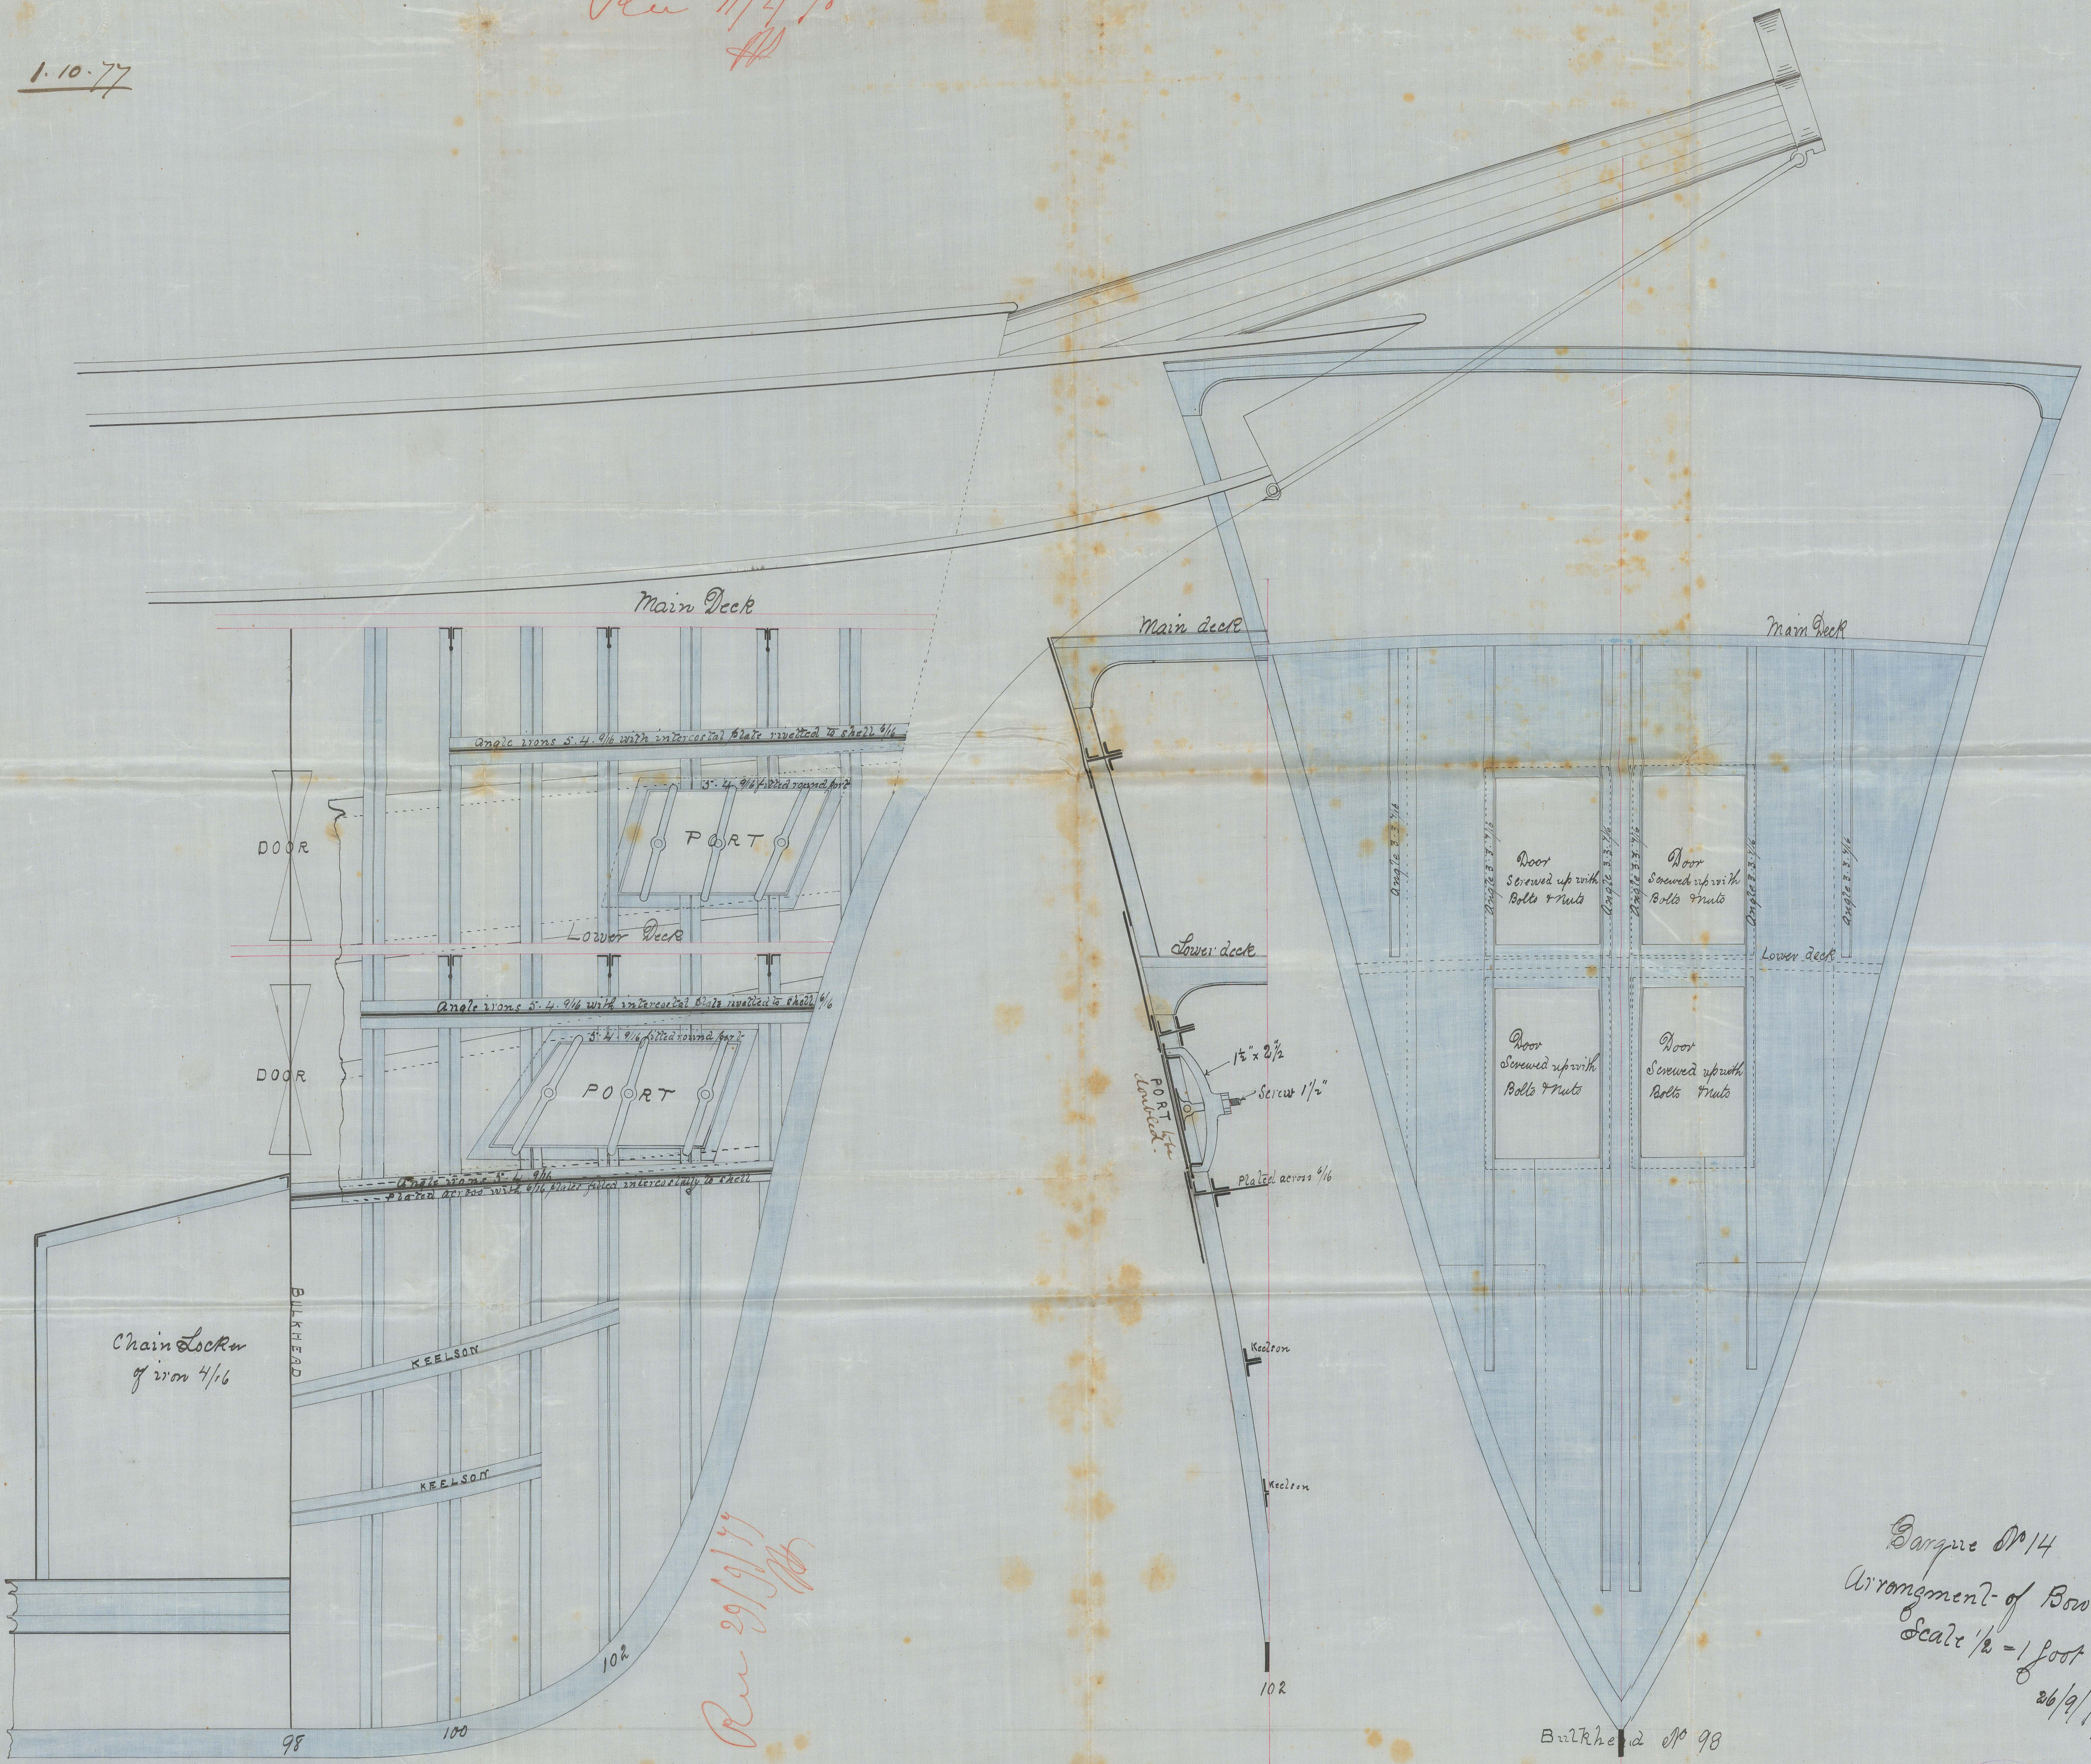

Rev 29/9/77
 H

Barque N^o 14
 Arrangement of Bow ports
 Scale 1/2" = 1 foot
 26/9/77



But double plated
 the ports in both cases come
 together on an inside strike
 of plates & the lining is not
 interrupted with

1/10/77