

313-77

# 1/2 Midship Section Barge No 14. "Gadgou Forest" of Glasgow Lockport Report No 4381

205 x 33.9 x 21.0 Mold Scale 1/2 inch = 1 foot



1/2 Breadth 16.95  
 1/2 Girth 35.3  
 Depth 23.45

$1770 \times 35.3 \times 20.4 = 15442.2$   $75^*$  added for Poop =  $15442$   
 $1029$   
16471 Equipment etc

Rec 29/8/77 & 29/9/77  
 H

Equipment

1 Bower ex stock	Auto 30
1 " " "	28 1/2 Auto
1 " " "	27 = 85 1/2 Coll
1 Stream moor	12
1 Redge	6
1 " " "	3
270 Stalkoms	1 1/2 Chain
90 " "	1/6 Stream Chain

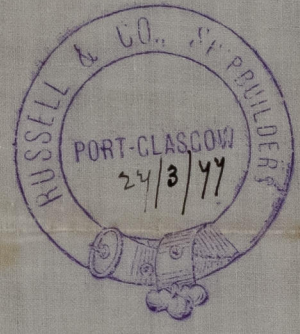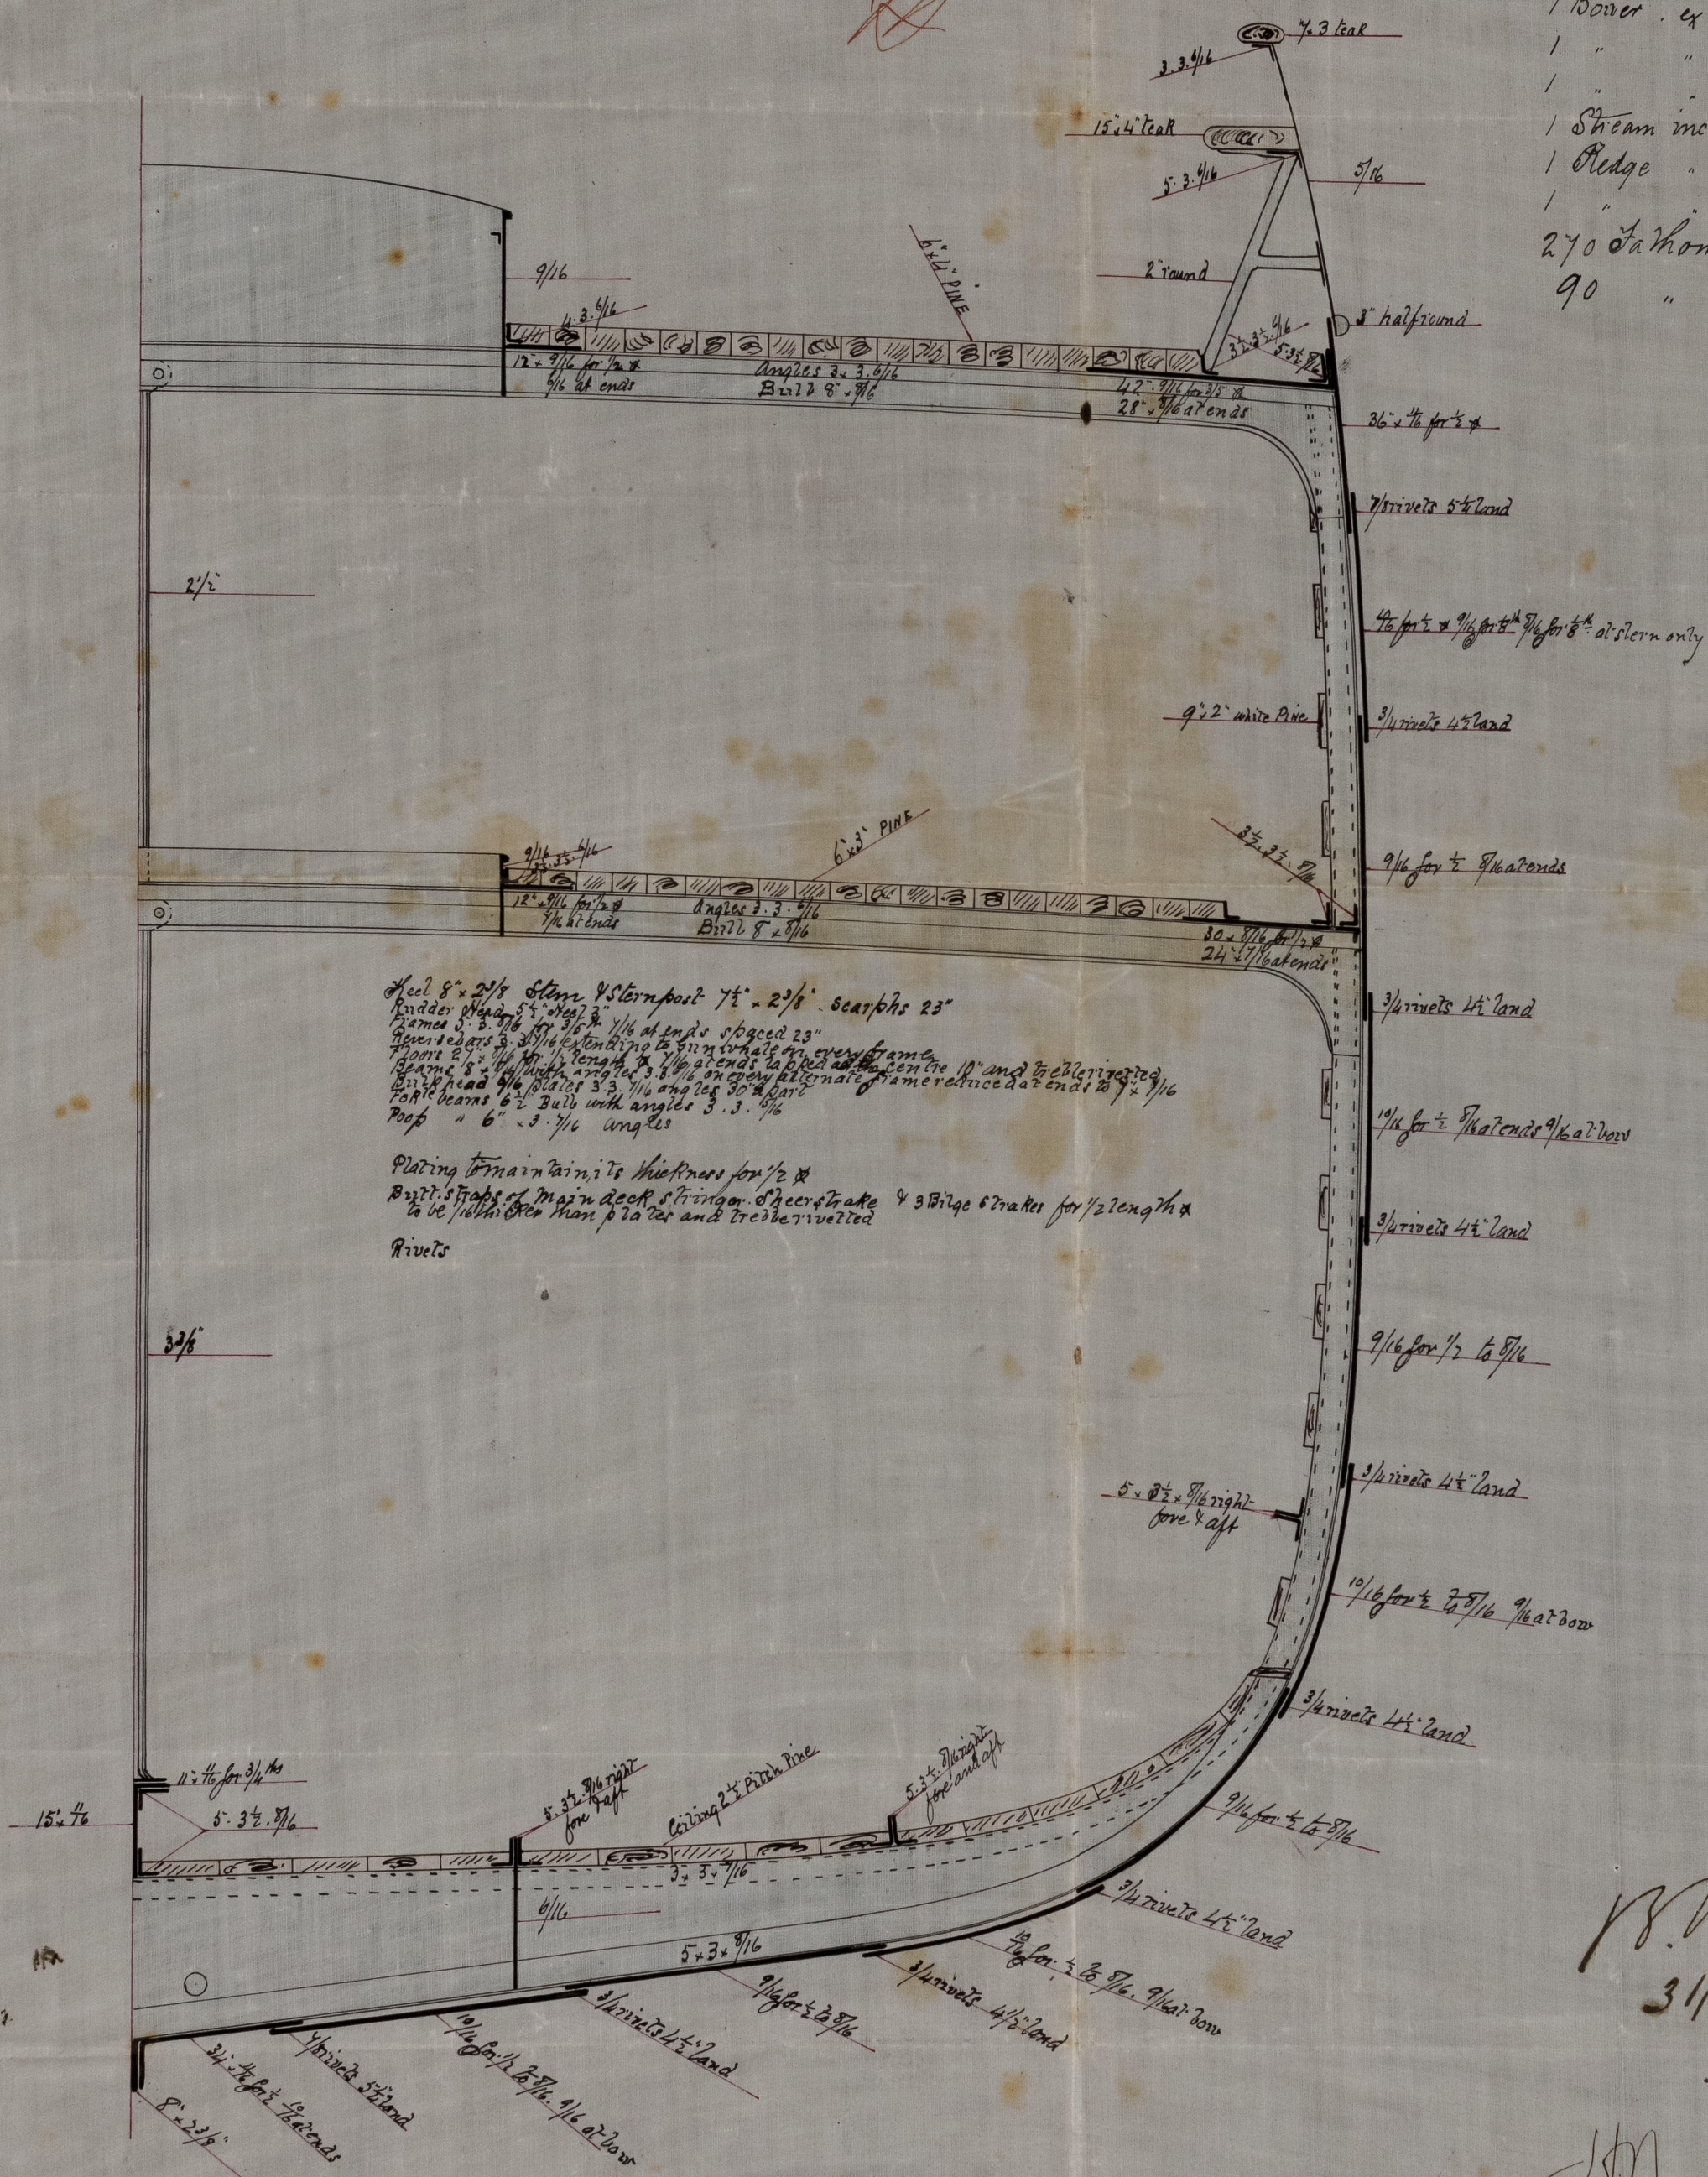

1877  
 31/3/77

J.M.  
 31/3/77