


31.3.17

Barque "Cadizow Forest" of Glasgow
Greenock Report No 4381.

Rev 24/3/77
H

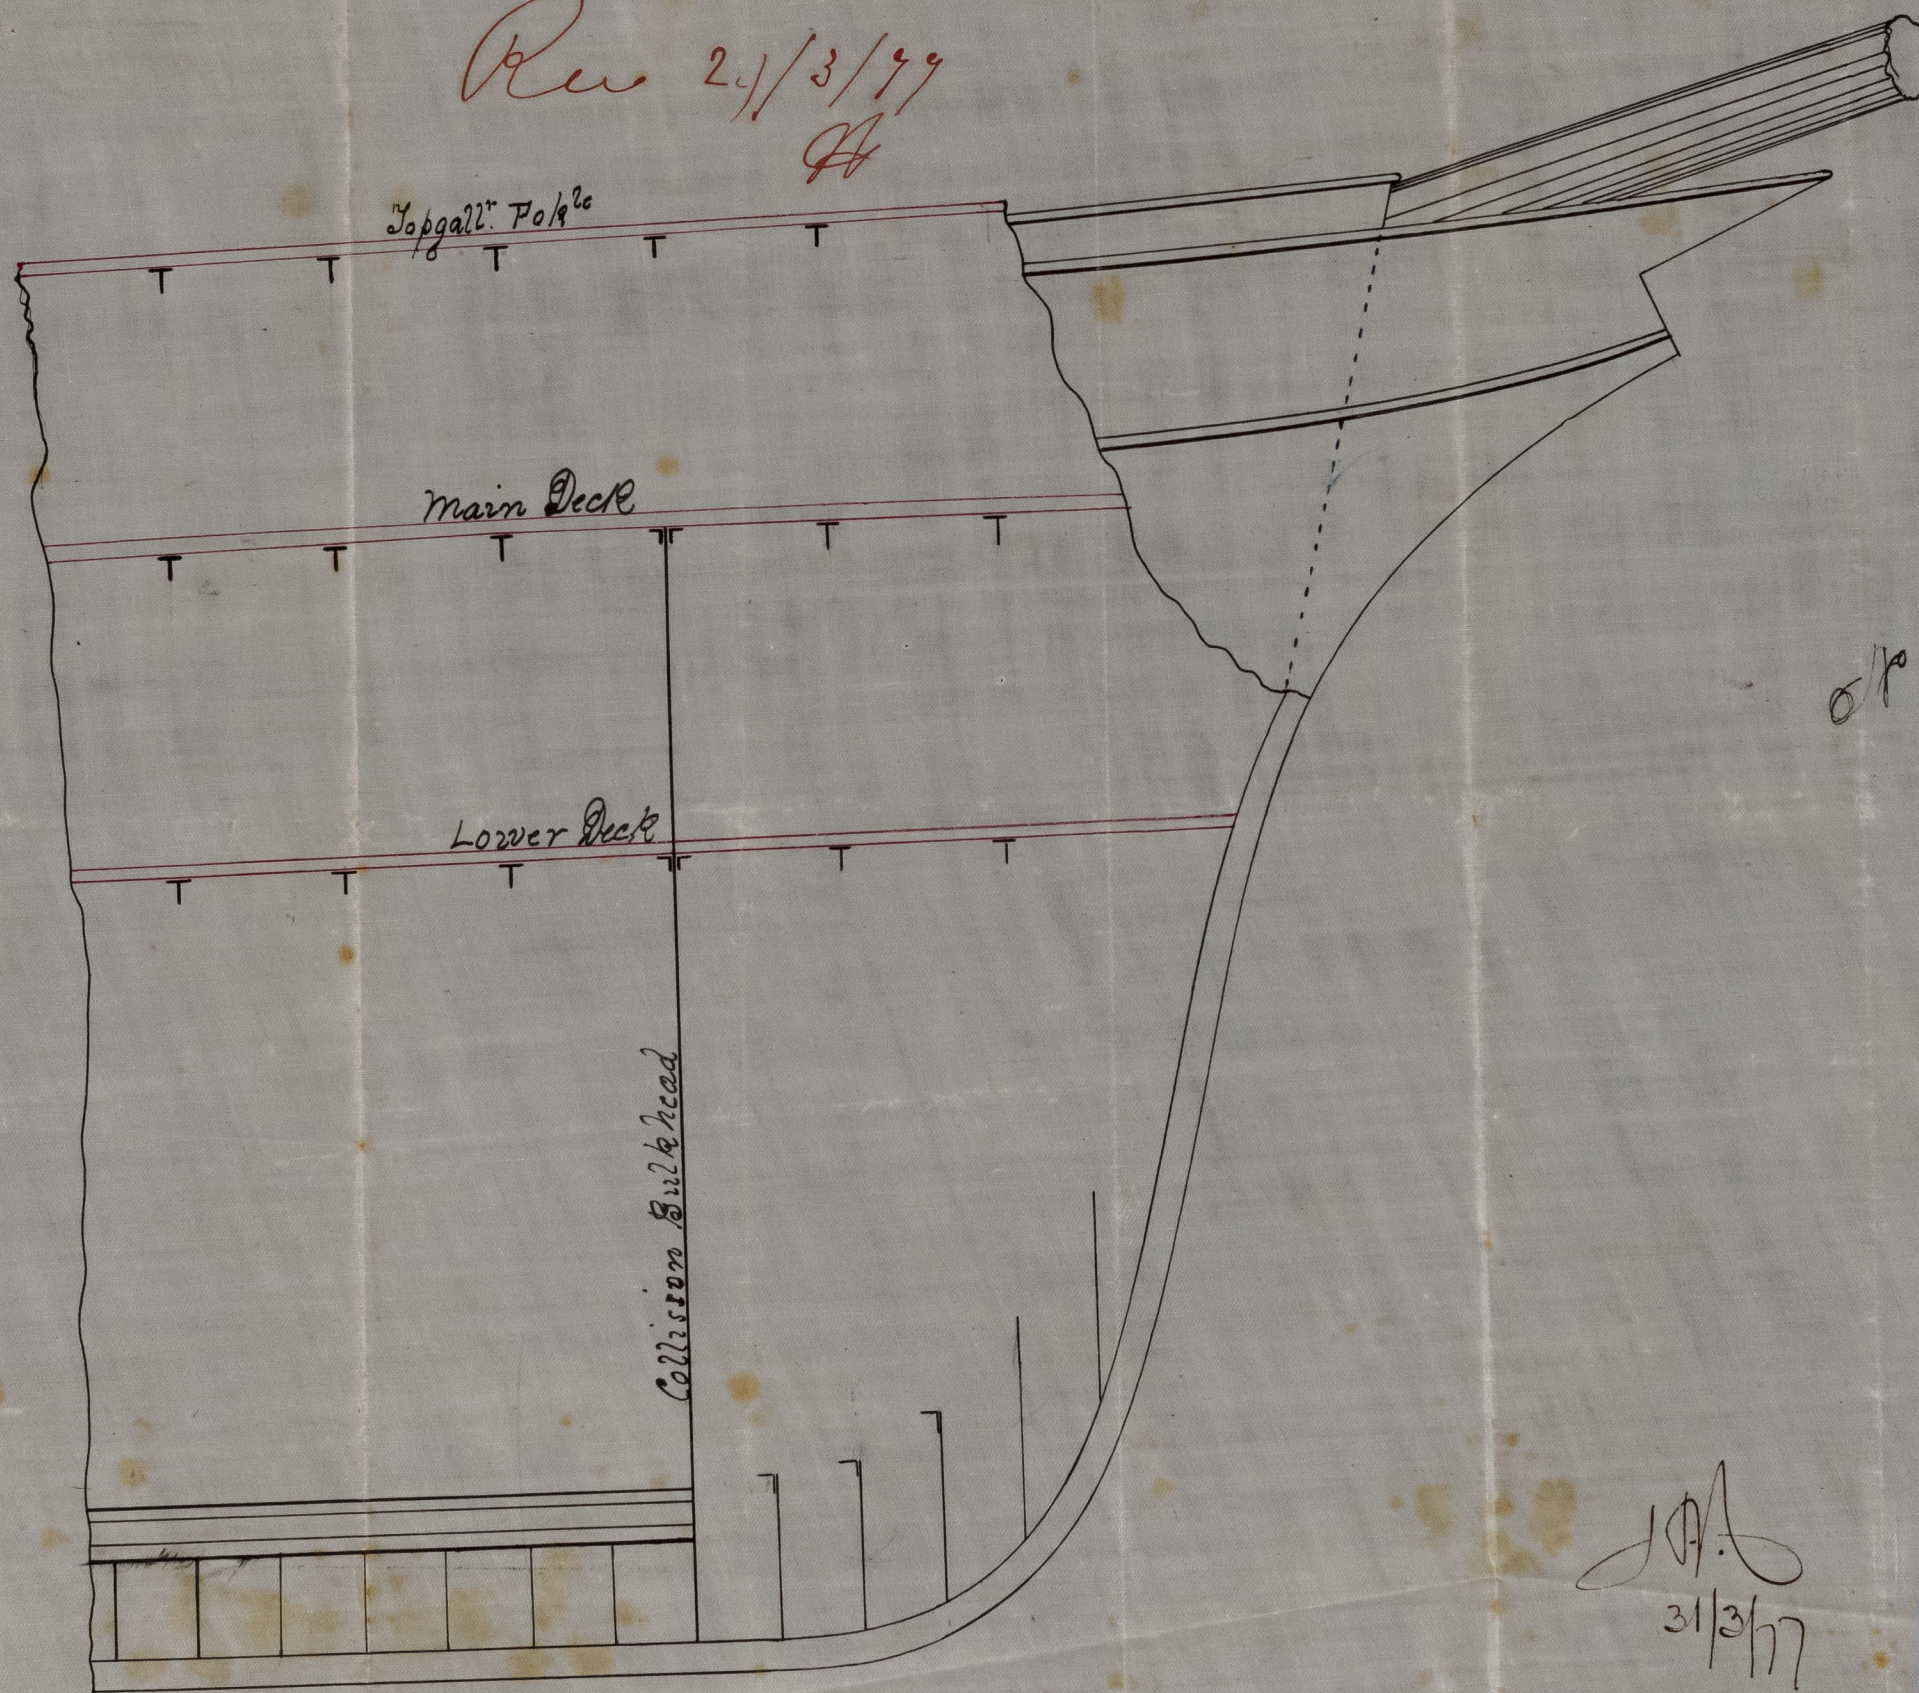

6/13

Scale $\frac{1}{4} = 1 \text{ foot}$



J.A.
31/3/77

IRON 525-0105



© 2021

Lloyd's Register
Foundation