


Report. 3949

178

70
Dr. 4/7/77 & 13/8/77 & 29/9/77

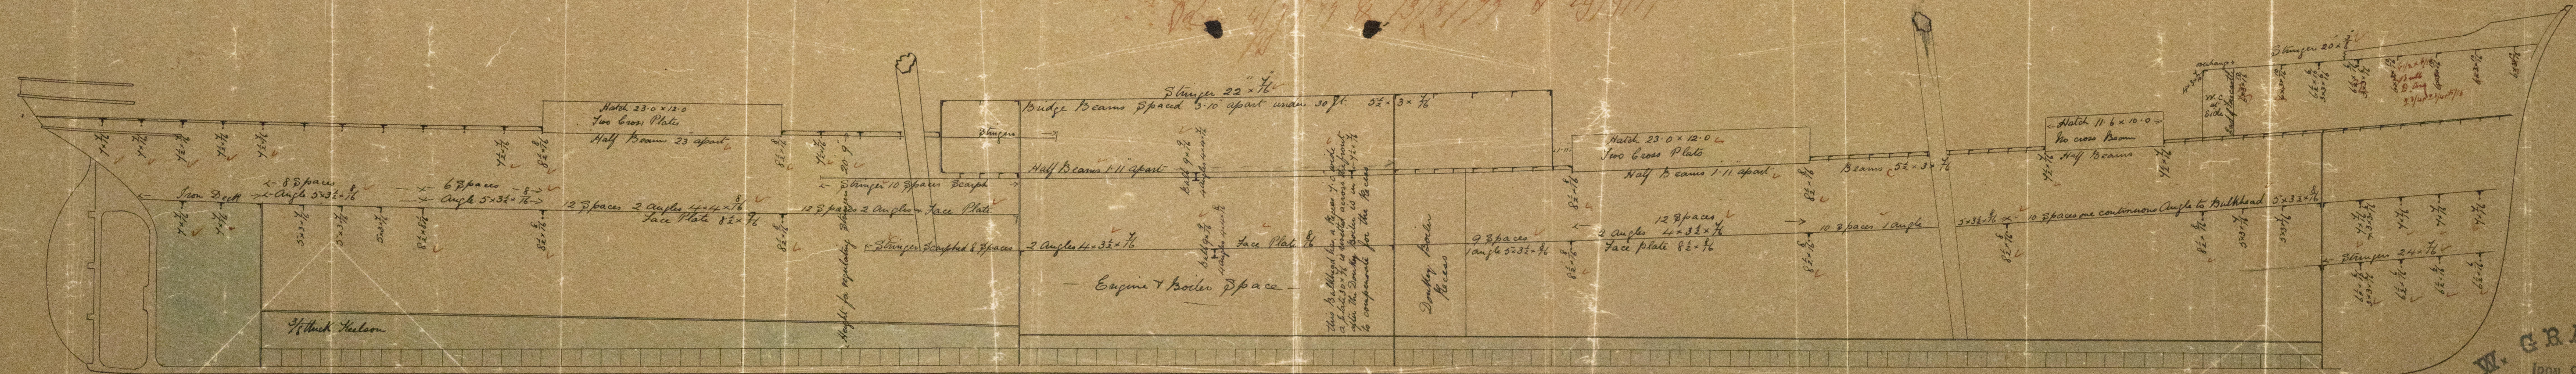

Scale $\frac{1}{8}$ " to 1 foot

W. GRAY & CO.
IRON SHIPBUILDERS

WEST REPAIRERS, 2-7-77



Lloyd's Register
Foundation

IRON 525 - 0124