


S.S. "Montrose"  
14/8/77 Report No. 2949 No. 178 S.S.

Rev 13/8/77

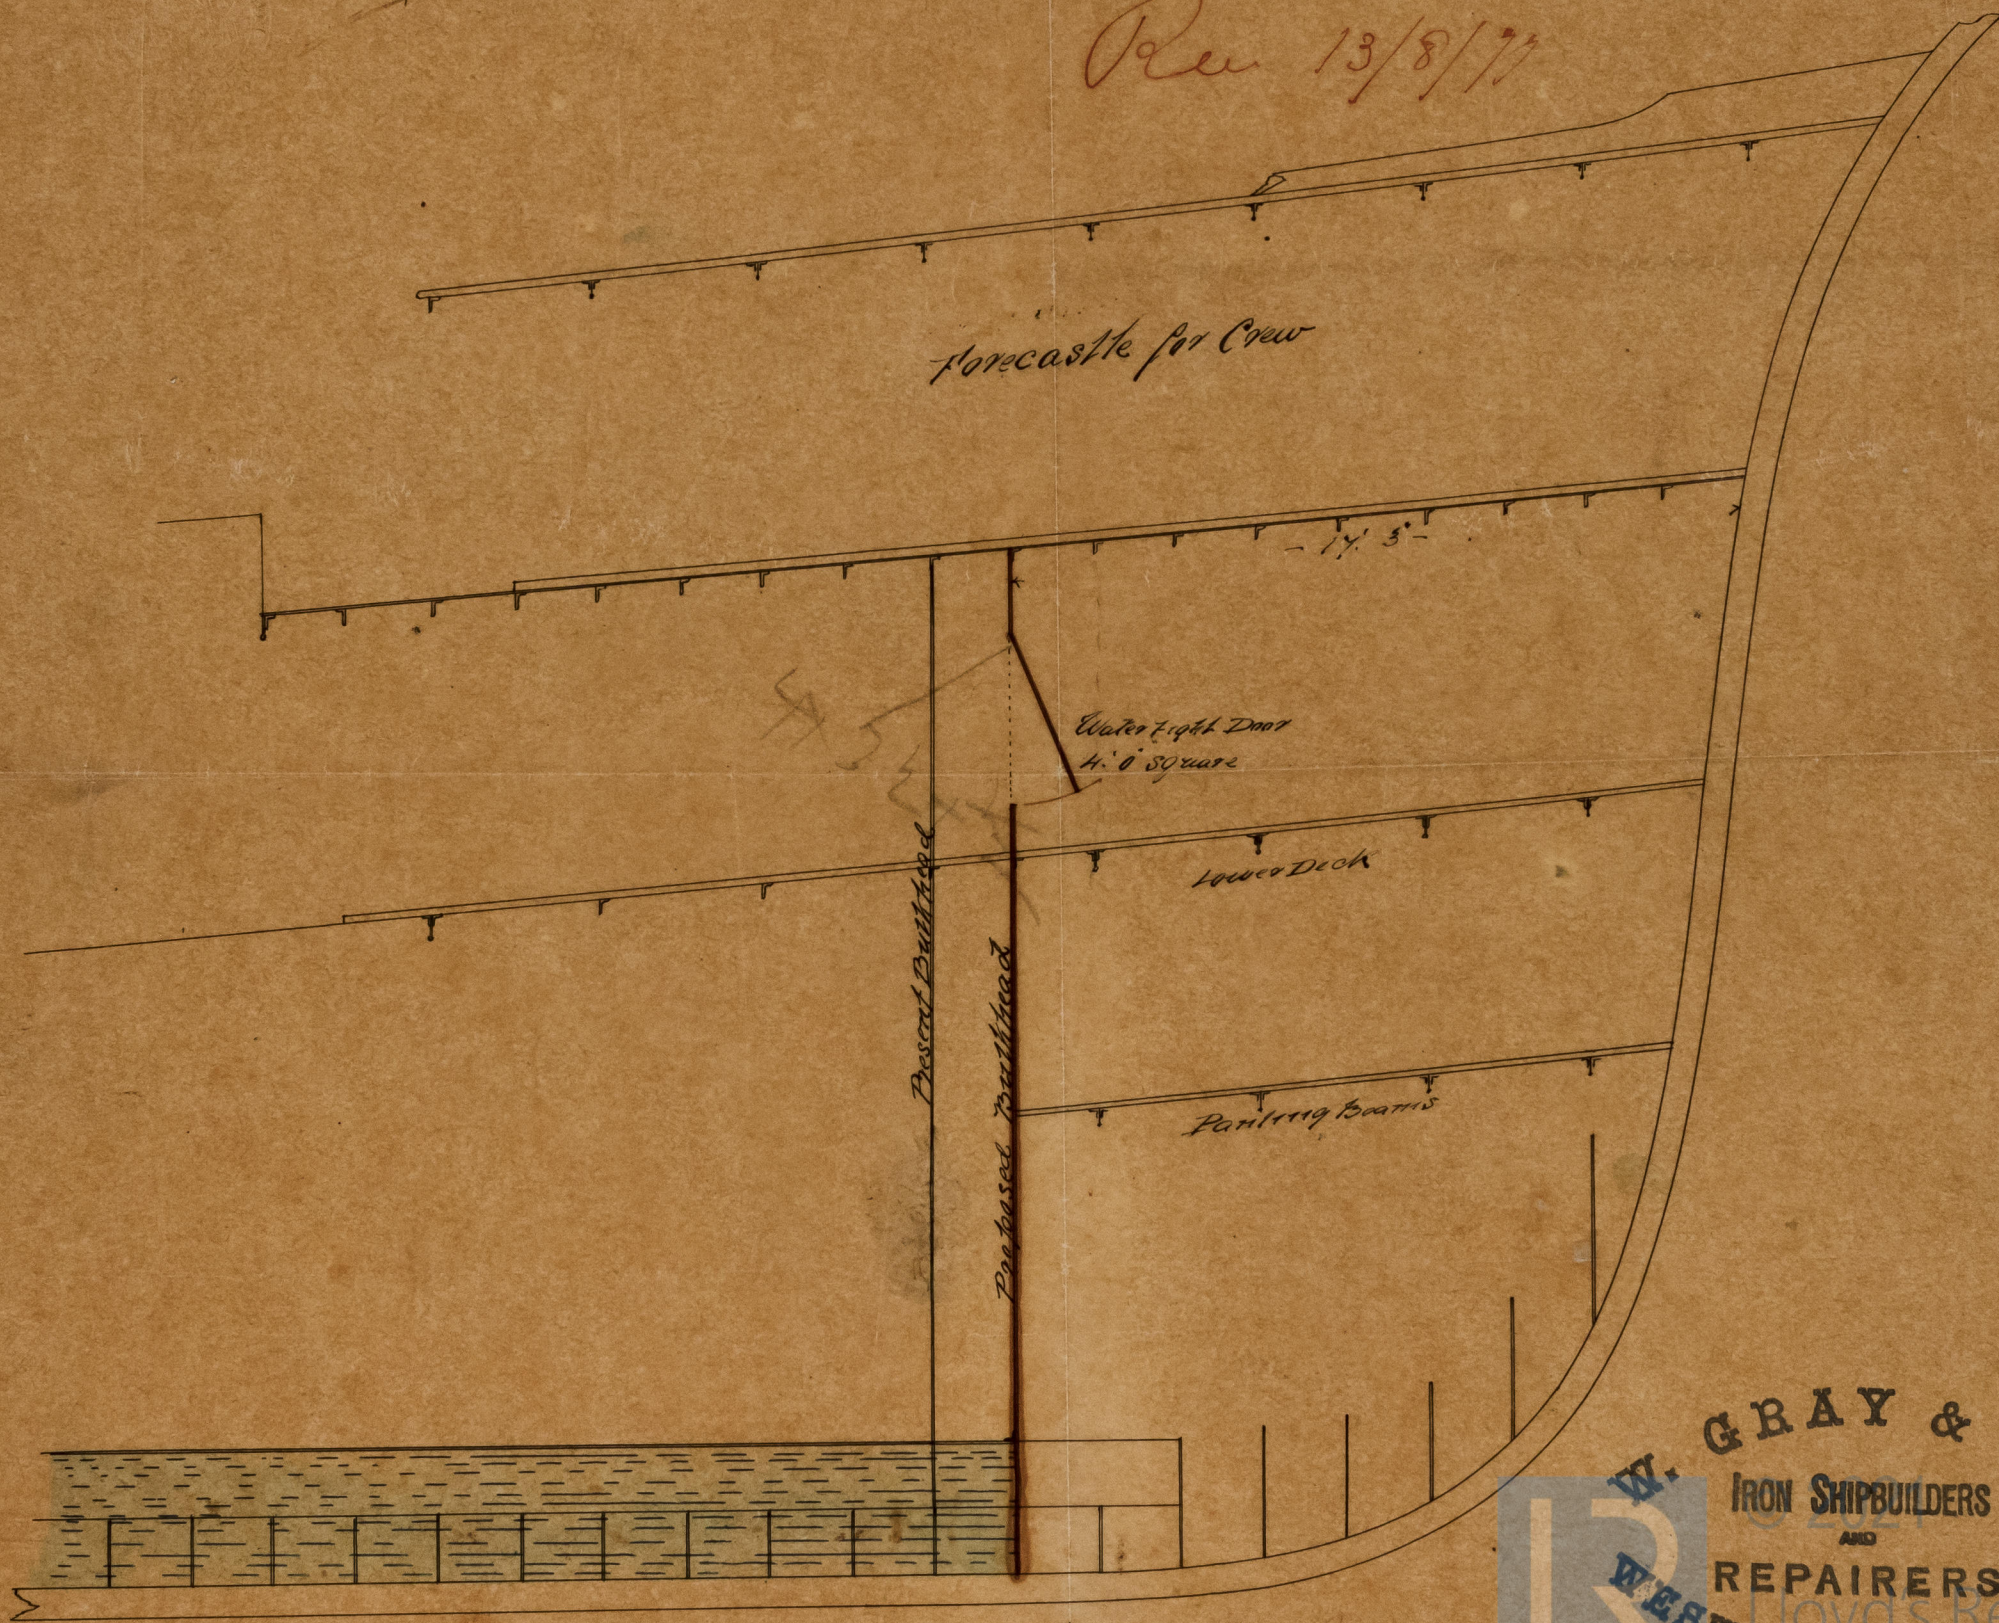

Scale 1/4" = one foot

J.V.N.  
14/8/77

S.P.M.  
11/8/77

W. GRAY & CO.  
IRON SHIPBUILDERS  
AND  
REPAIRERS,  
WEST HARTLEPOOL.

IRON 525 - 0125