

6/7/77


S. S. Montrose  
Report No. 3949

— 178 —

Class 100 A1

Length over all		235.0	233.9
Length Between Piers		235.0	233.9
Breadth Extreme		32.0	
Depth of Hold to Top of Floors		14.0	
Depth from Top of Main Deck to Keel			18.7 1/2
Gross Tonnage about	1300 Tons		31.4 1/2
Nos. for Frames &c.	65.11		65.11
" " Plating	154.24		
" " Equipment	16.947		
Depths in Length 1 1/3	Breadths in Length 7 to 7 1/2		

Rec 4/7/77 & 13/8/77

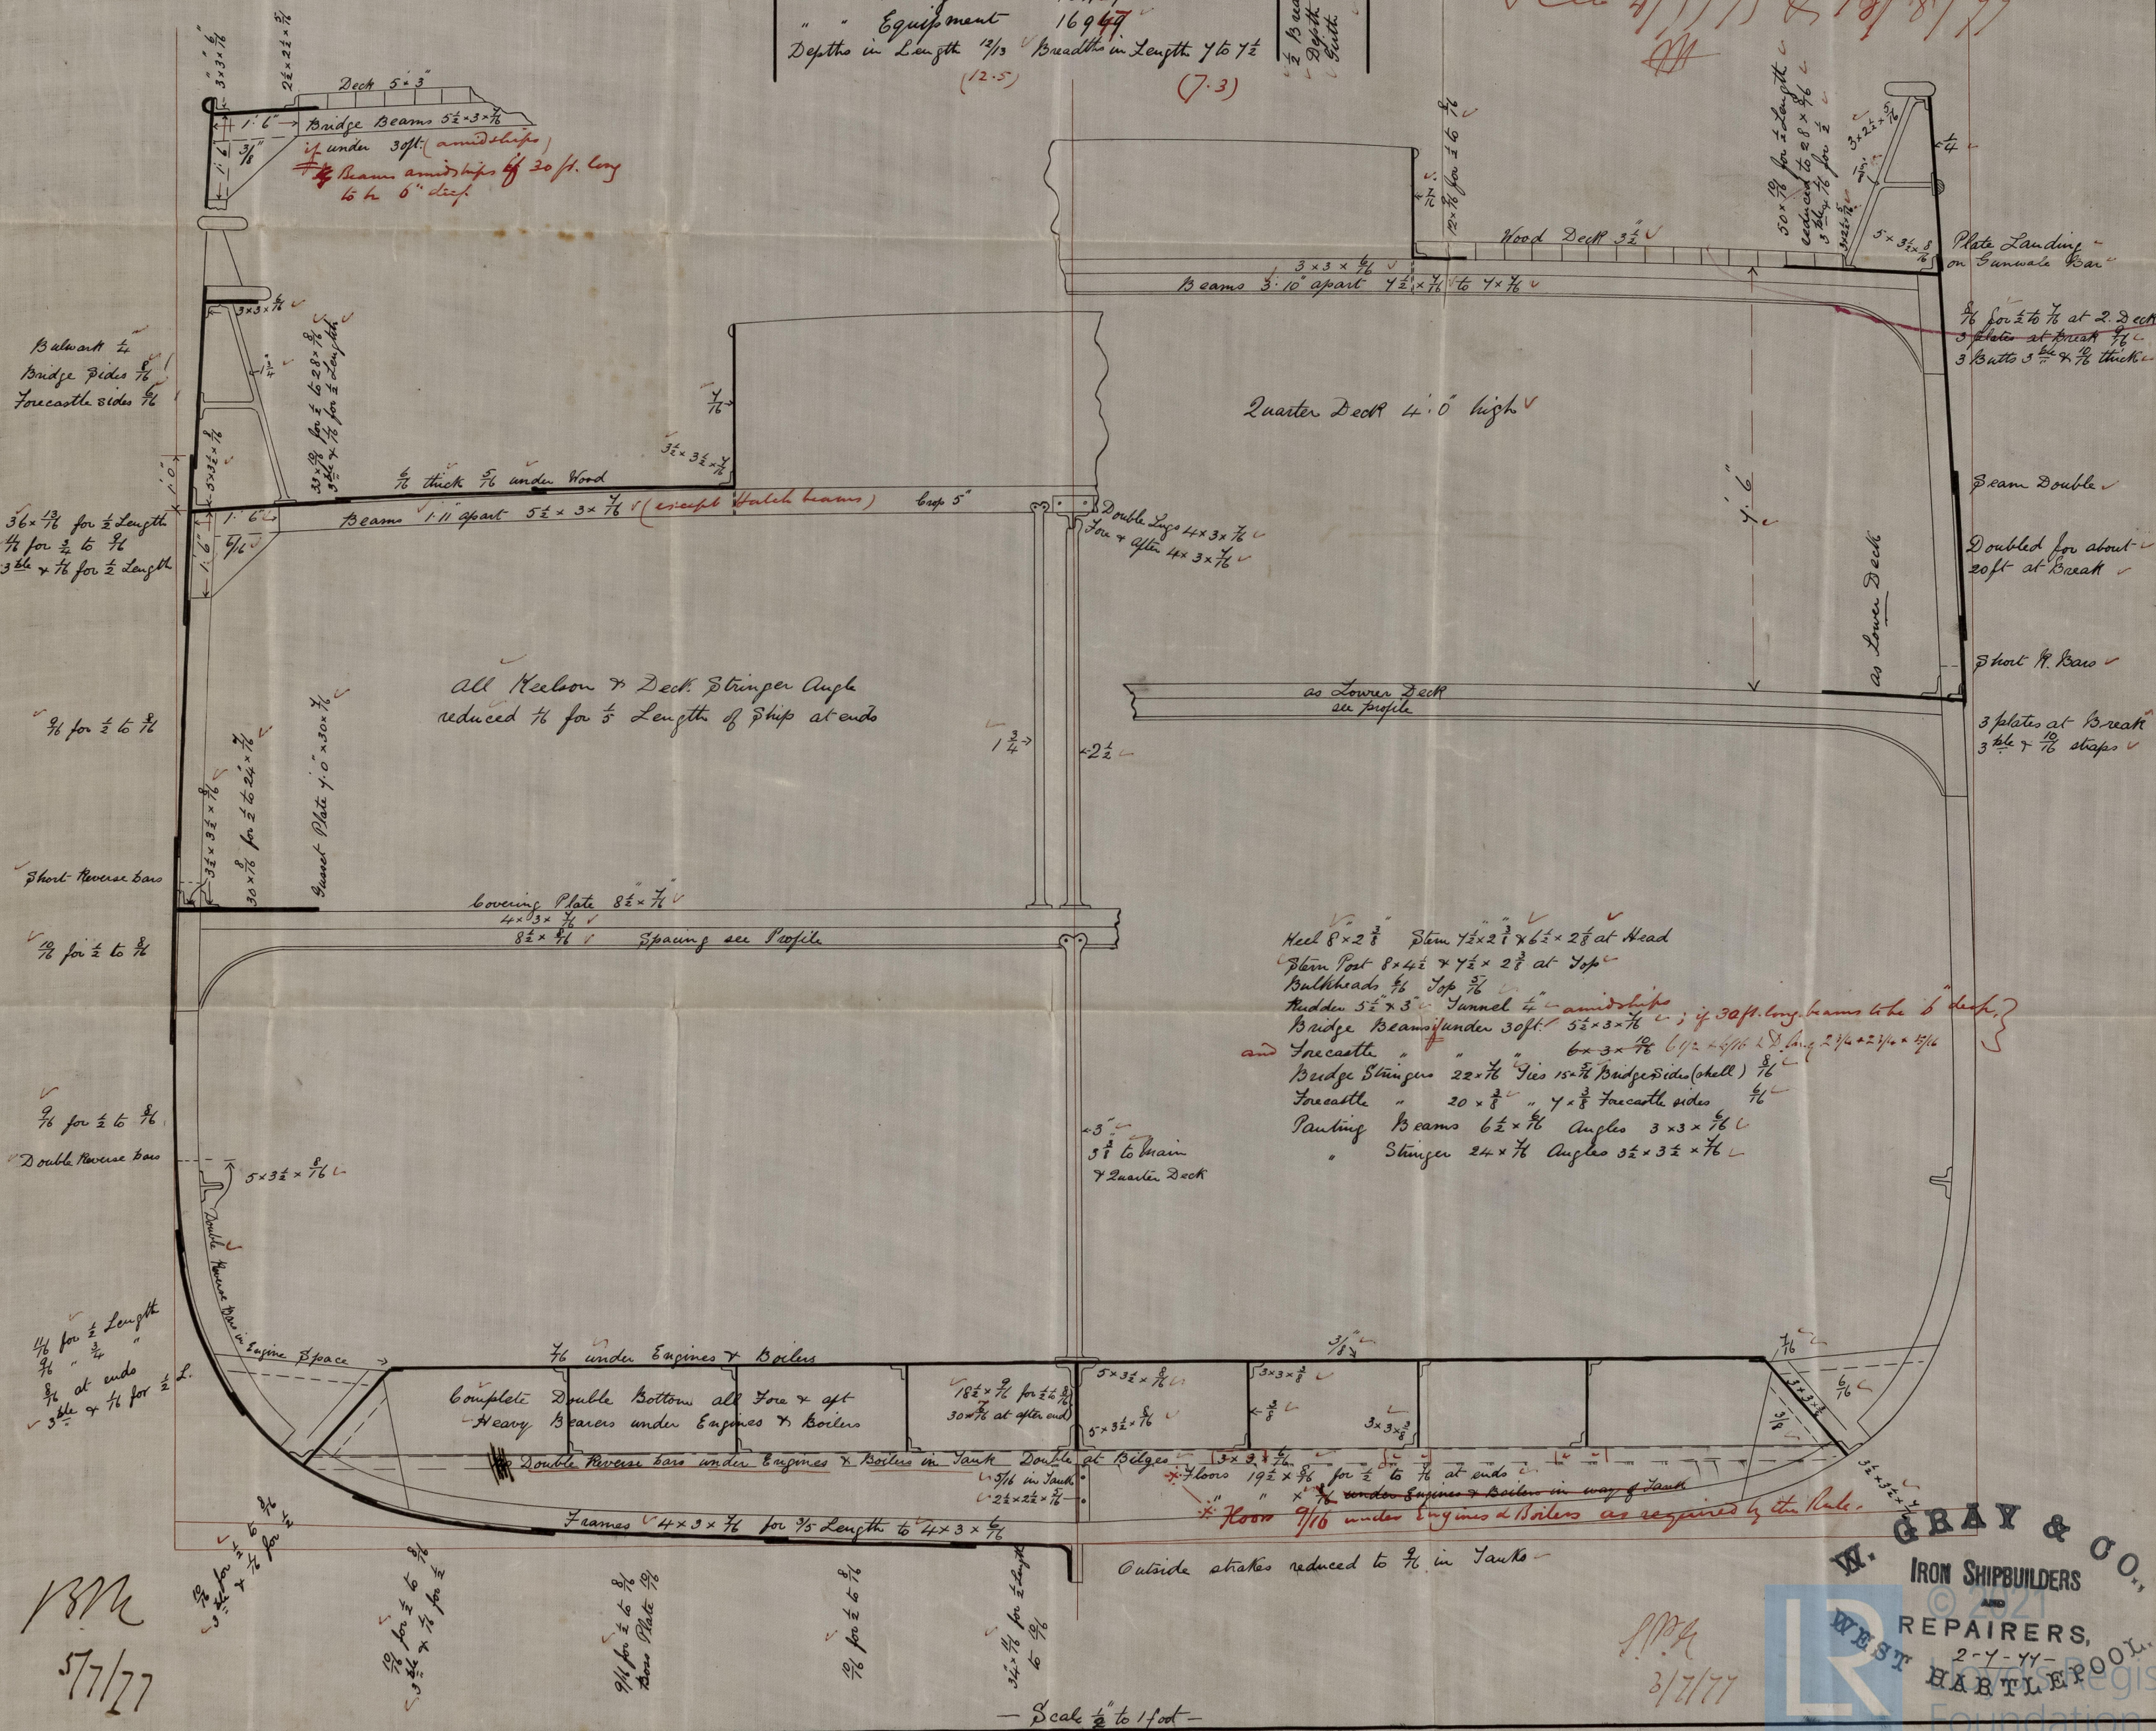

W. GRAY & CO.  
IRON SHIPBUILDERS  
REPAIRERS,  
2-Y-Y-Y-  
HARTLEPOOL

IRONSES-0126