


26.9.77

Report No. 3951

Rec 20/9/11 Under 12^v depths and 6^v1/2 breadths

Section thro Main Deck ✓

Section 2nd 2nd Deck

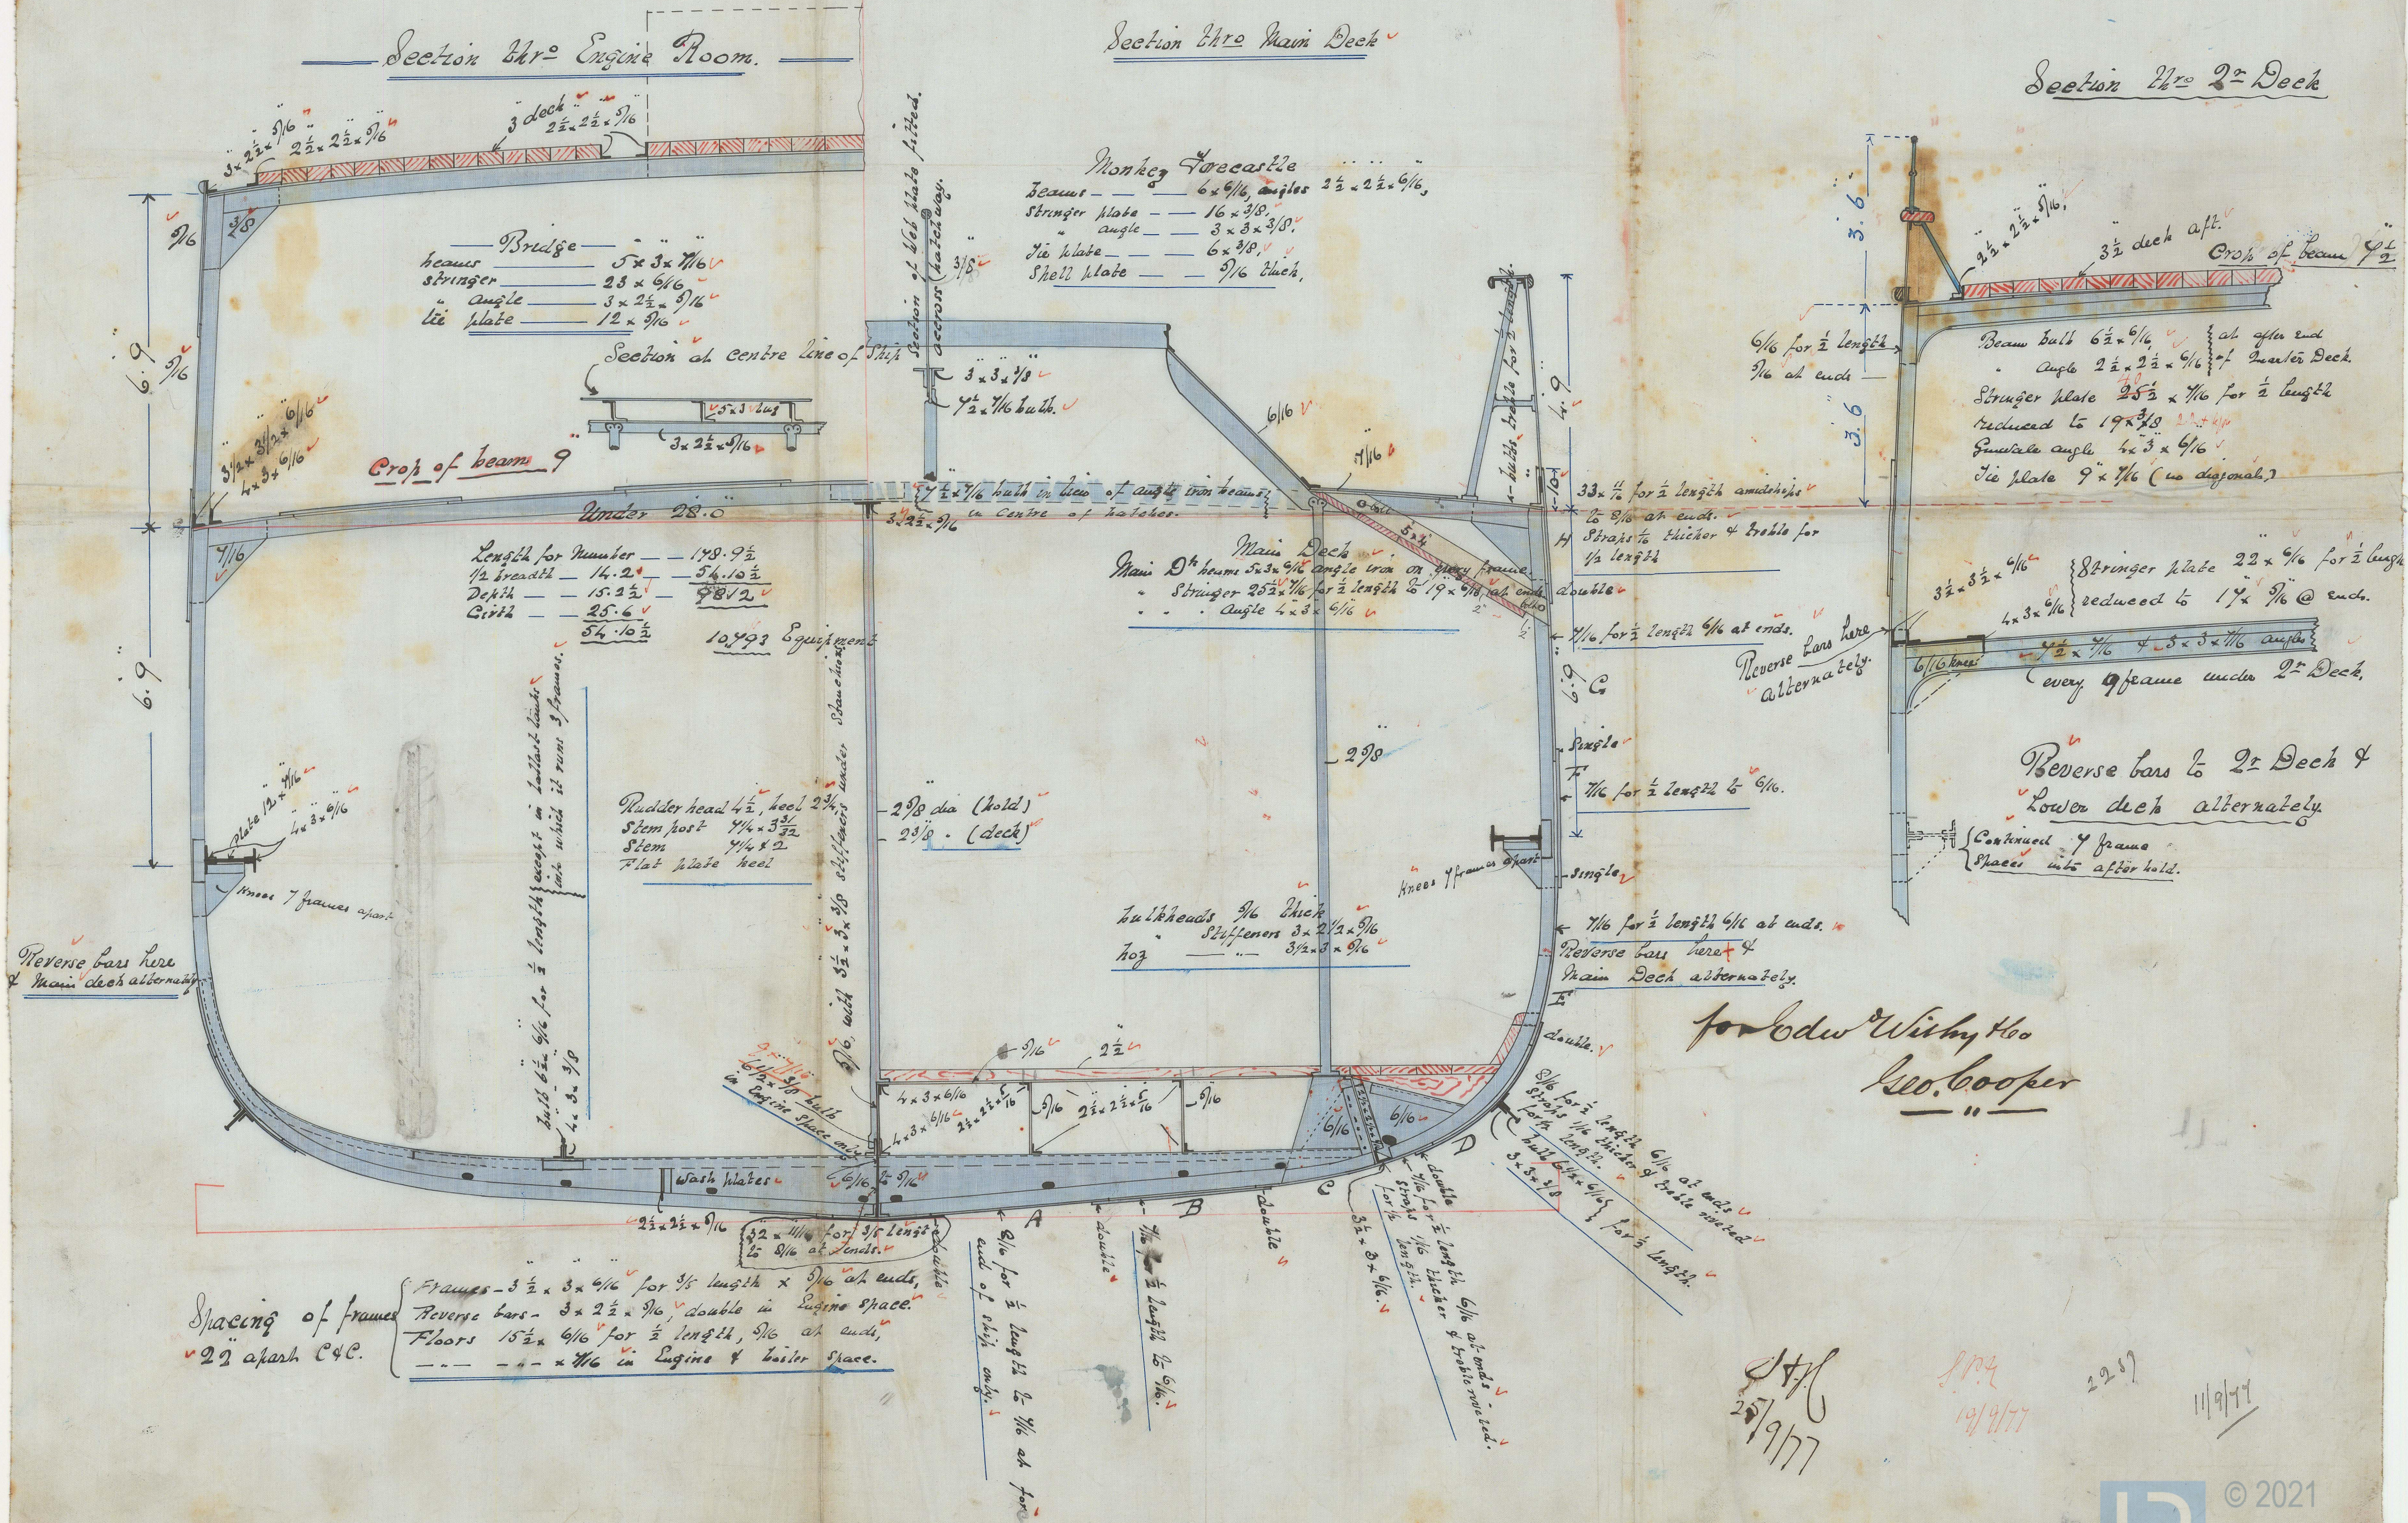

for Edw & Wilmy Hs
Geo. Cooper

25/9/77

1257

