




Ville-de-Paris

scale
40 millimetres to the metre

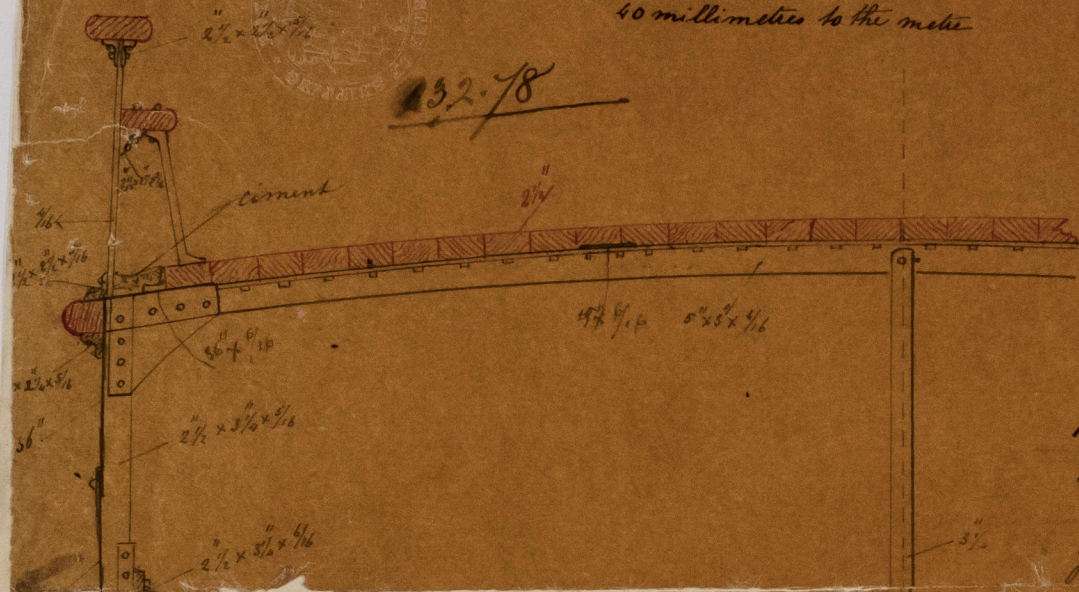

Dimensions

Half breadth, moulded ---- 9'-7 1/2"
Depth, from upper part of keel to
top of deck beams -- 8'-10 1/2"
Girth of half masts high frame 16'-2"
1st " " ---- 34'-8"
Length ---- 125'-0"
2nd " " ---- 4333
Breadth to Length -- 6, 4
Depth to do ---- 14, 14

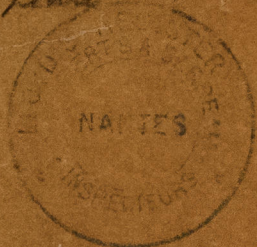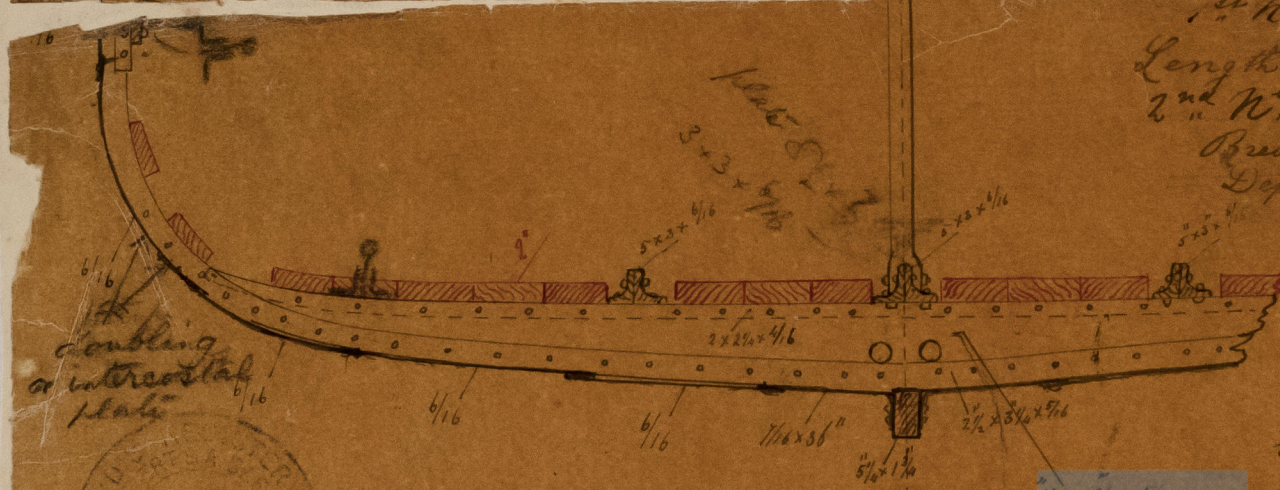


18 February 1878

Guilbert
for info

Lloyd's Register
Foundation

IRON 525-0165