


11.2 Depths in do — 11[✓], 12[✓]

19/11/77

Class 100 A

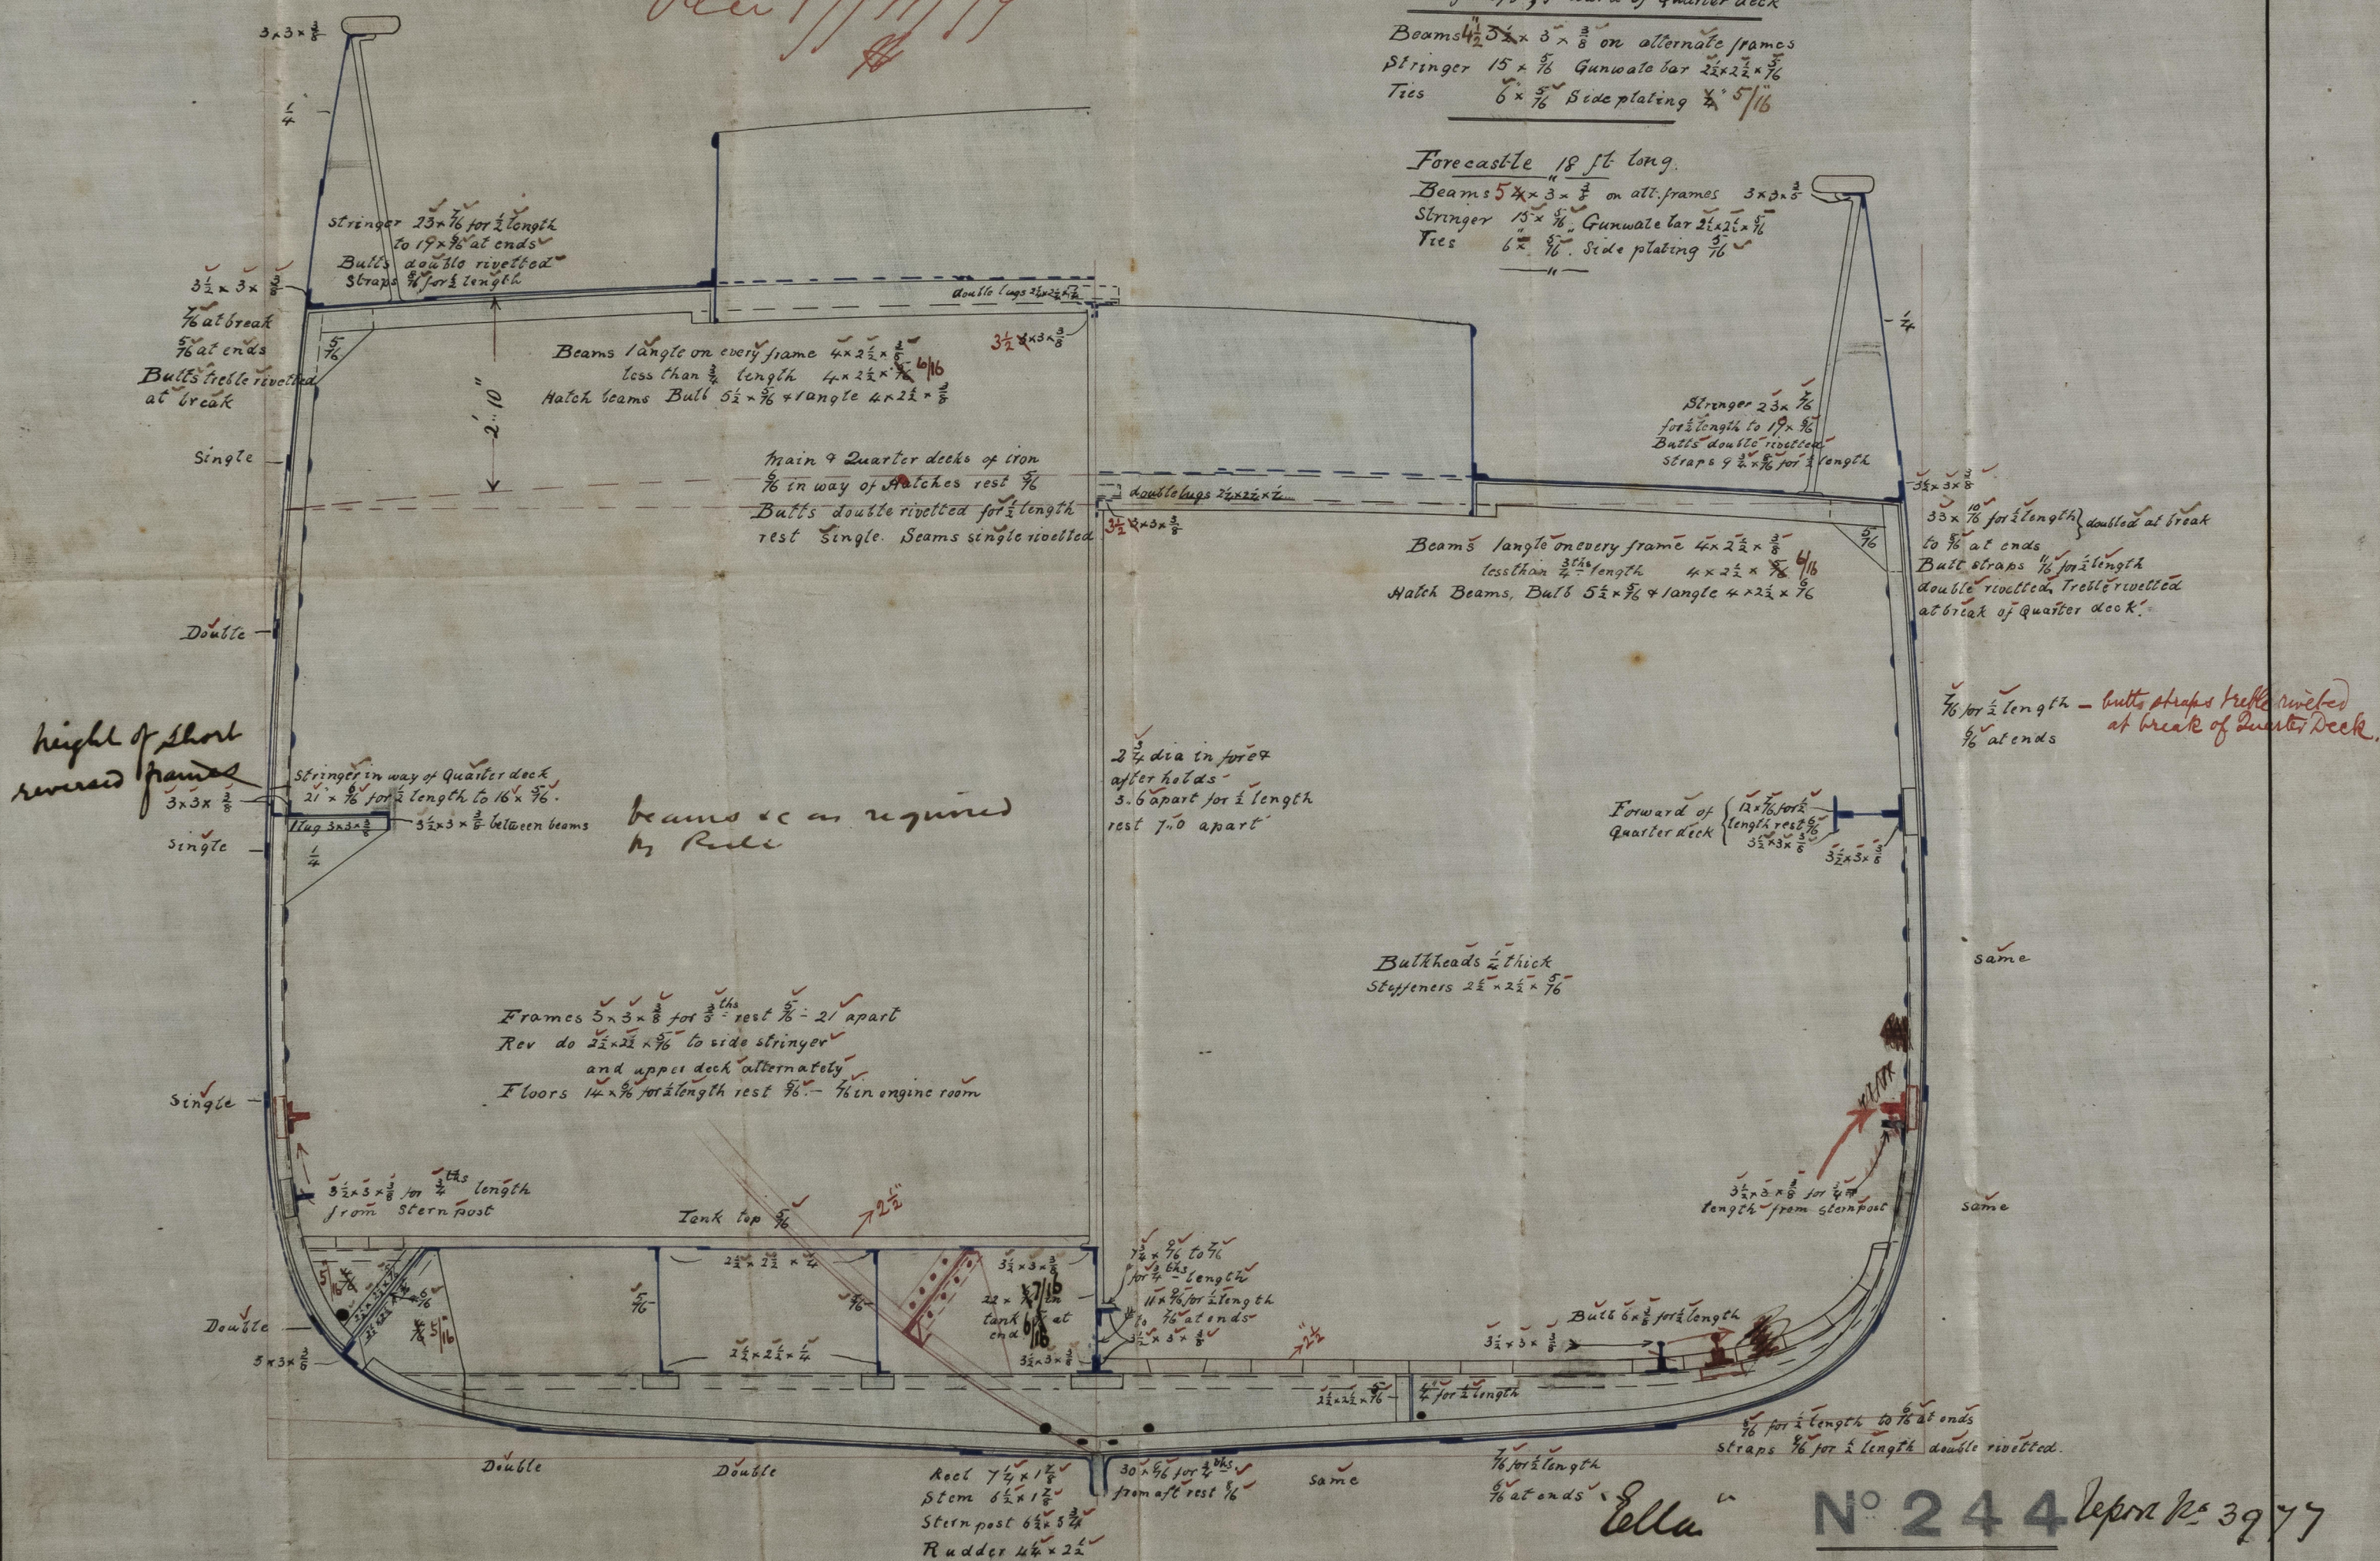

N^o 244 *Lepra No 3977*

Nov-13-181

16/11/77.

IRON 526-0017