


N<sup>o</sup> 244 "Ella" Report No 3977

SCALE - 1/4 INCH TO FOOT

Rev 17/11/77 R 3977/78  
 11/5

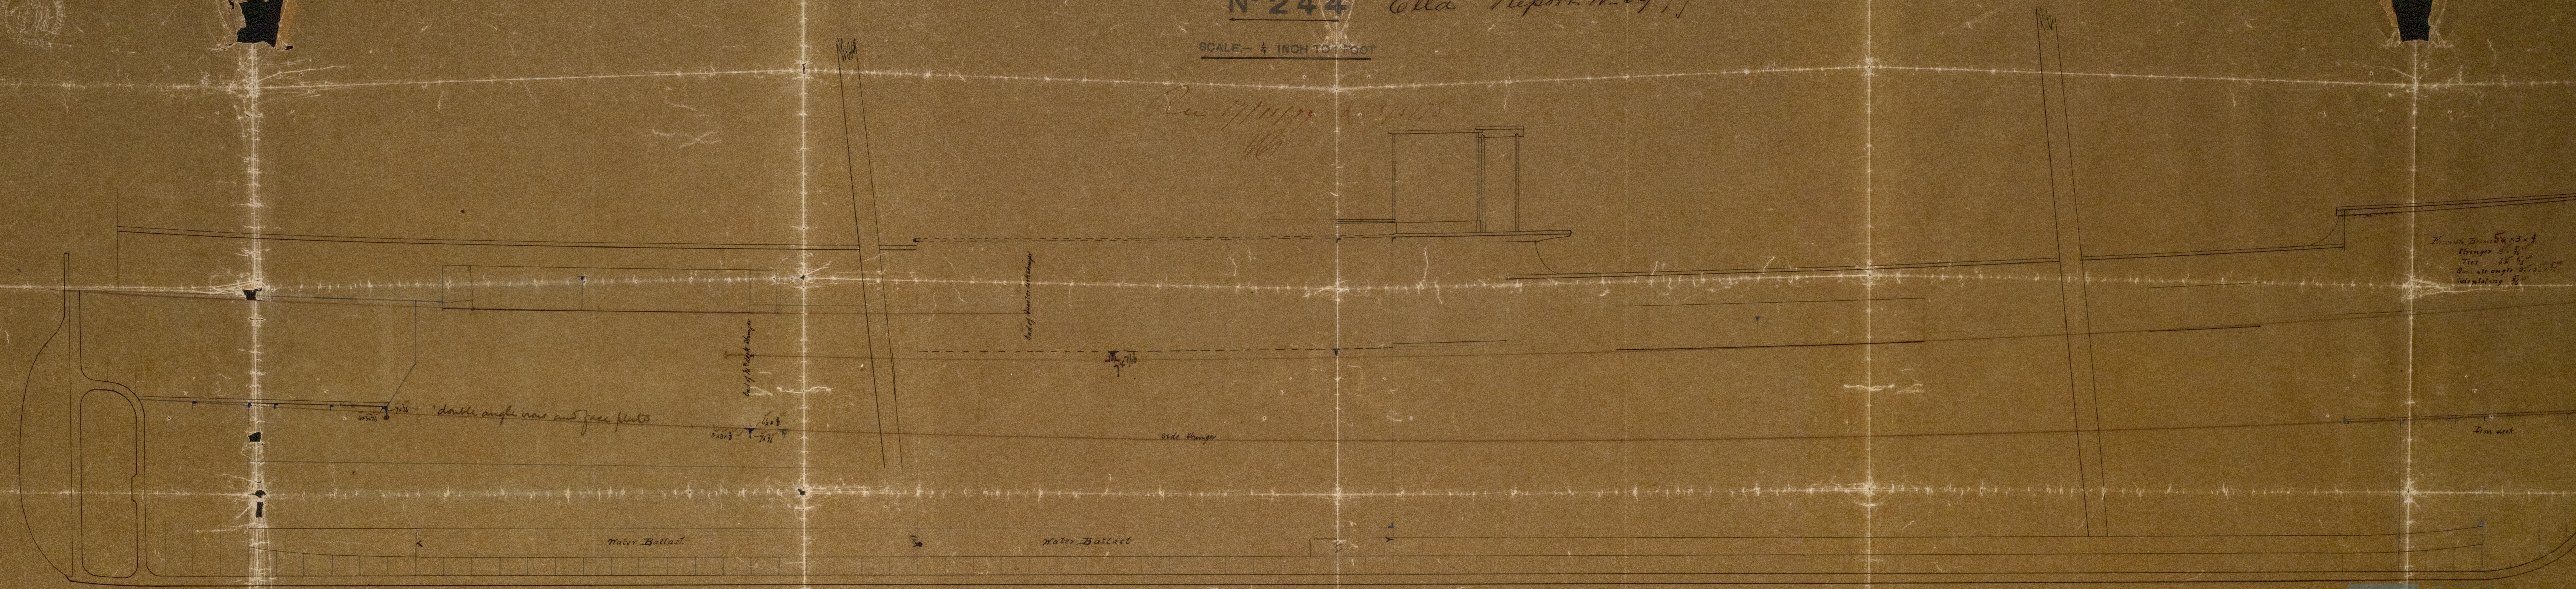

Transverse Beam 5 1/2 x 3  
 Stinger 10 x 4  
 Truss 10 x 4  
 Double angle 3 1/2 x 2 1/2  
 Side plating 1/2"

Iron deck

Water Ballast

Water Ballast

Side Stinger

double angle iron and face plate

End of transverse beam

End of transverse beam


IRONS26-0018



N° 244 "Ella" Report No 3977

SCALE - 1/4 INCH TO 1 FOOT

Run 17/11/77 to 25/1/78  
*W*

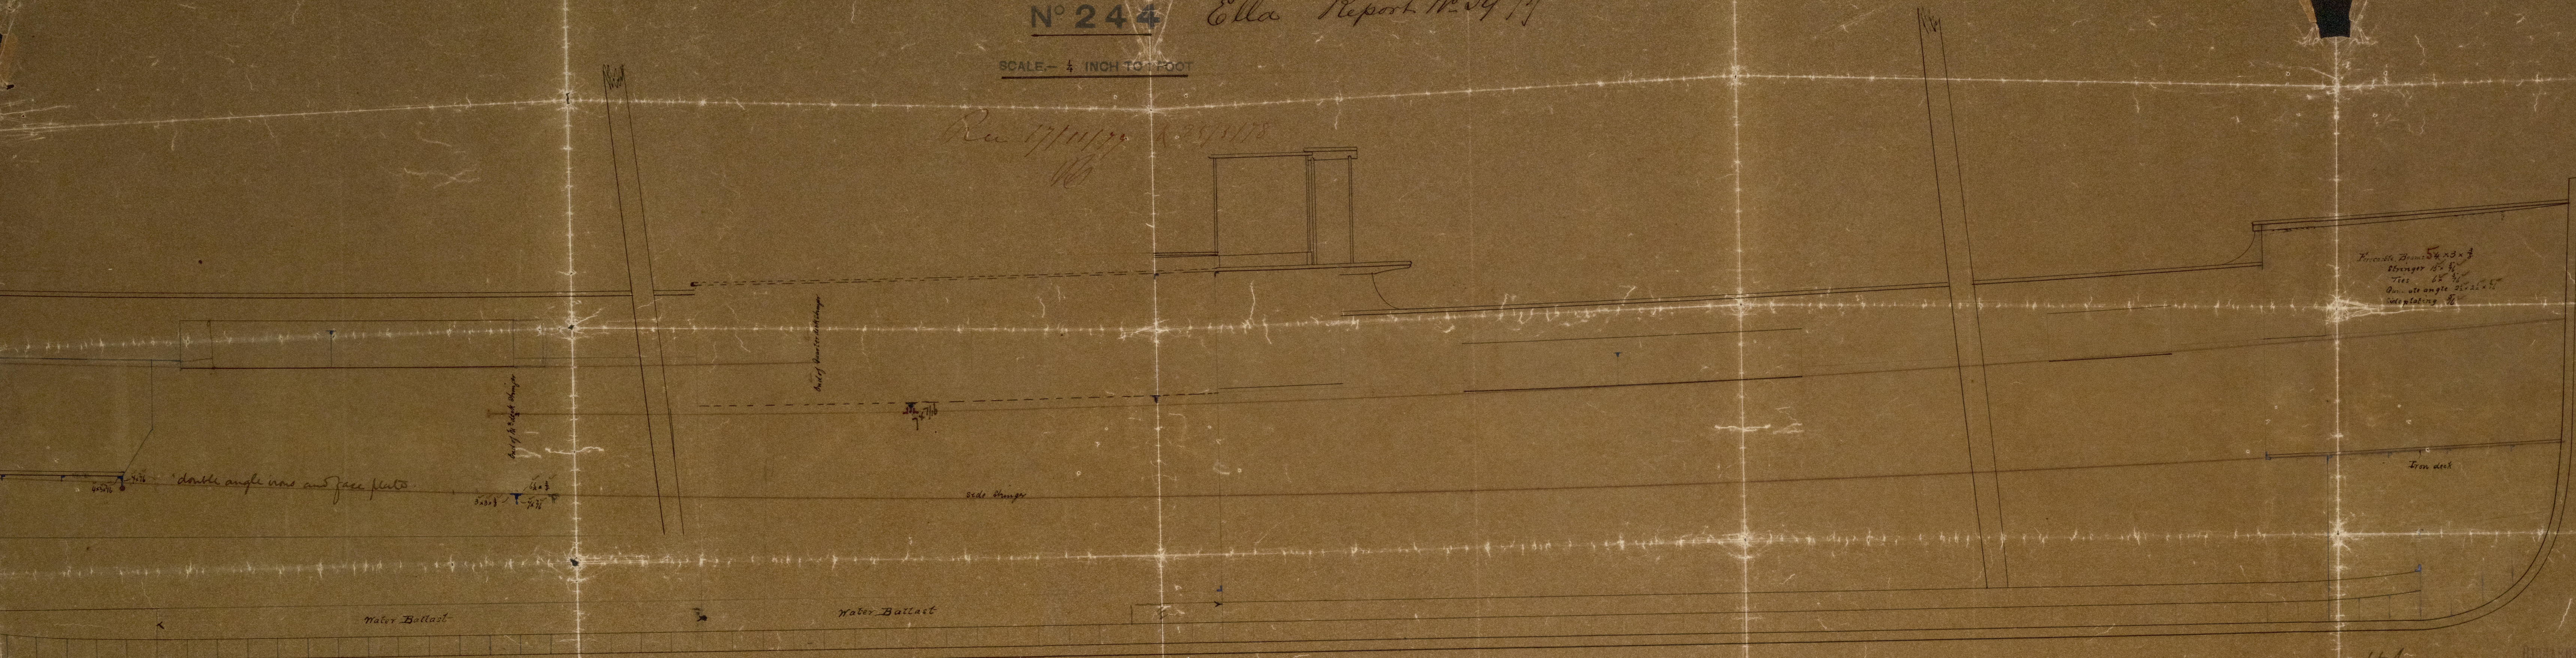

IRONS 26-0018

26/3/78  
 17/11/77  
 16/1/78