


Midship Section No 48 S.S. 12 inch Scale

Dimensions in
Length . . . 213' 9"
breadth on frame . . . 29' 10"
Depth to floor . . . 15' 2 1/2"

JOHN B. FALCONER & CO.
Shipbuilders
SUNDERLAND

July 21/77
W. Matthews

Rec 22/8/77 & 30/8/77

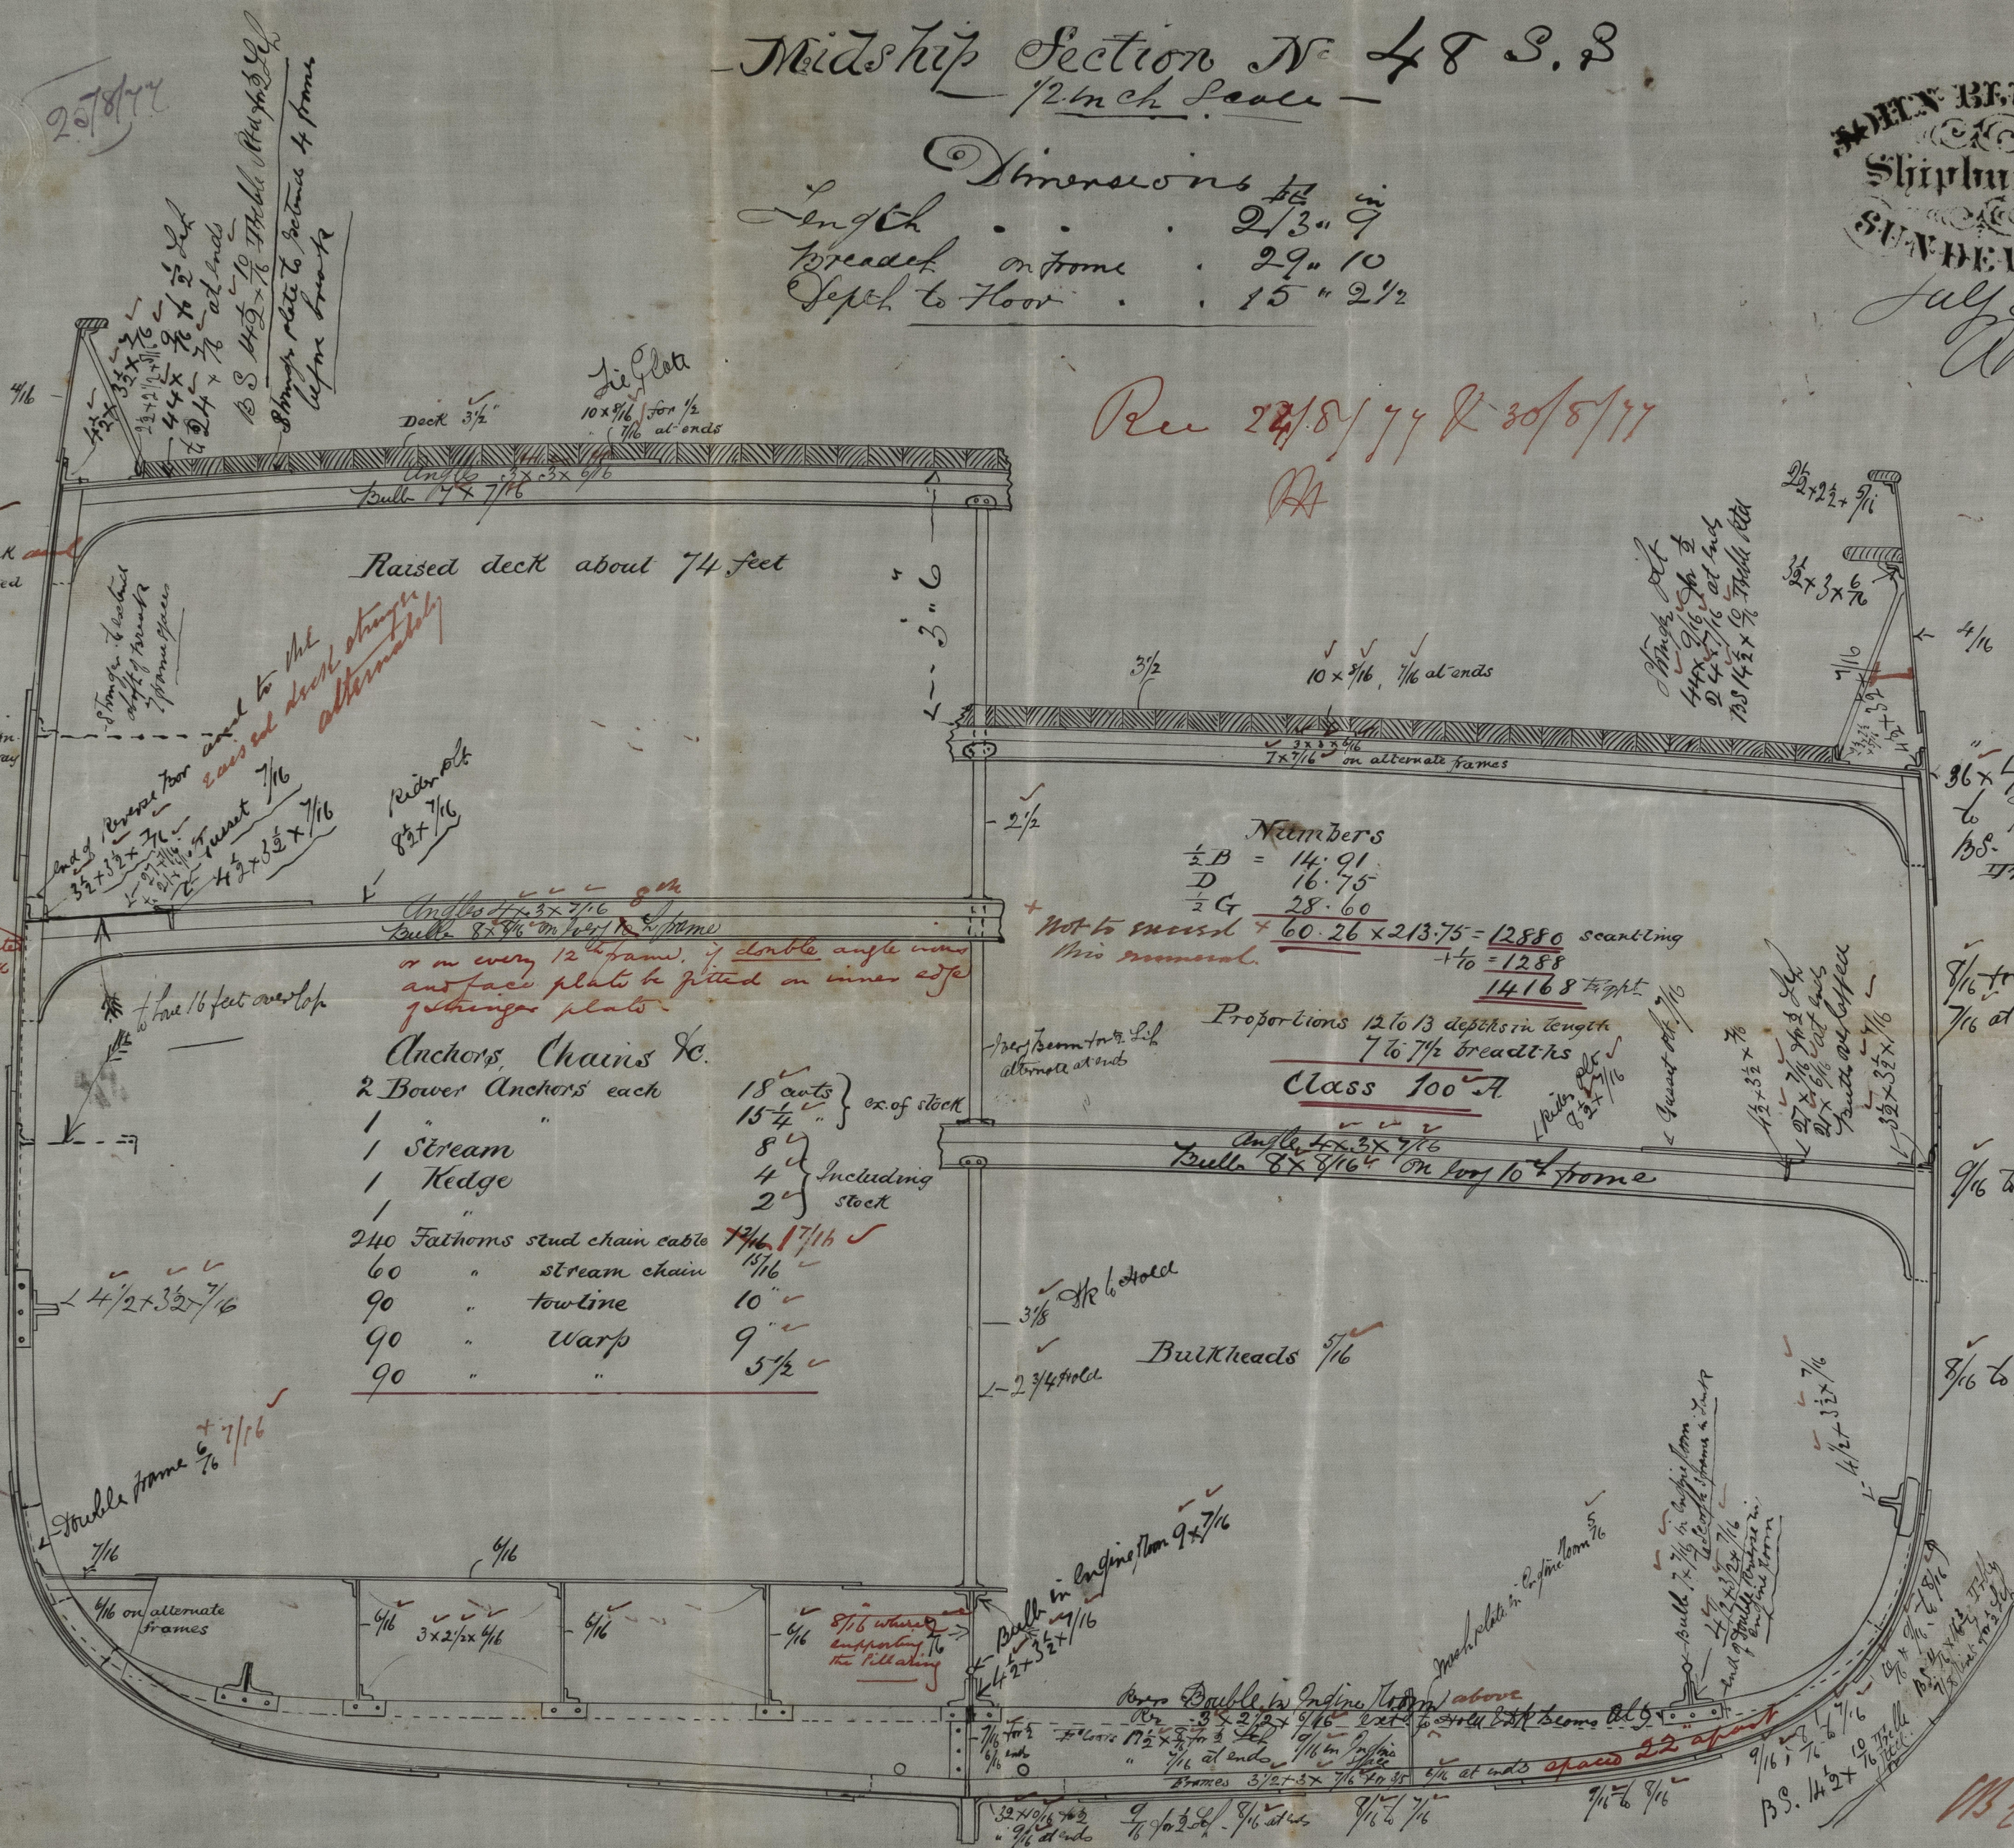

before + after
Treble riveted
at break

Sheel stroke on
exposed 7/16 in way
of break
Treble riveted
at break

End of Bower bar
32 x 32 x 7/16
4 1/2 x 3 1/2 x 7/16
4 1/2 x 3 1/2 x 7/16
Raised deck
8 1/2 x 7/16

- Anchors, Chains &c.**
- 2 Bower Anchors each 18 auts } ex of stock
 - 1 Stream " 15 1/4 " }
 - 1 Kedge 8 " }
 - 1 " 4 " }
 - 1 " 2 " }
 - 240 Fathoms stud chain cable 7 1/2 x 7/16 ✓
 - 60 " stream chain 1 1/2 " ✓
 - 90 " towline 10 " ✓
 - 90 " warp 9 " ✓
 - 90 " " 5 1/2 " ✓

Numbers
1/2 B = 14.91
D = 16.75
1/2 G = 28.60
Not to exceed + 60.26 x 213.75 = 12880 scantling
+ 1/2 = 1288
14168 to right

Proportions 12 to 13 depths in length
7 to 7 1/2 breadths
Class 100 A

Bulkhead 8 x 7/16" on top to frame

Bulkheads 7/16"

36 x 12 Jut Lk
6 7/16 at ends
135 16 1/2 x 13 1/2 Jut Lk
Treble Riv

7/16 to 1/2
7/16 at ends

9/16 to 7/16

8/16 to 7/16

Keel 8 x 2 3/4
Stem 7 x 2 3/4
Bower Stem Post 4 x 4 3/4
Rudder Head 5
Hull 3

All landing edges
Double Riveted

MS 23/8 77