


Iron S. S. Beech Report No. 11.928.

Dimensions		ft	in
Length		228	9
Breadth		31	10
Depth to floor		17	0


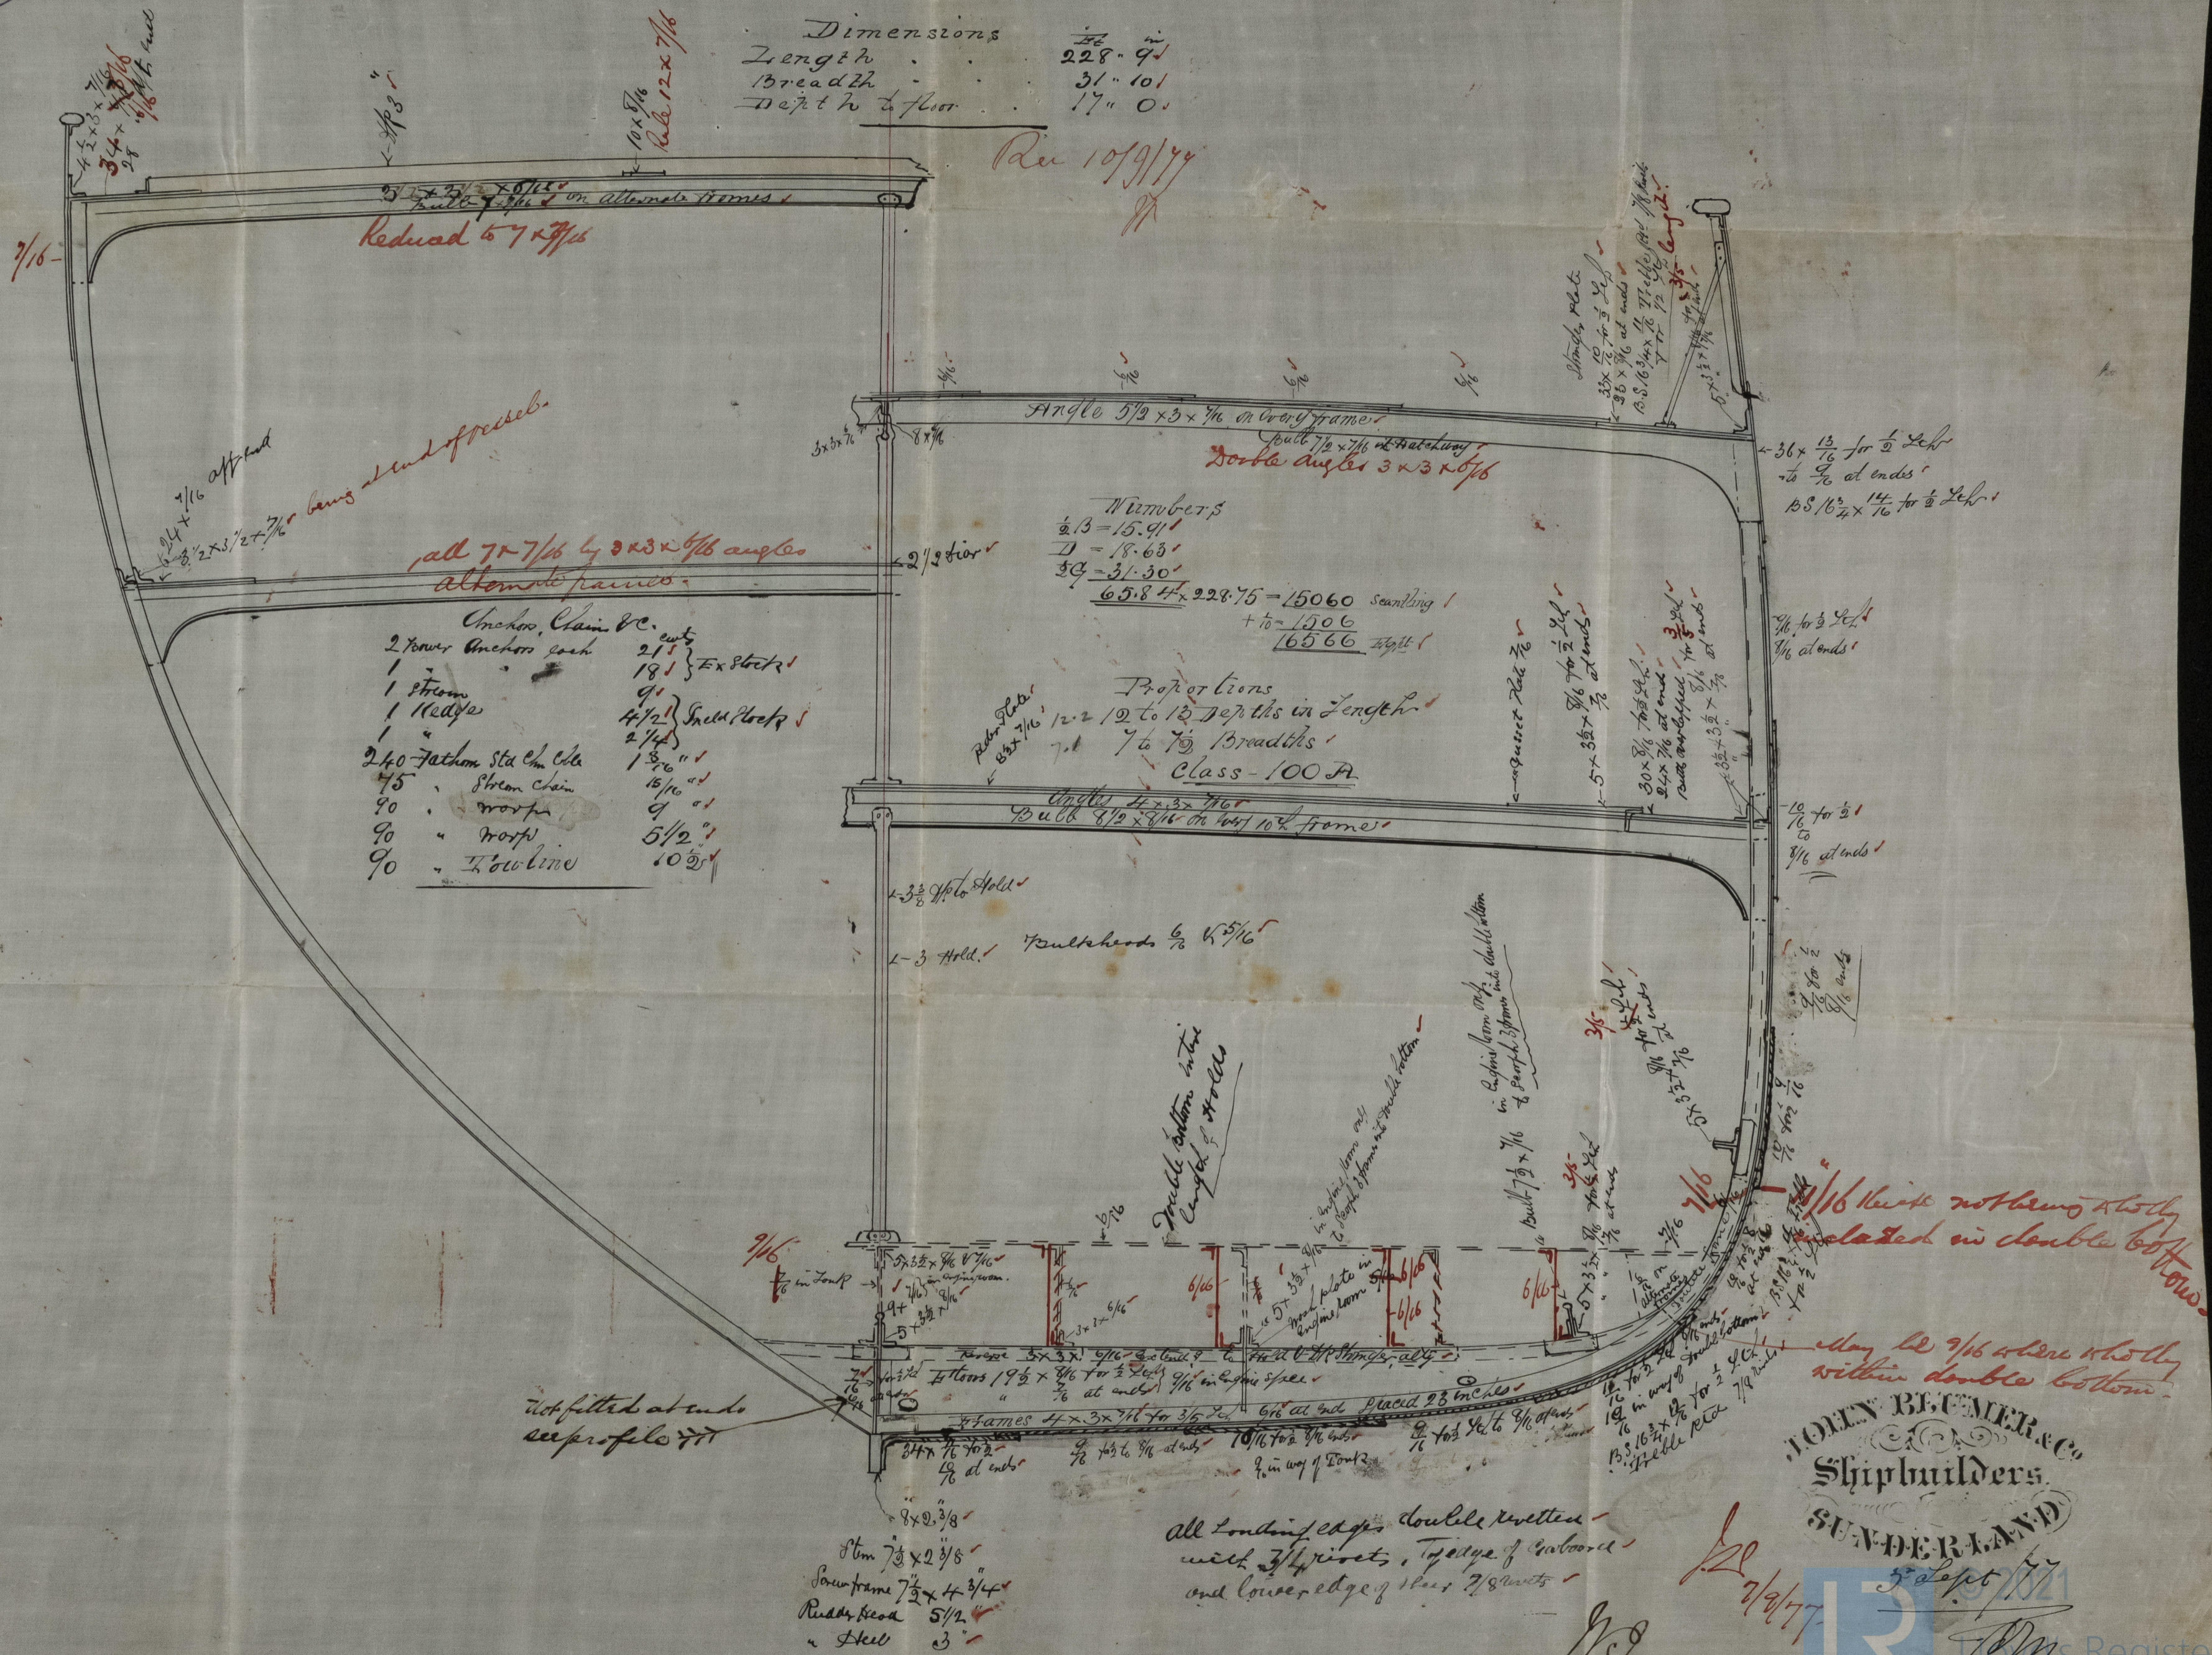


IRONS26-0154

IRONS 26-0154