

December 22nd
1876

S. S. "Barcelona"
Dundee Rept. No. 4143.

MIDSHIP SECTION.


"S.S." No. 81.

SCALE $\frac{1}{2}$ IN = 1 FOOT.

Rev. 28/12/76 & 15/8/77 & 4/3/98
Dimensions


Length of Keel & Foreake 284'-0"
Breadth Moulded 34'-0"
Depth 25'-7"
in Hold (to top of ceiling) 24'-1 1/2"

28/12/76
4.3.98

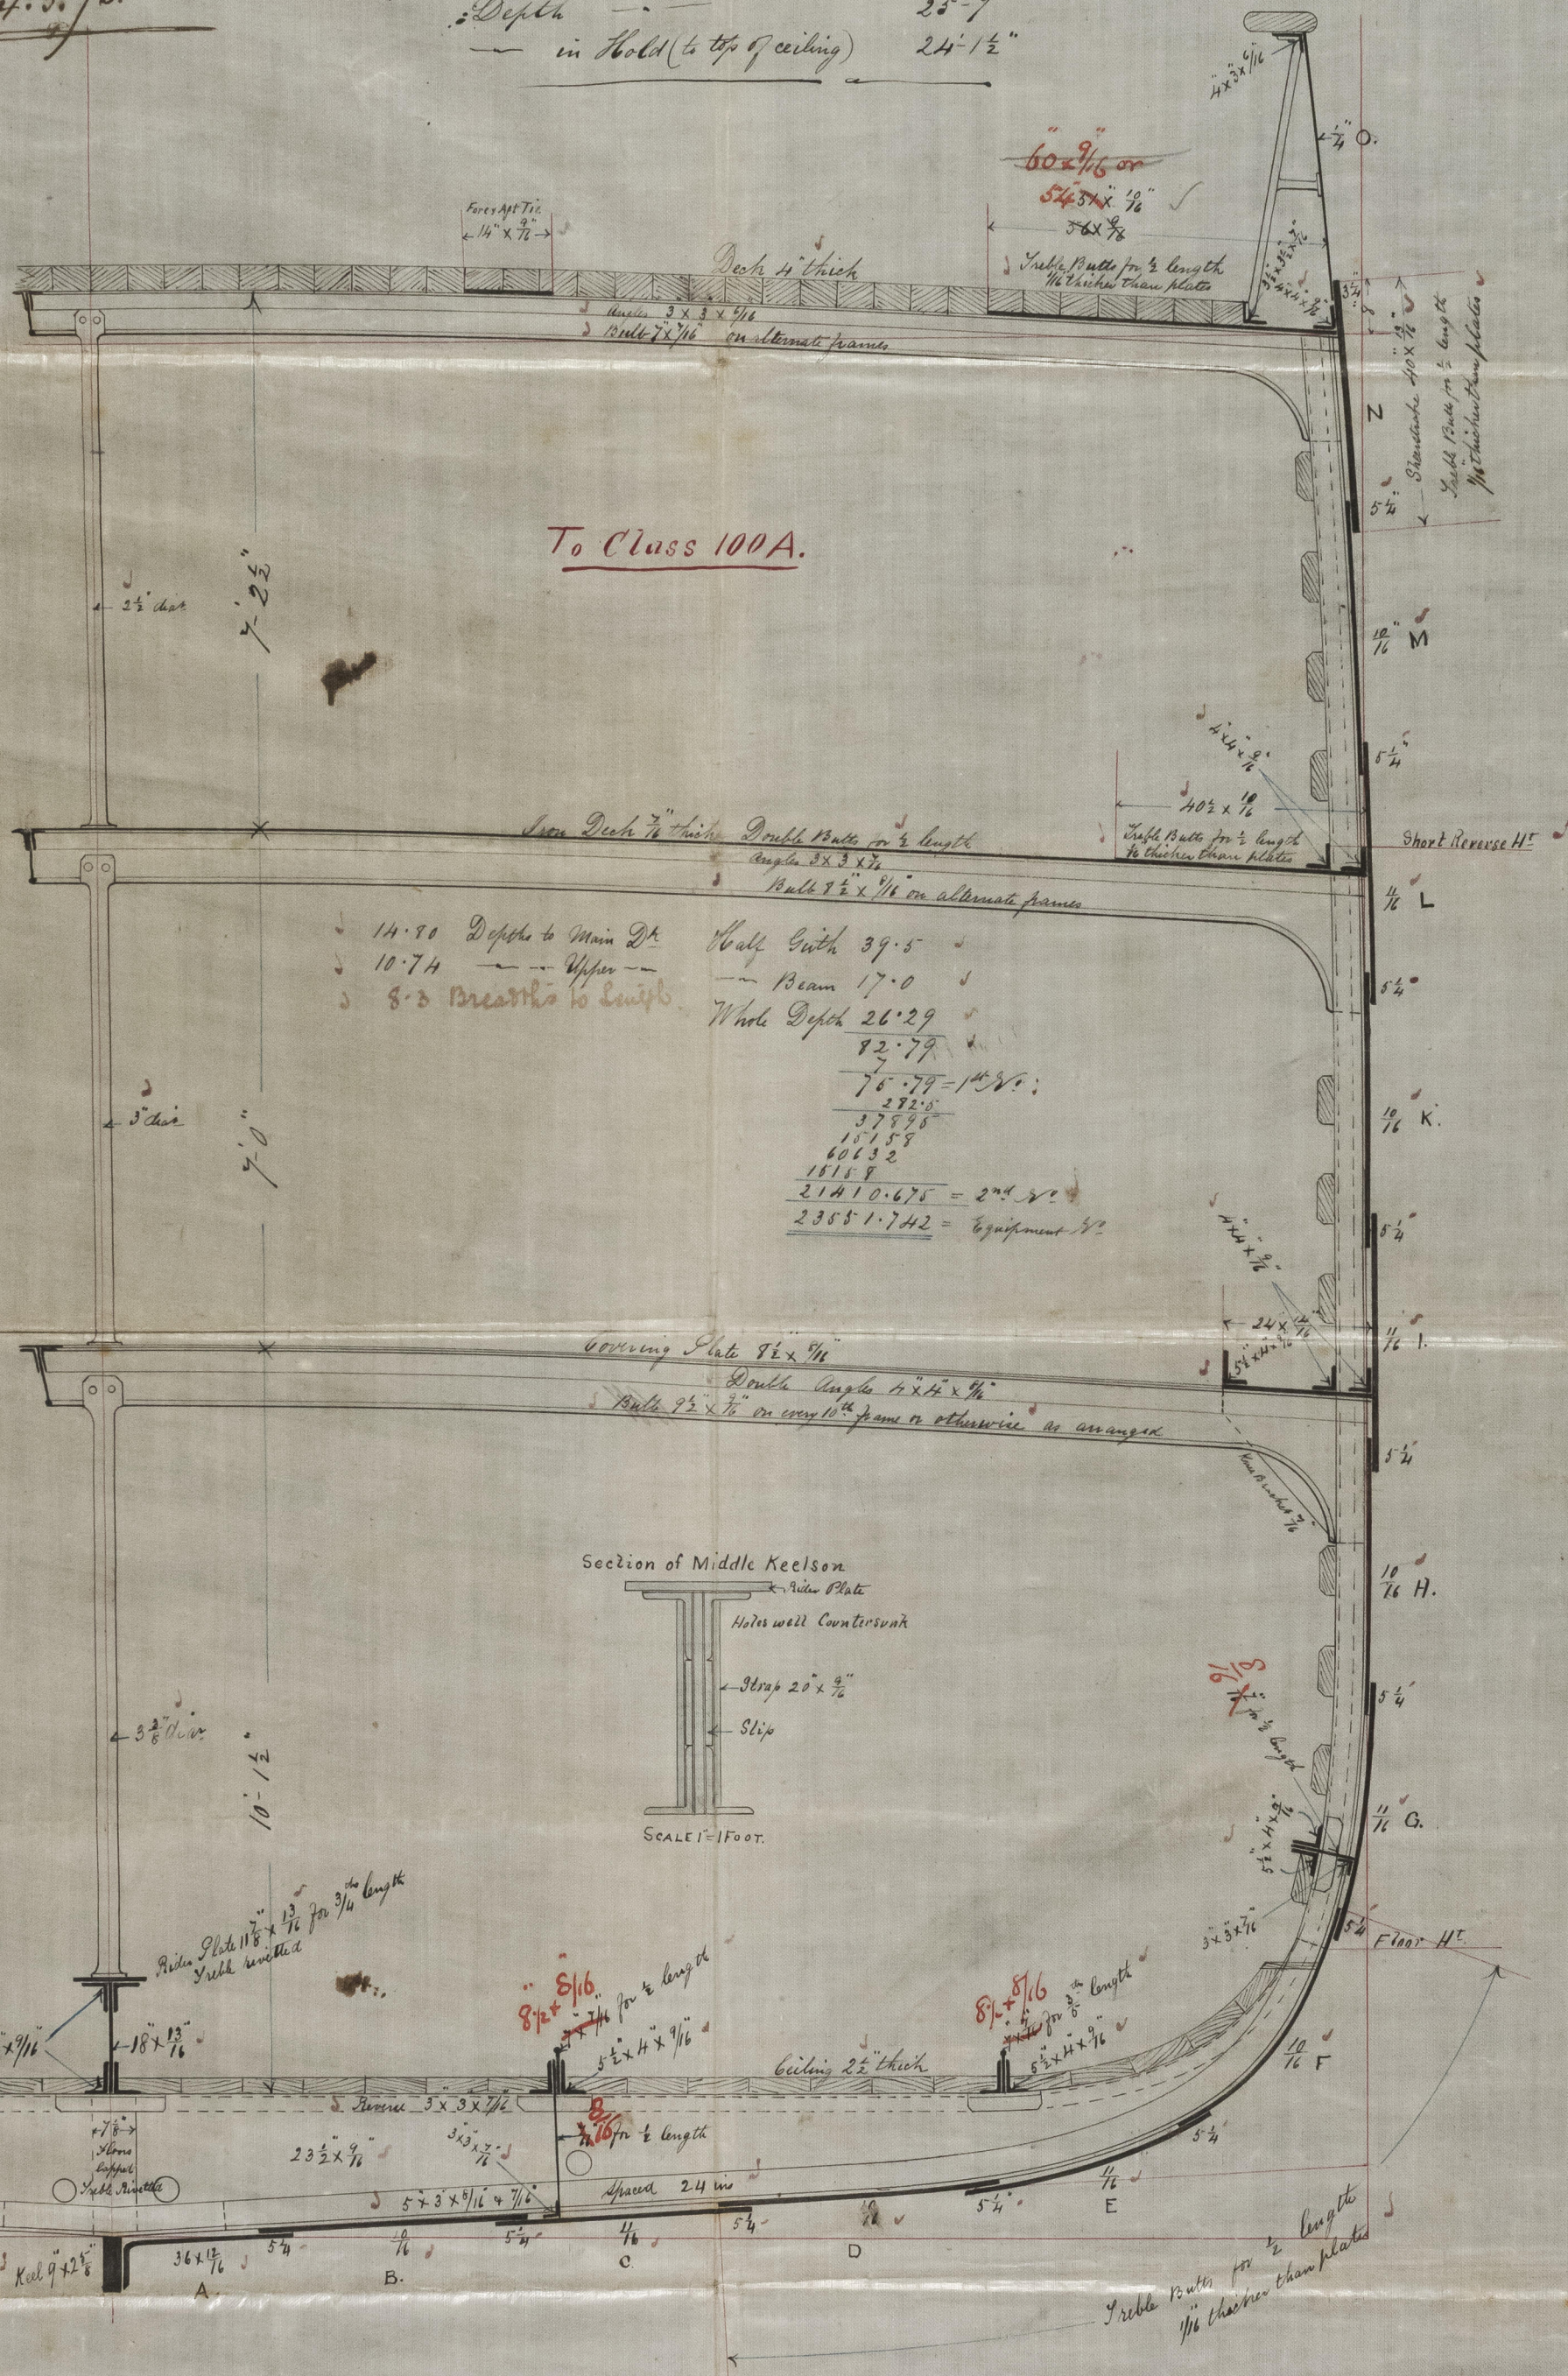

SECTION AT PARTIAL DOUBLE BOTTOM.

FRAME 93

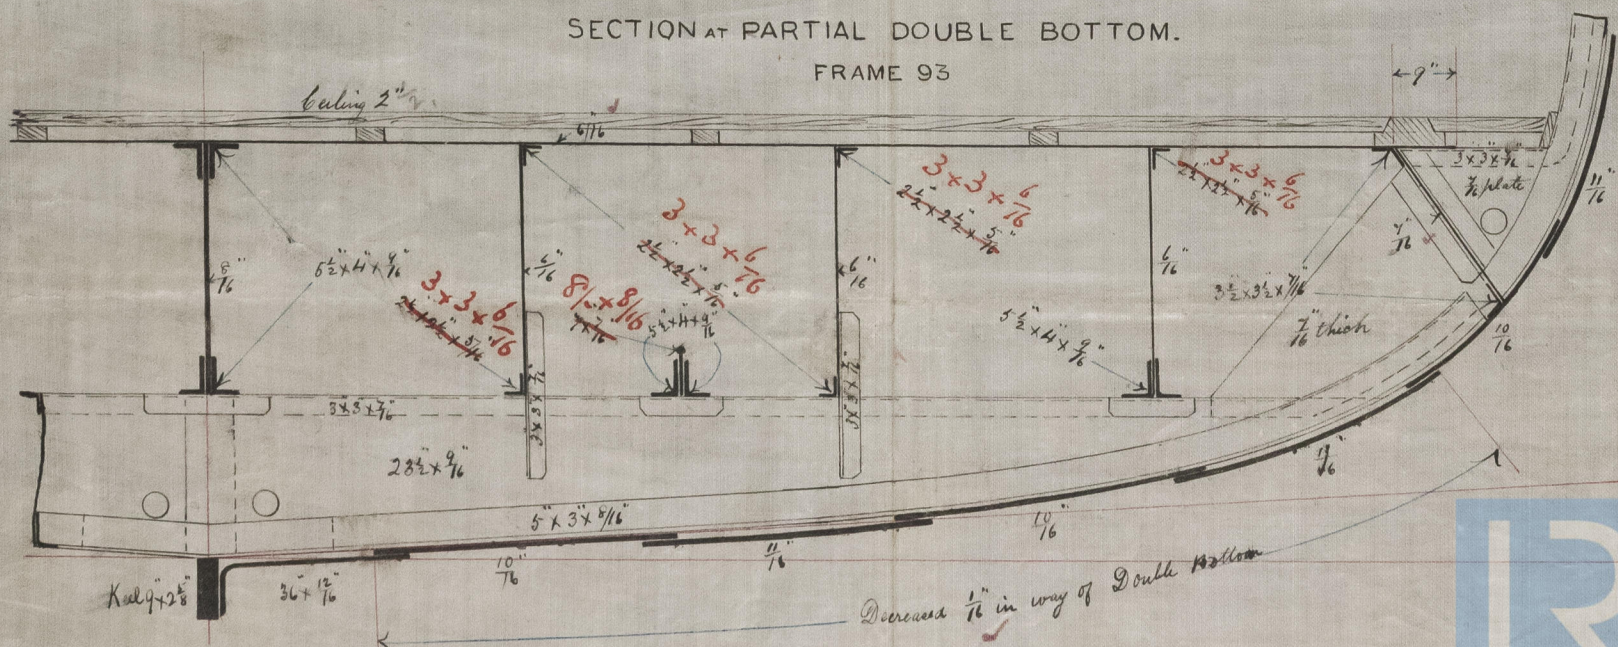

28/12/76
22/8.5.78.
L.R. Register
Foundation

IRON 527 0017