

S.S. Effective
Report No 11.933

8.12


Sketch of Masts for SS No 86

For Auxiliary purposes.

Schooner rigged with square sails on foremast.

Rev 7/3/78

Length 71.0 overall. ✓

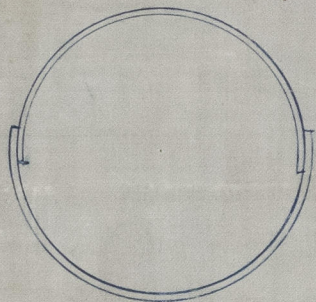

Partners

Heel

Round

Head

Dia^r 24 $\frac{1}{2}$ ✓ —

18 ✓ —

19 ✓ —

16 ✓

Thick 6/16 ✓ —

5/16 ✓ —

5/16 ✓ —

5/16 ✓

Seams double rivetted ✓

Butts all battens with straps 7/16th keelson ✓

Doubled for 8 feet at partners ✓ & doubled at heel ✓

Cheek plates 8/16 ✓ angles 4 $\frac{1}{2}$ x 3 x 8/16 ✓

SUNDERLAND. Butt Straps all fitted on outside of masts. ✓

4/3/78

Recd 6th March 78. M.

IRON 527-0028

Lloyd's Register
Foundation