


Rec 30/8/77  
HA

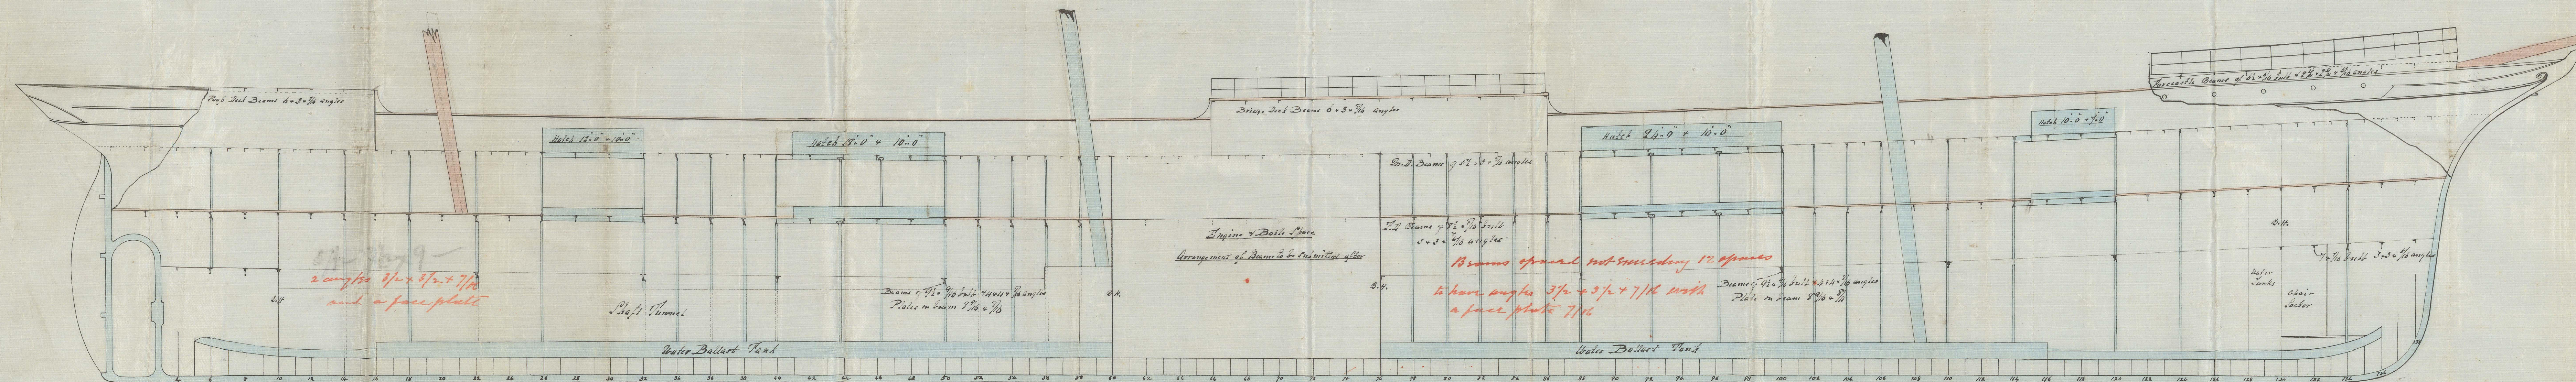

— Scale 5 inch to foot —

VB 29/877