19/3/77

Sketch shewing Stiengthening Amidships

S.S. No 197.

Scale 1/8 = 1 foot.

S.S. Alsatian

Rec 17/3/77

Satisfactory Report to No 4649

Profile

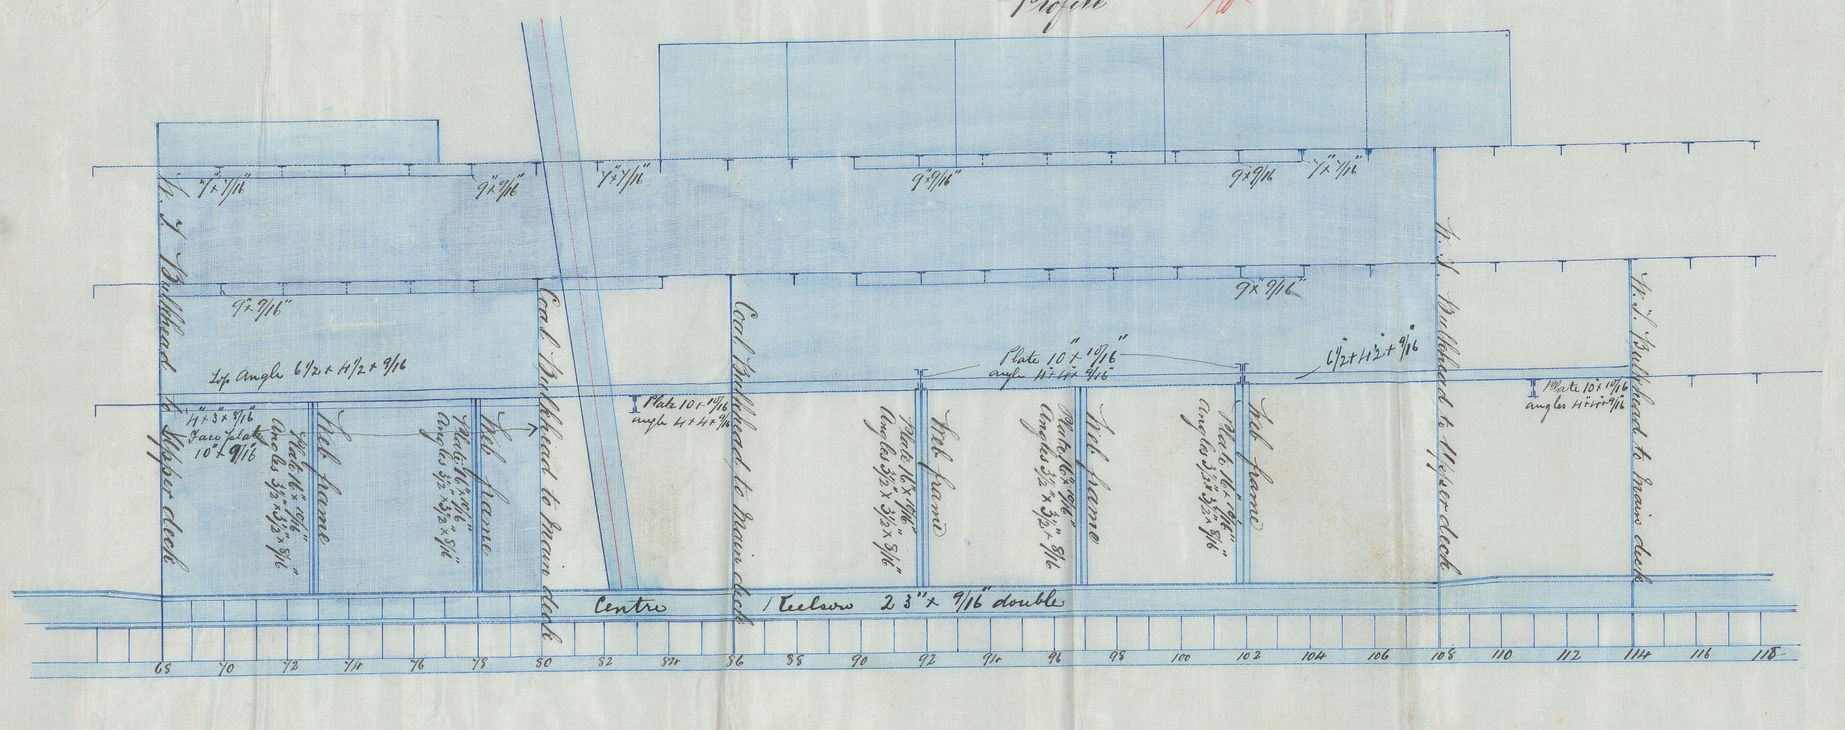

Lower Deck Plan.

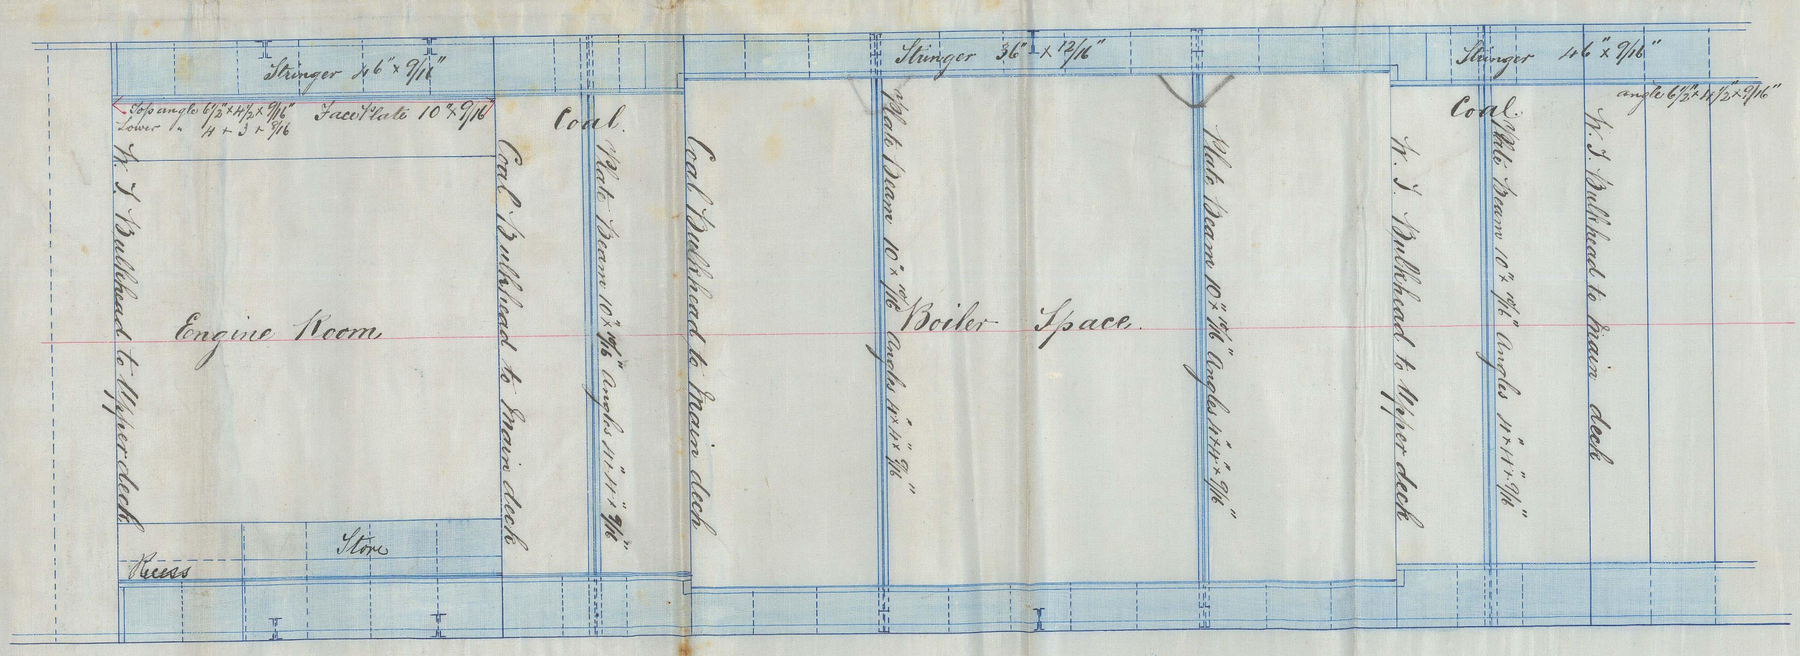

Main-deck Plan.

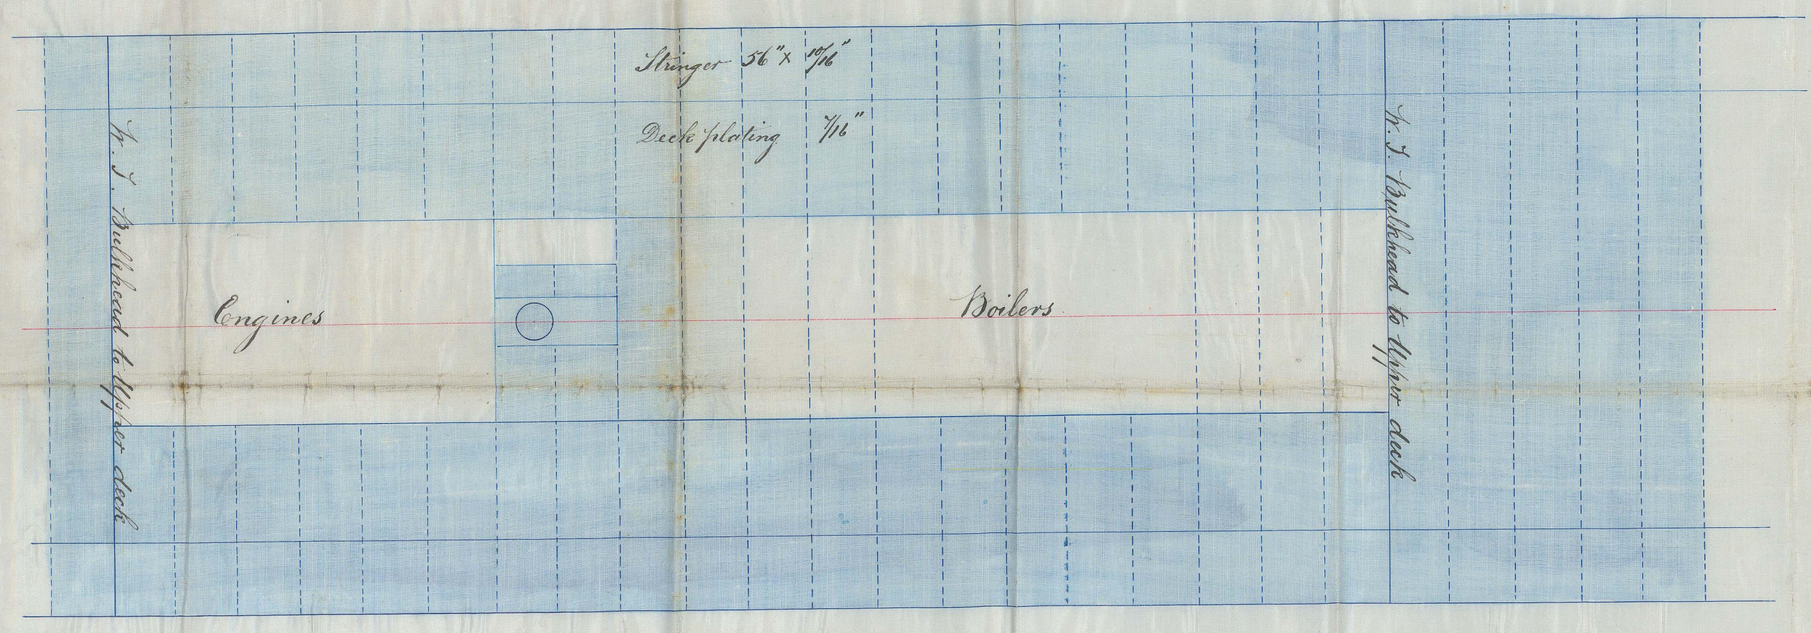

Upper-deck Plan.

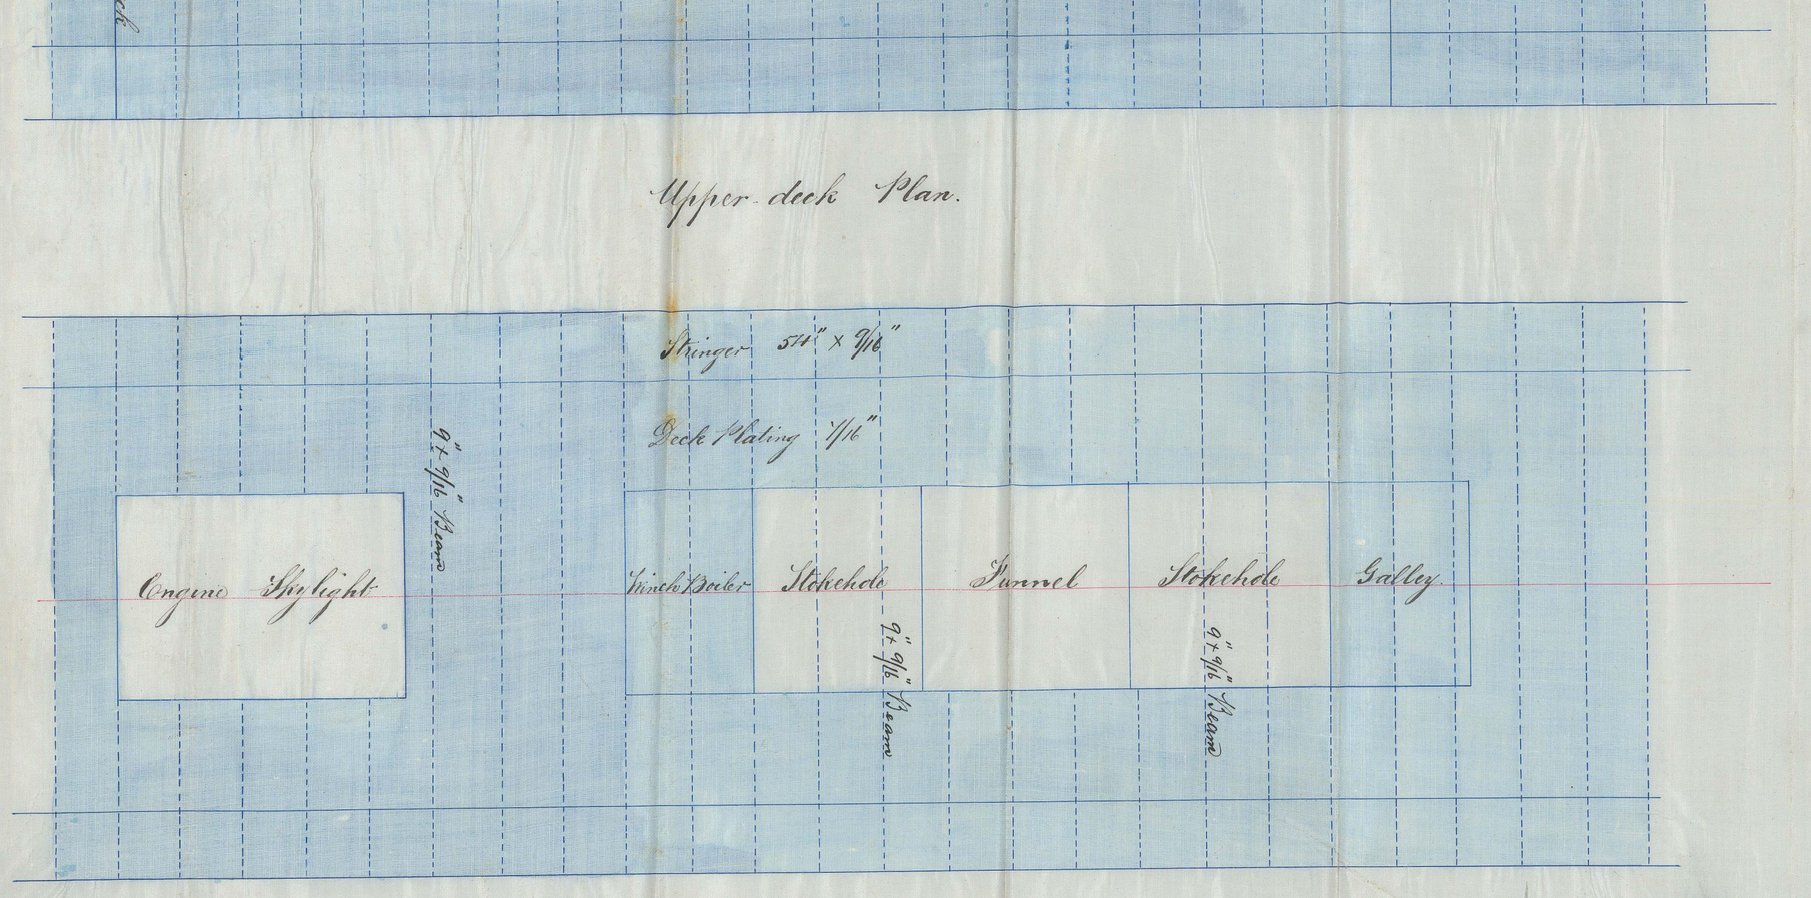

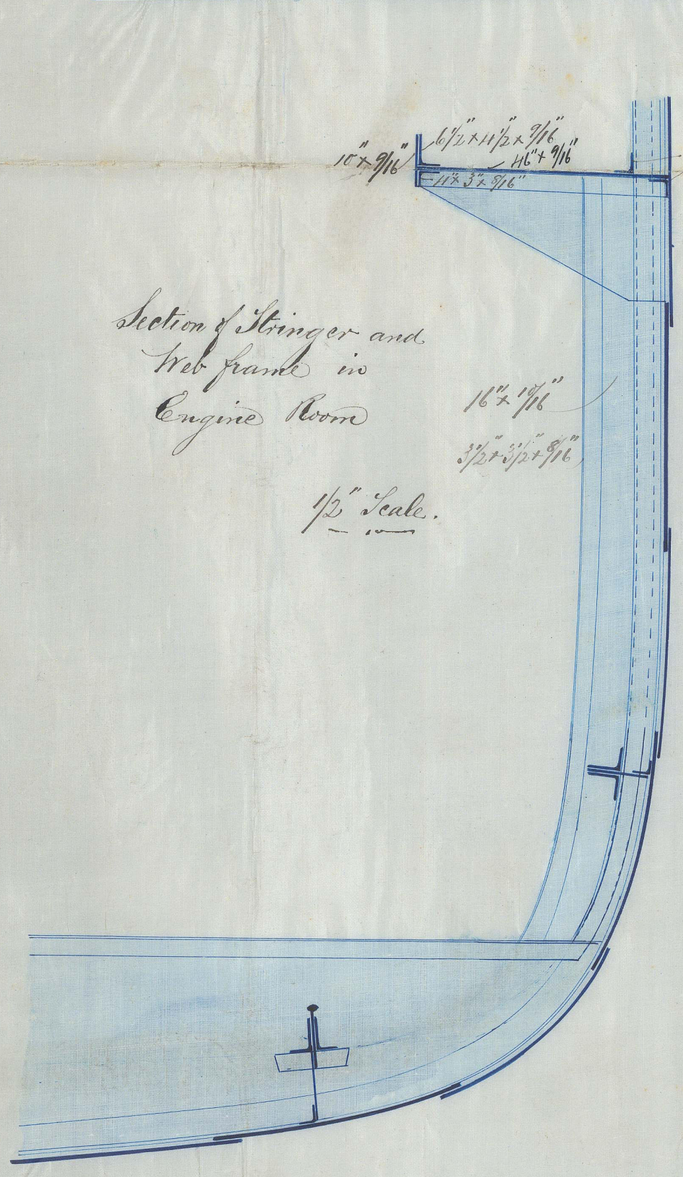

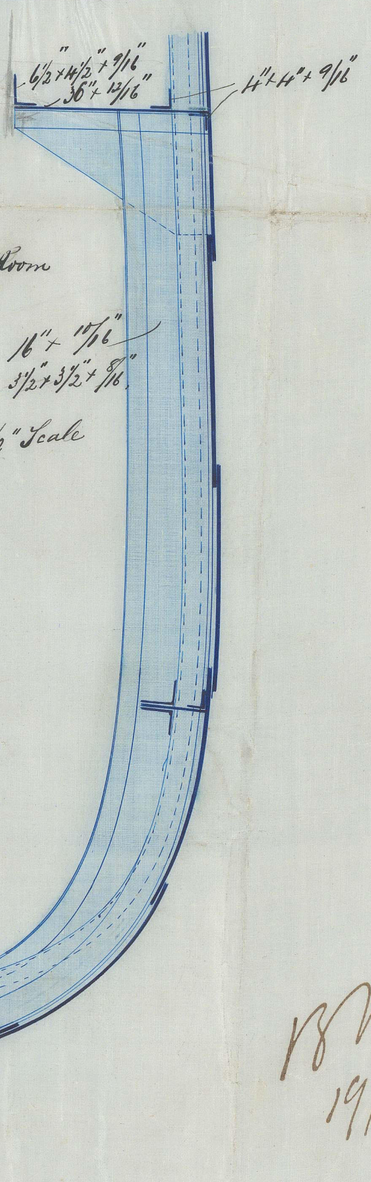

WILLIAM DENNY & BROTHERS DRAWING OFFICE No. 2633 DUMBARTON

IRON527-0049

© 2021 Lloyd's Register Foundation