

19/6/77


S.L. Pichard
Report number 3945
S.L. "Oakdale"
Report no 3998

No 70 SS x 72

Scale 1/4" = 1 foot

Rev 19/6/77 & 14/1/78

2122

 


for Edw. & Wm. Ho
Geo. Cooper

19/6/77




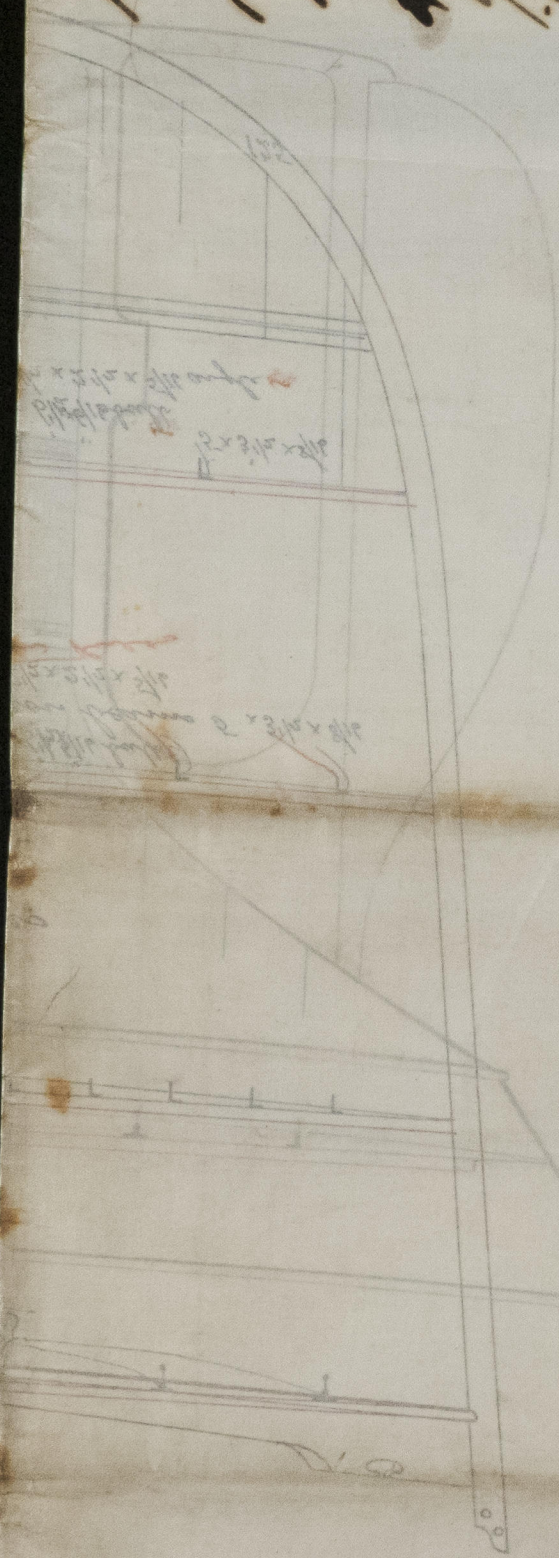

Drop
20657



© 2021

Lloyd's Register
Foundation