



LONGITUDINAL SECTION
OF
No 210

SHOWING ARRANGEMENT
OF
BEAMS, STRINGERS, &c

Scale 4 Inch to one Foot

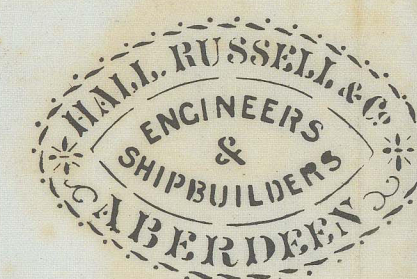

Rec 18/10/77
HA

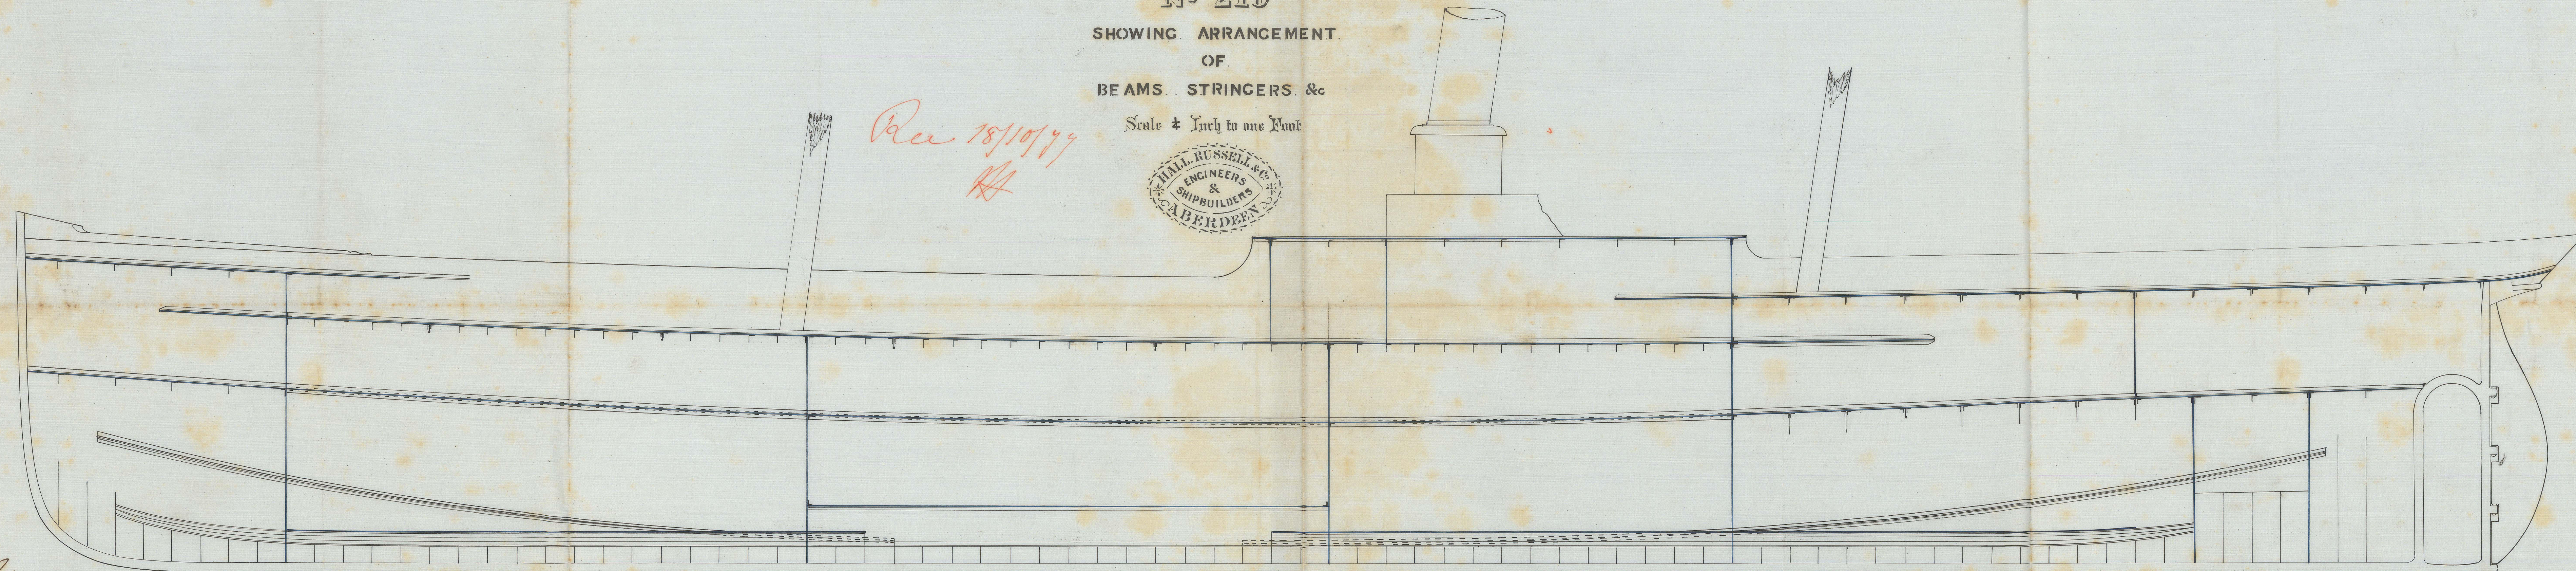

1872
19/10/77