


"Humbert" - Report No 13980.
Sketch shewing position of Hold Beams S.S. No 34.

Scale 1/8 inch to one Foot.

Oct 1st 1877.

Rec 3/10/77
B

4.10.77

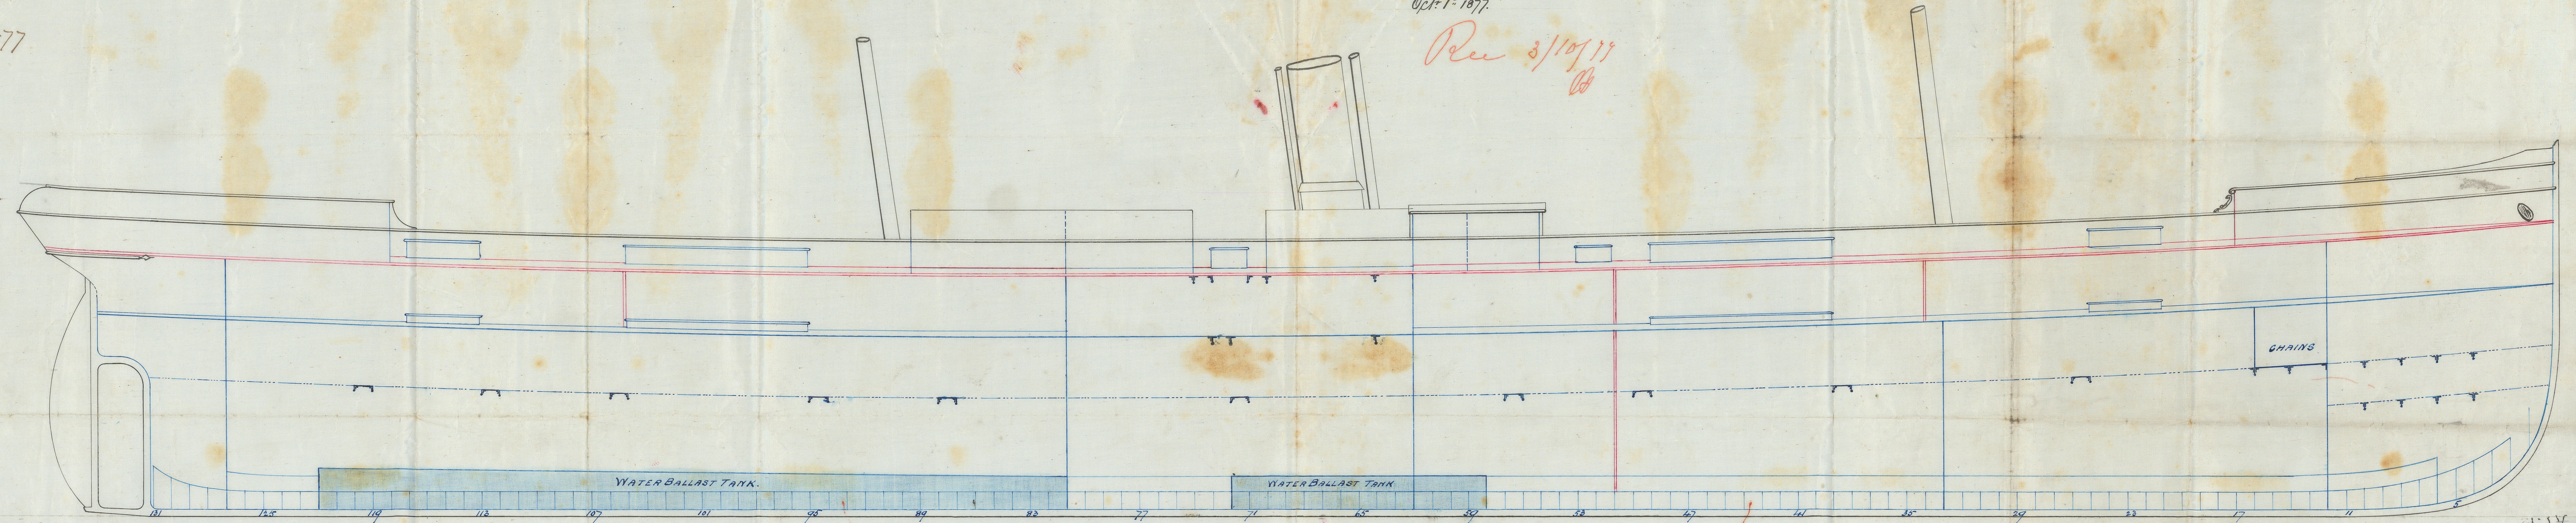

C. S. SWAIN & CO

Iron Shipbuilders

WALLSEND

NEWCASTLE-ON-TYNE

No 34

J.H.A.
4/10/77

IRONS 27-0089

Lloyd's Register
 Foundation