
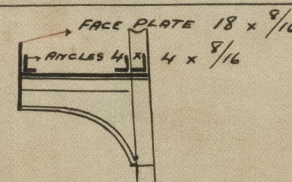


SECTION OF MAIN AND LOTTER DECKS IN YAKE OF ENGINES AND BOILERS. S. S. Nos 108 & 109
SCALE $\frac{1}{4}$ INCH PER FOOT


CHARLES CONNELL & CO.
SESTON SHIPBUILDING YARD
27/2/77 WHITEINCH CLASCOY.

S. S. Locke Hall
Estab'd 1840 - 4661

MAIN DECK-

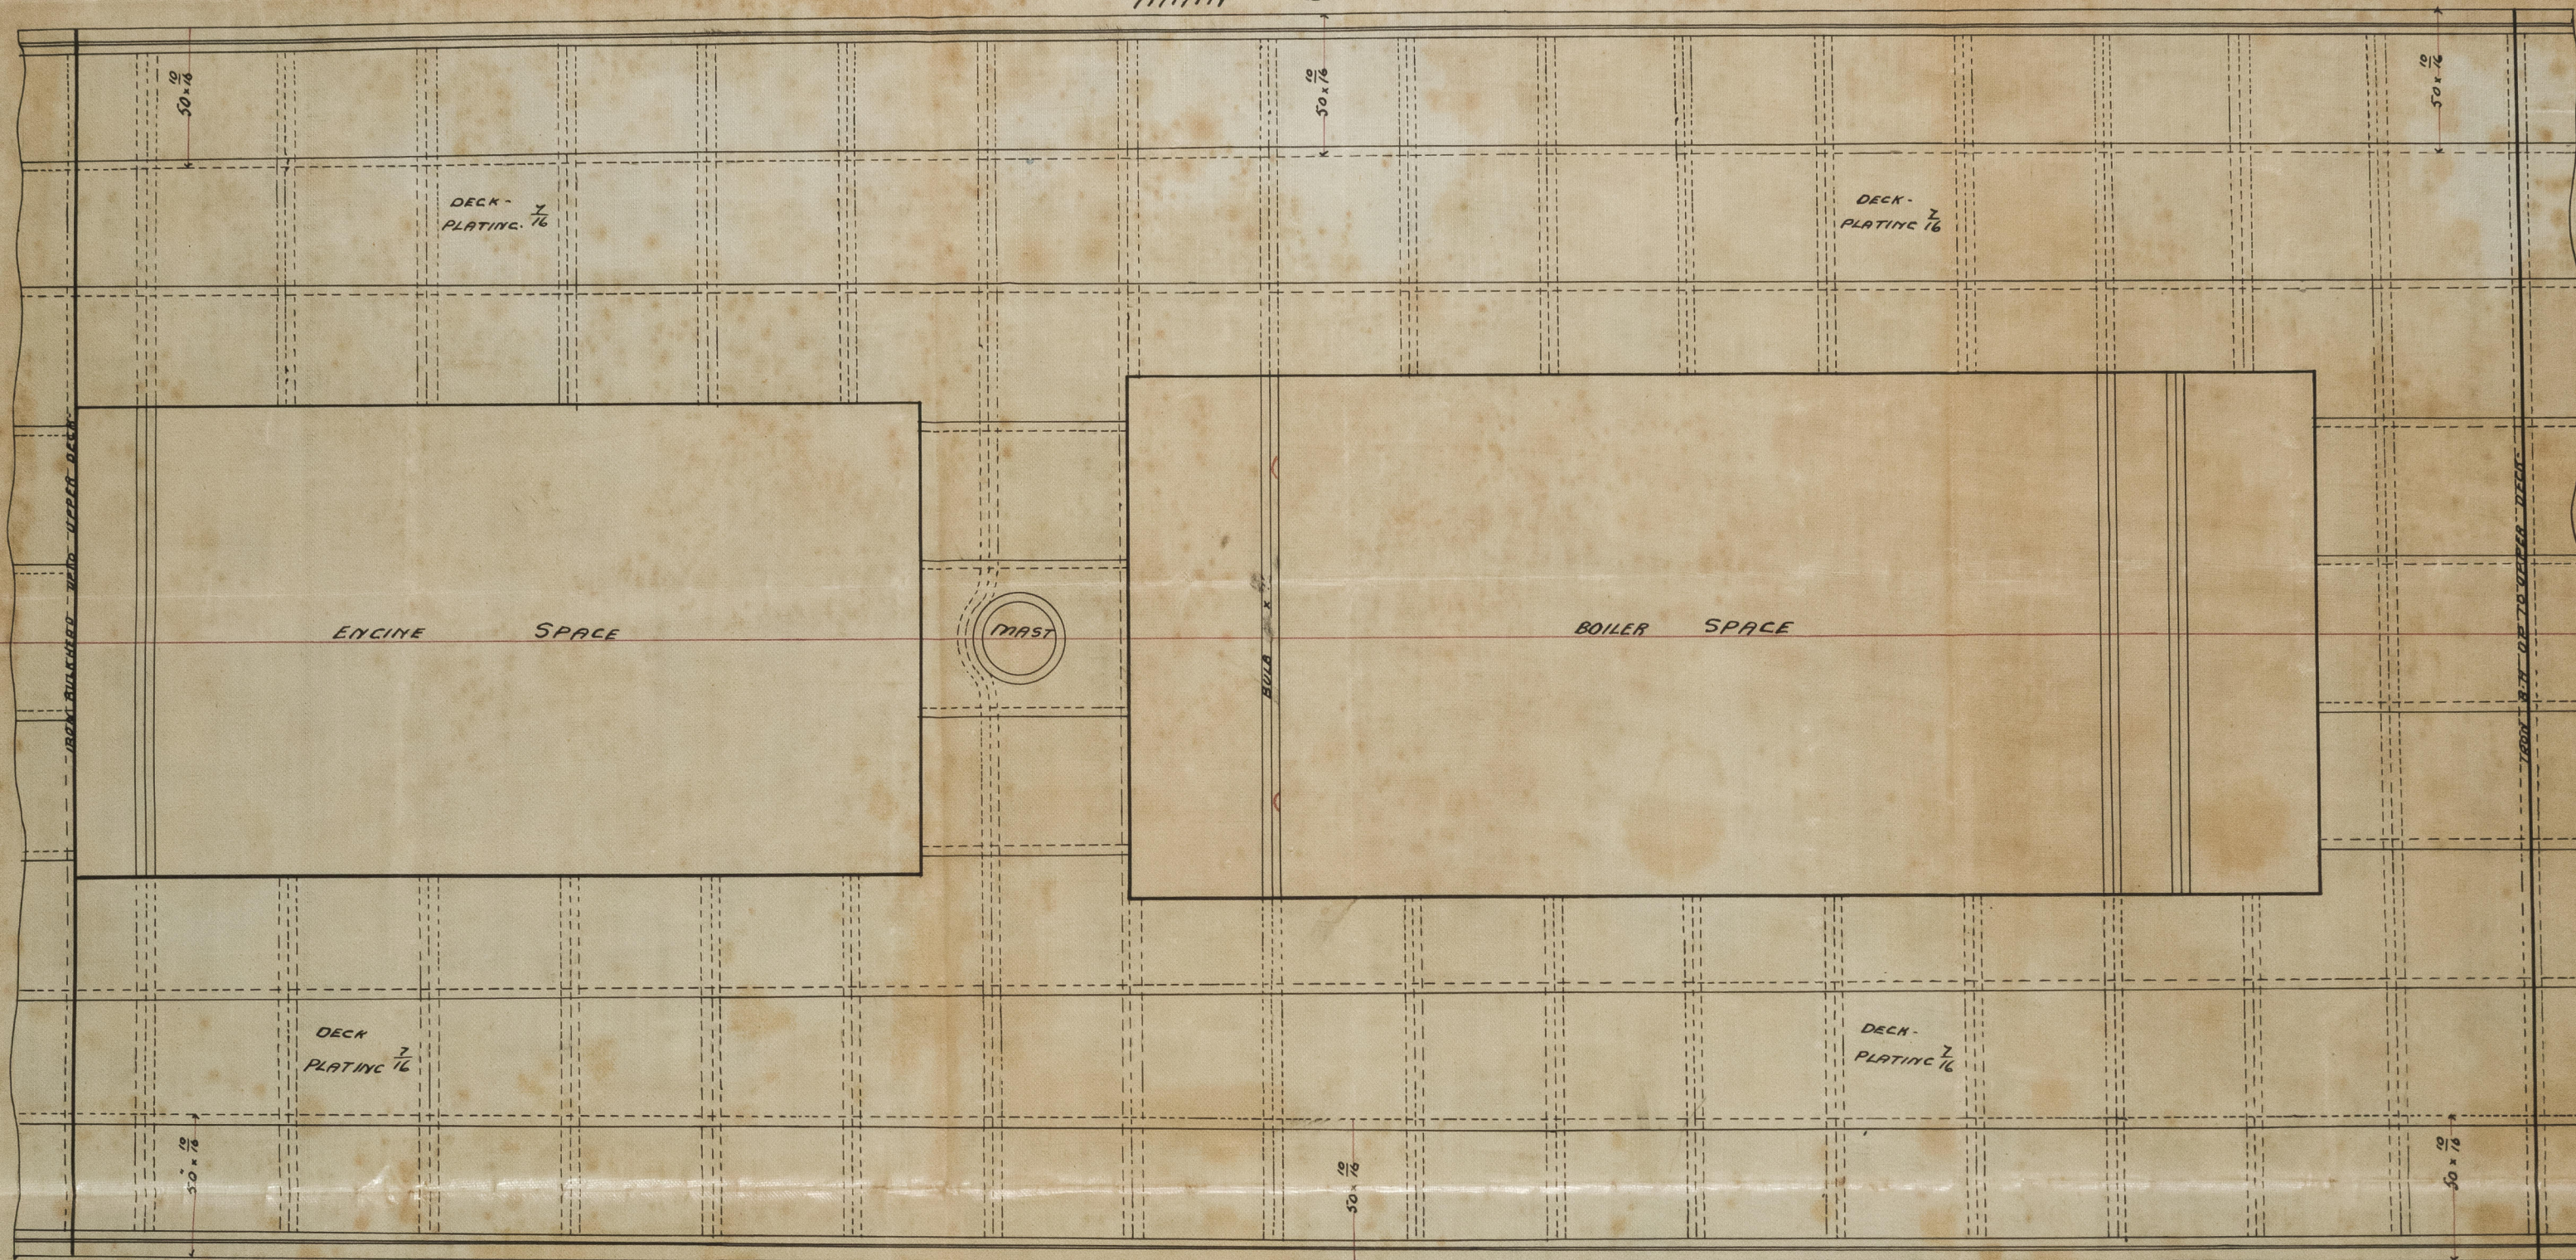

LOTTER DECK-

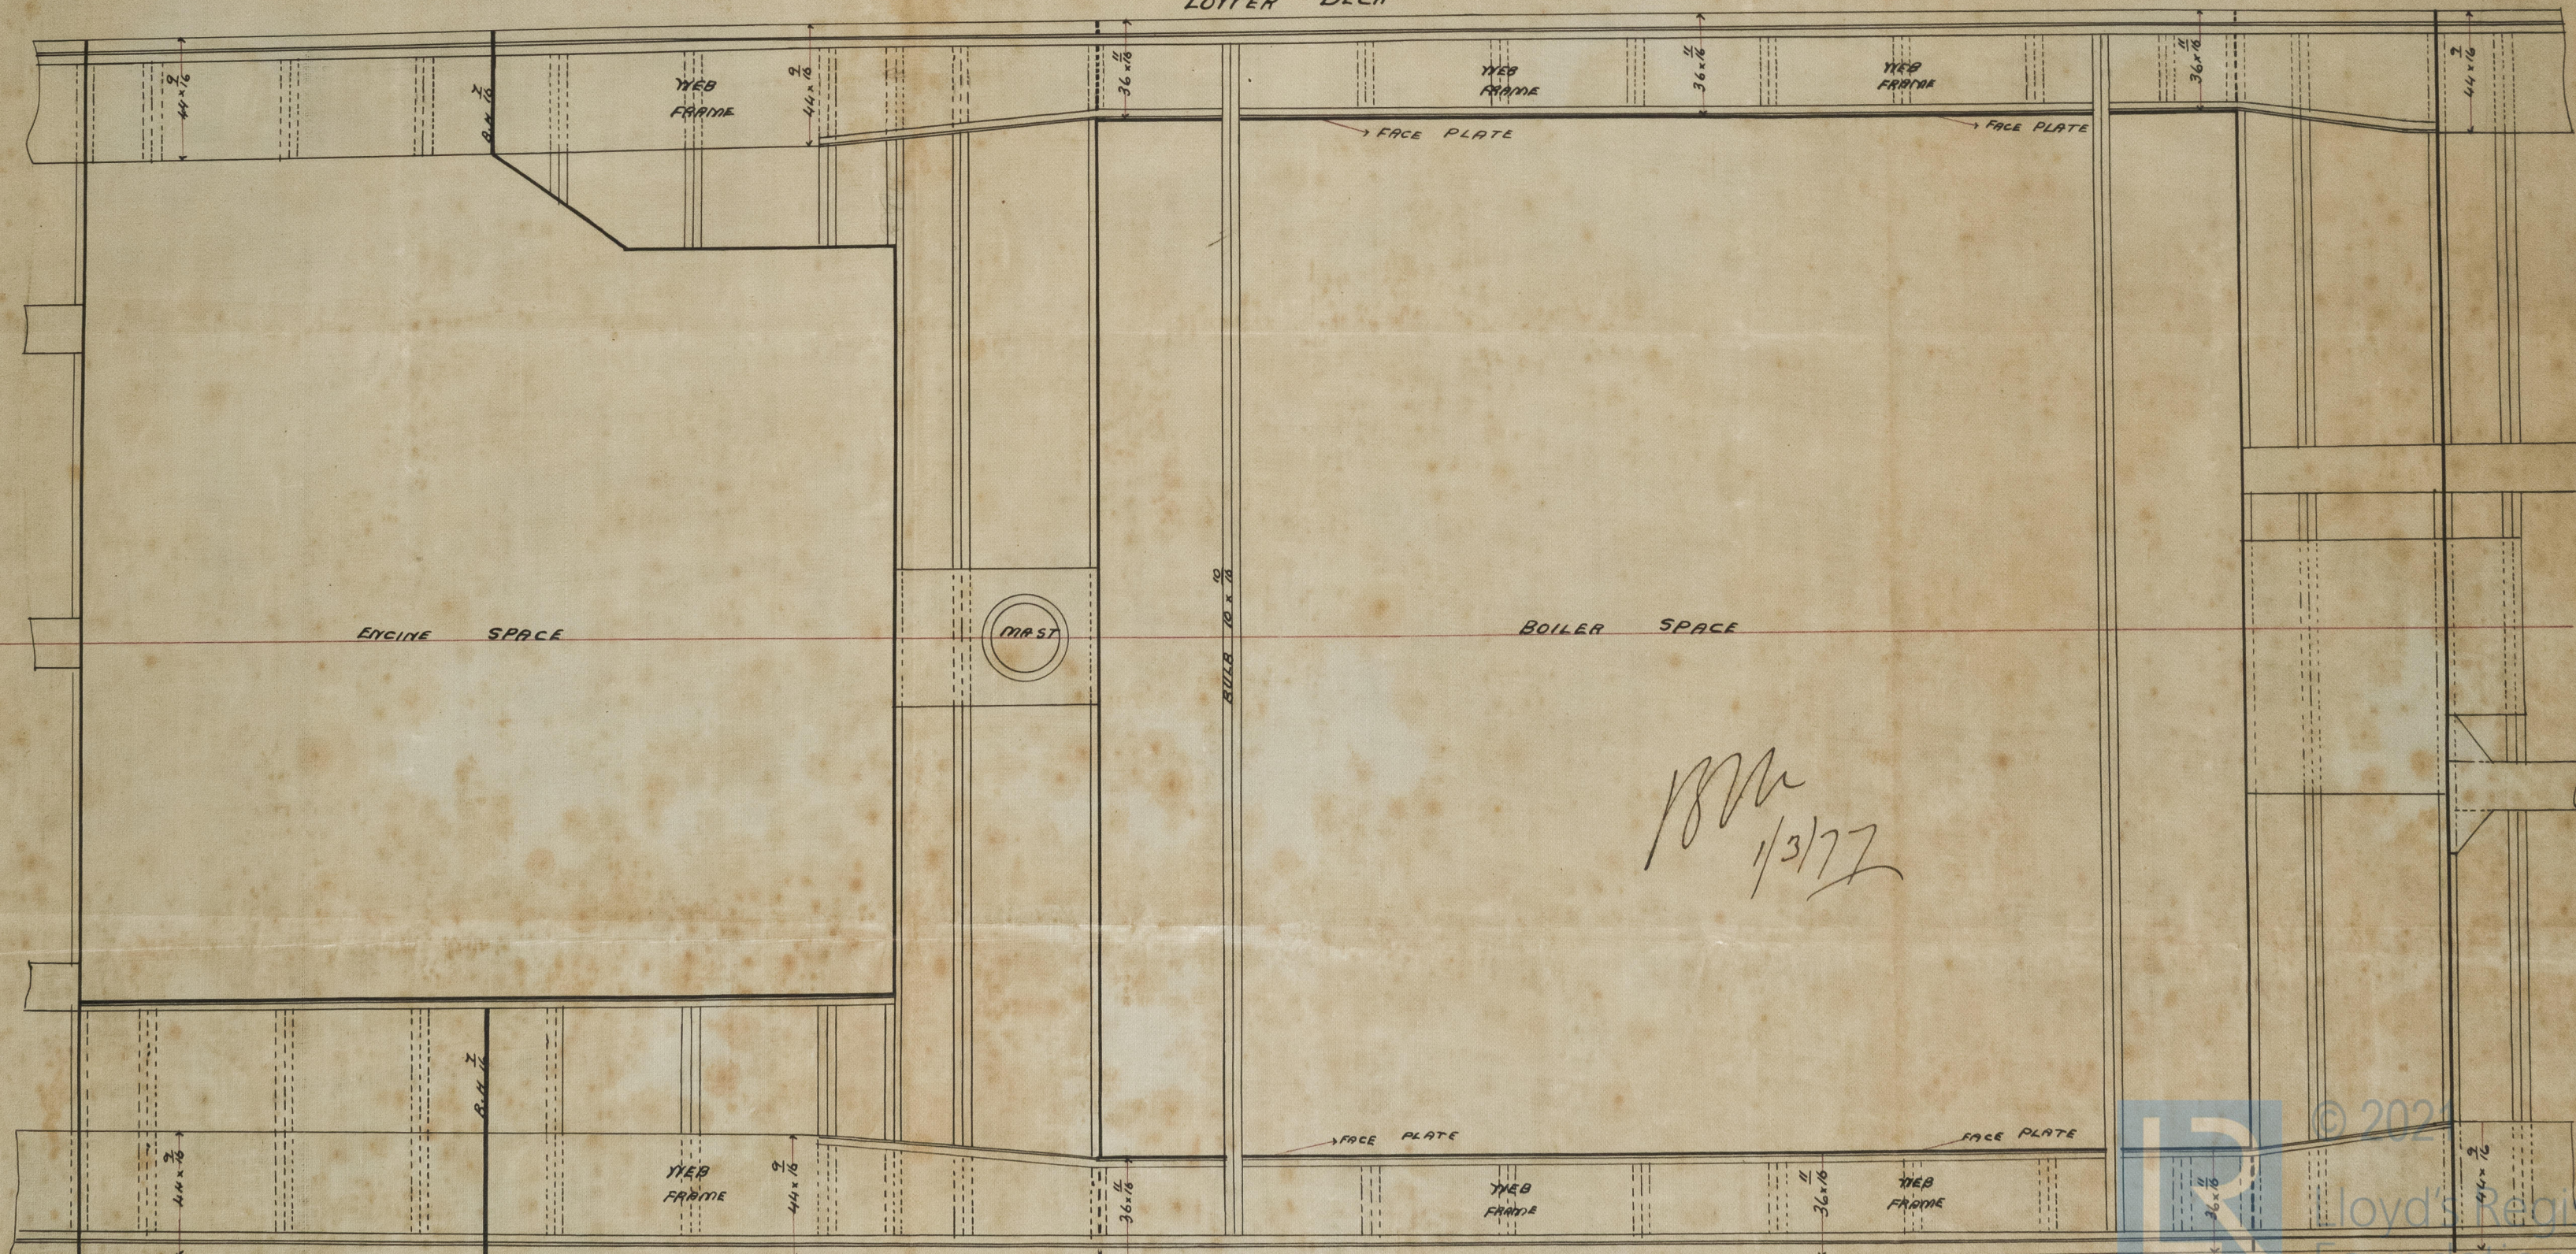

1800
1/3/77