


11/12/77


Iron S.S. Memmure Sld. report No 11.946

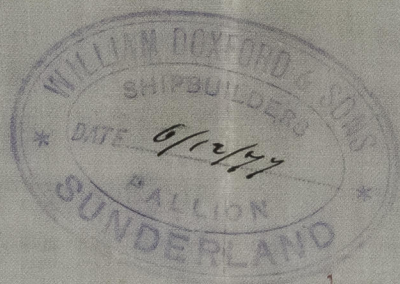


S.S. No 102  
 Section of Ballast Tanks  
 each 1/2" for

Rec 8/12/77  
 H

Midship Tank.

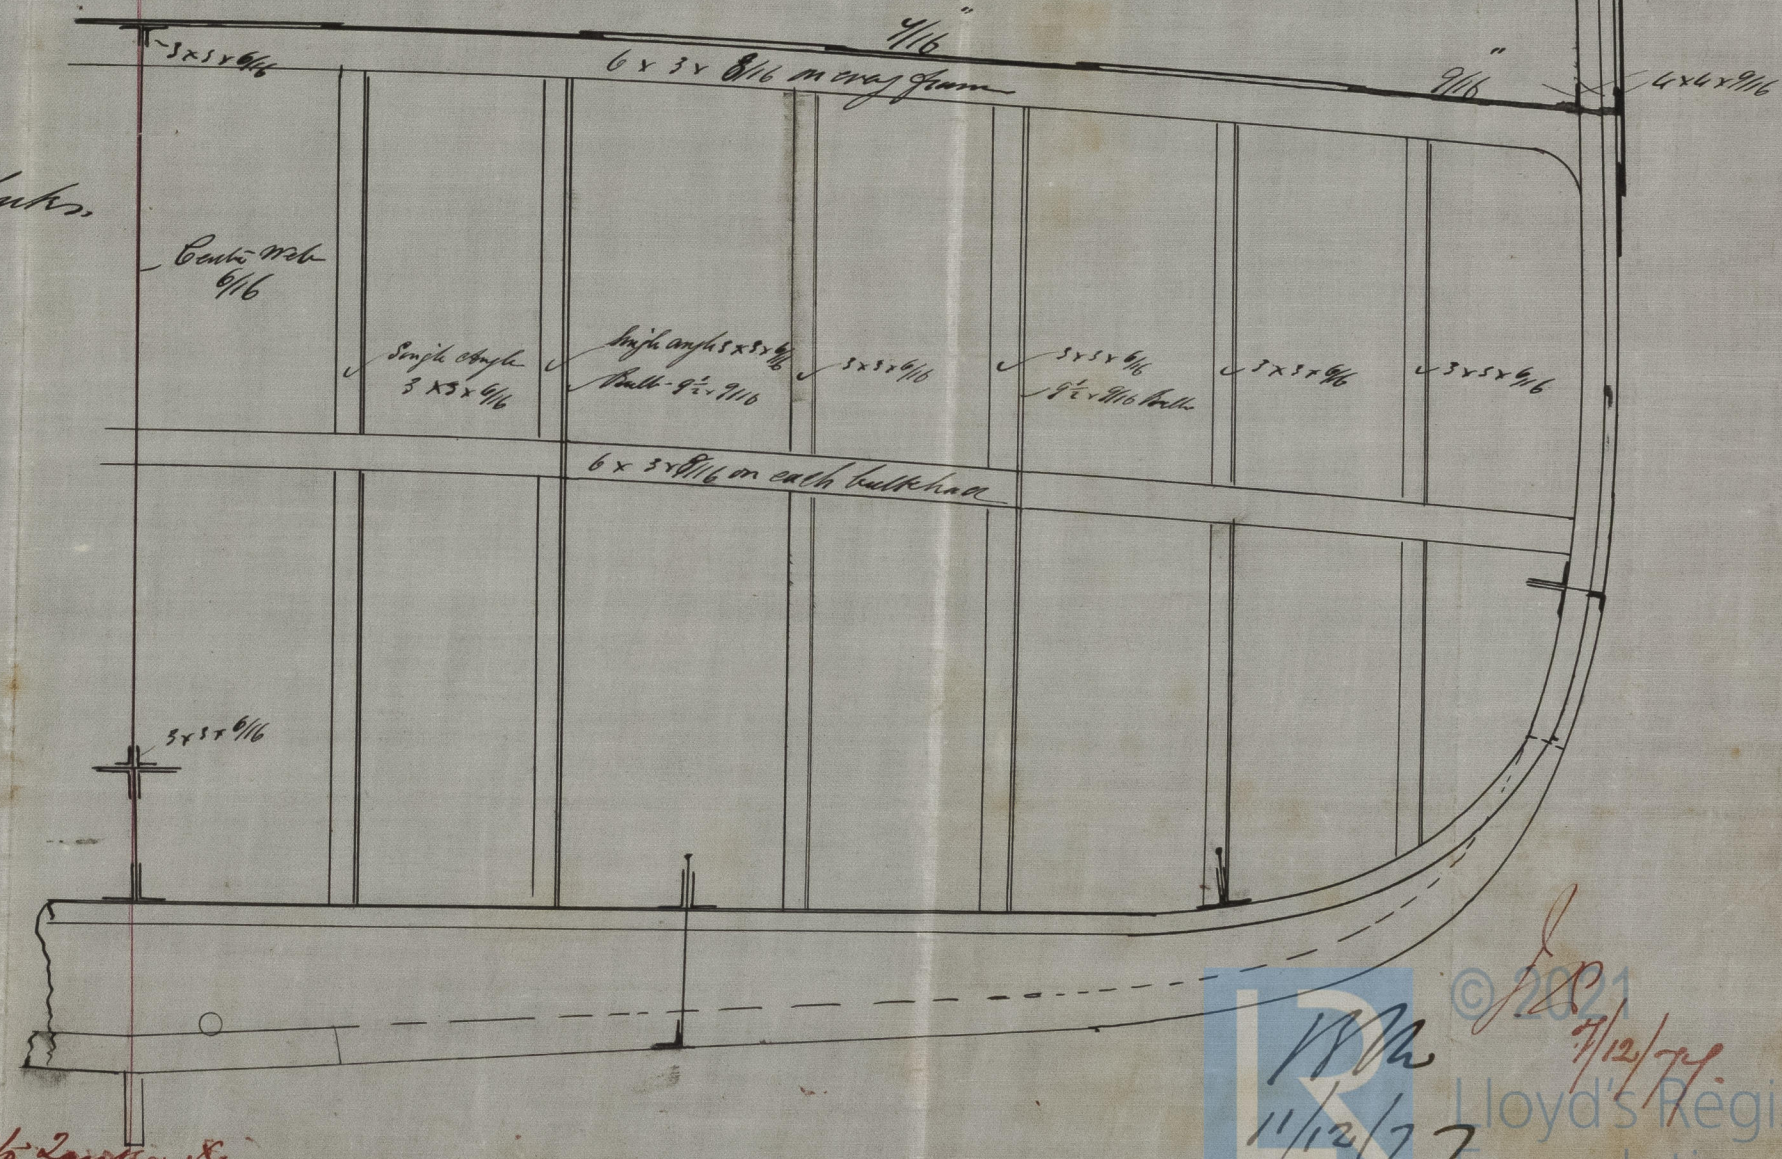

After Tank.

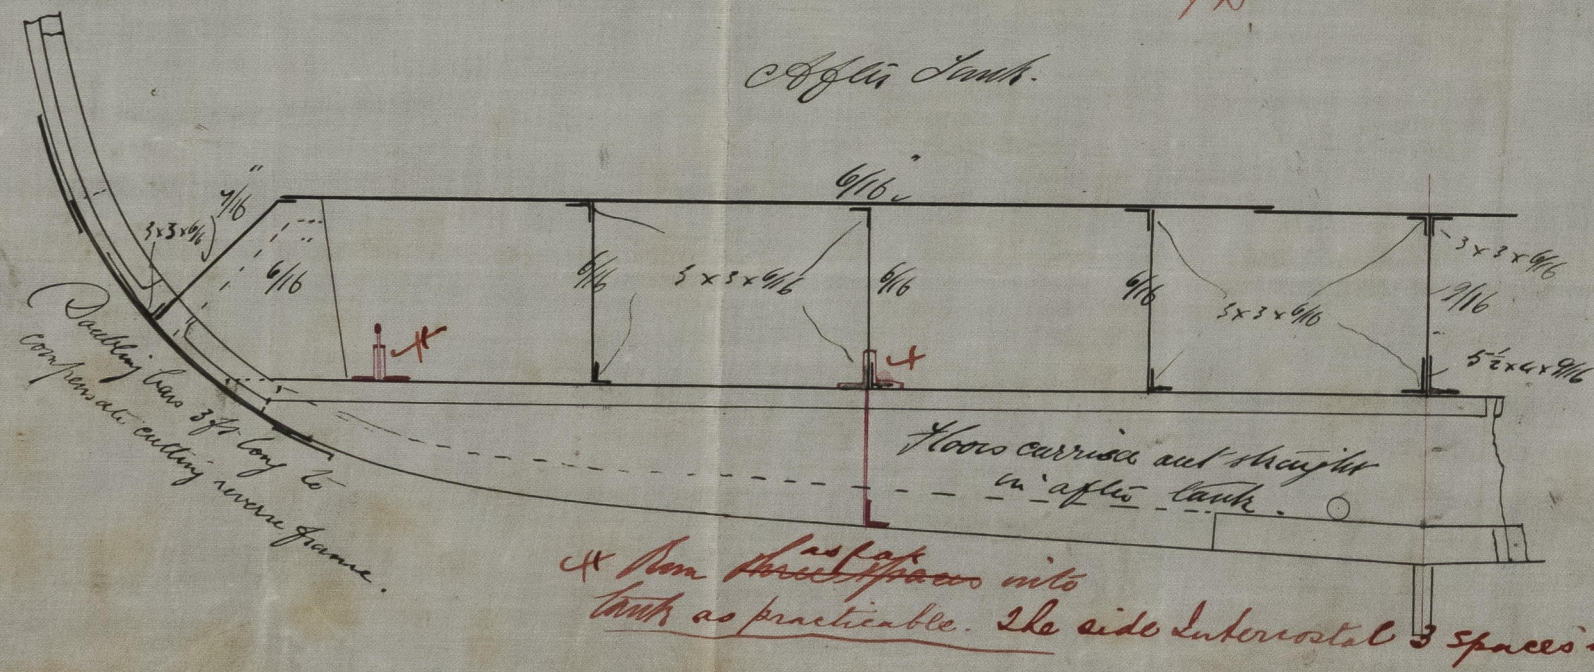

\* From ~~stiffeners~~ into  
 tanks as practicable. The side intercostal 3 spaces into 2 spaces &c.

© 2021  
 Lloyd's Register  
 Foundation  
 11/12/77