

Iron S.S. "Memmuir" Sld report No 11.976

S.S. No 102

Sections of iron Masts
Scale 1" = 1 Foot

Fore Mast 74.9 feet

23" diam.

Plating $\frac{5}{16}$ & $\frac{5}{16}$

Seams double rivet



Butts below partners double

remainder treble rivet

Straps $\frac{1}{16}$ thicker than plates

doubled in way of wedging

6.0 + $\frac{5}{16}$ cheeks $\frac{3}{16}$ angle $4\frac{1}{2}$ + $3\frac{1}{16}$

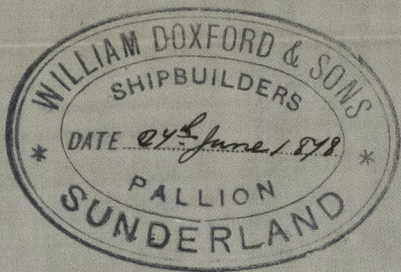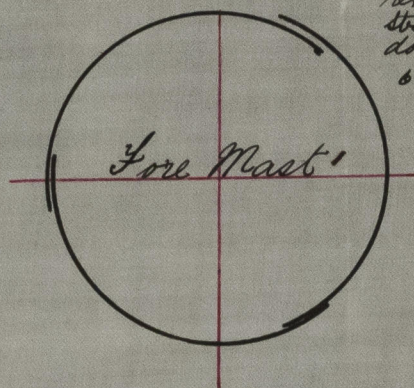

Main Mast 71.0 feet

21 1/2" diam

Plating $\frac{5}{16}$ & $\frac{5}{16}$

Seams double rivet


Butts below partners double

remainder treble rivet

Straps $\frac{1}{16}$ thicker than plates

Doubled at wedging 6.0 + $\frac{5}{16}$

cheeks $\frac{3}{16}$ angle $4\frac{1}{2}$ + $3\frac{1}{16}$

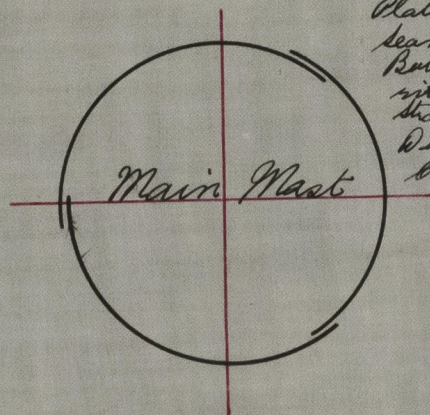

Same as passed for
S.S. Cavalier.

Duplicate R. 99
as passed



© 2021/5/78

Lloyd's Register
Foundation