


16/11/77

Midship Section of Sailing Ship No. 182.

Length for Lloyd's Rules.	333' 0"
Breadth Moulded.	34' 0"
Depth do.	33' 4 1/2"
Do. of Hold.	33' 4"

Persian of London
Greenock Report
No 4443.

Rec 15/11/77

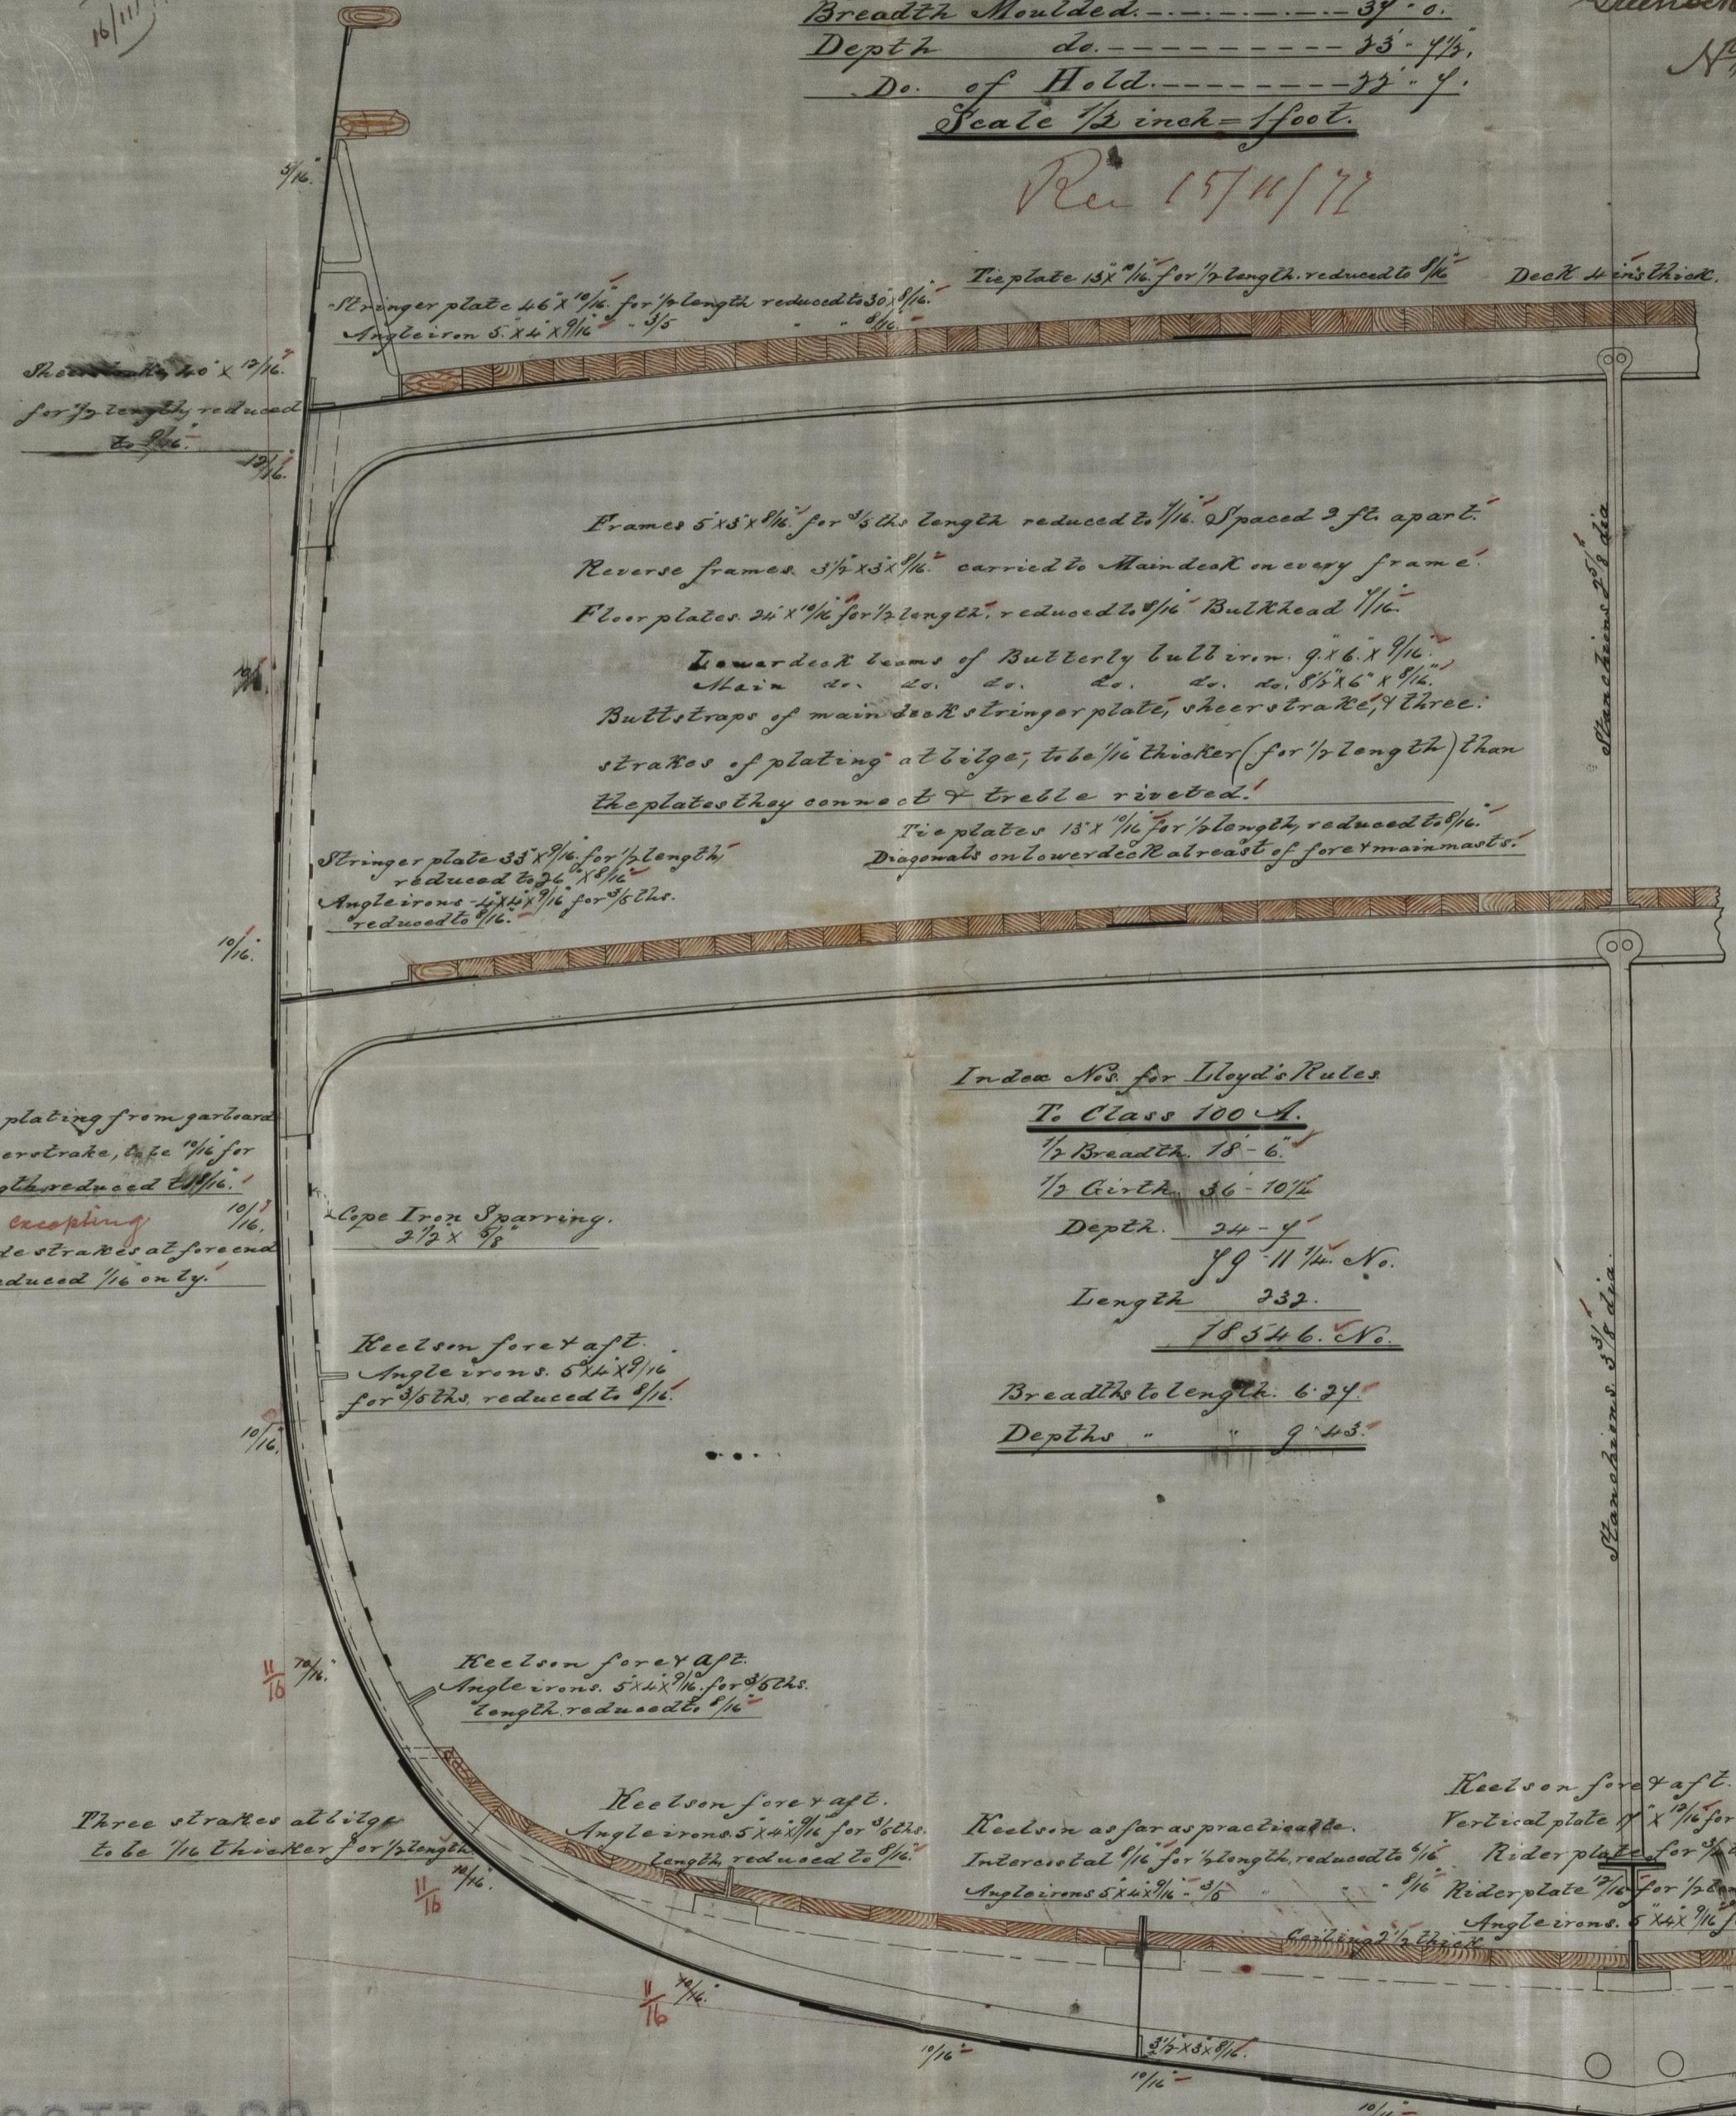

SCOTT & CO.
ENGINEERS AND IRON SHIPBUILDERS,
CARTSDYKE,
GREENOCK.

8th November 1877

L900-1828-1

© 2021
Lloyd's Register Foundation