



S. S. "Antonio"
N^o 92
Half Section of High Lark.
also stem of Lark Rock

Rec 94/3/18


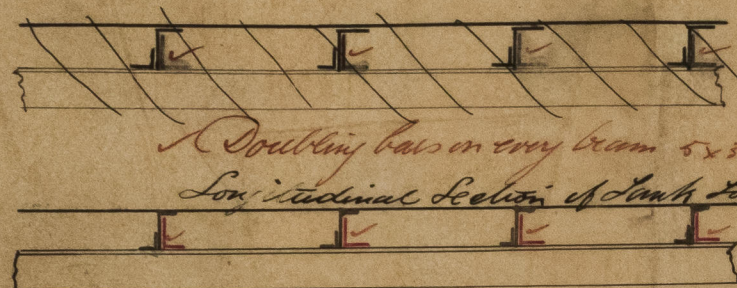

Doubling bars on every beam $5 \times 3 \times \frac{1}{2}$
Longitudinal Section of Tank L.P.

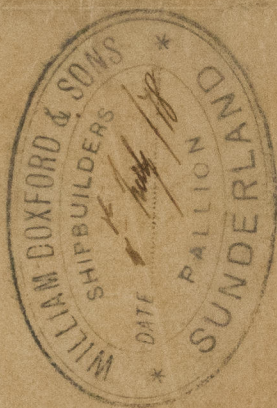

04.4.2021
04/4/21
Lloyd's Register
Foundation
IRON529-0044