


N^o 109 S.S. "Danish Monarch" - Report No 14940

LONGITUDINAL-PLAN


SCALE $\frac{1}{8}'' = 1 \text{ FT}$

Revised & 10/2/18

12.2.78
18.2.78

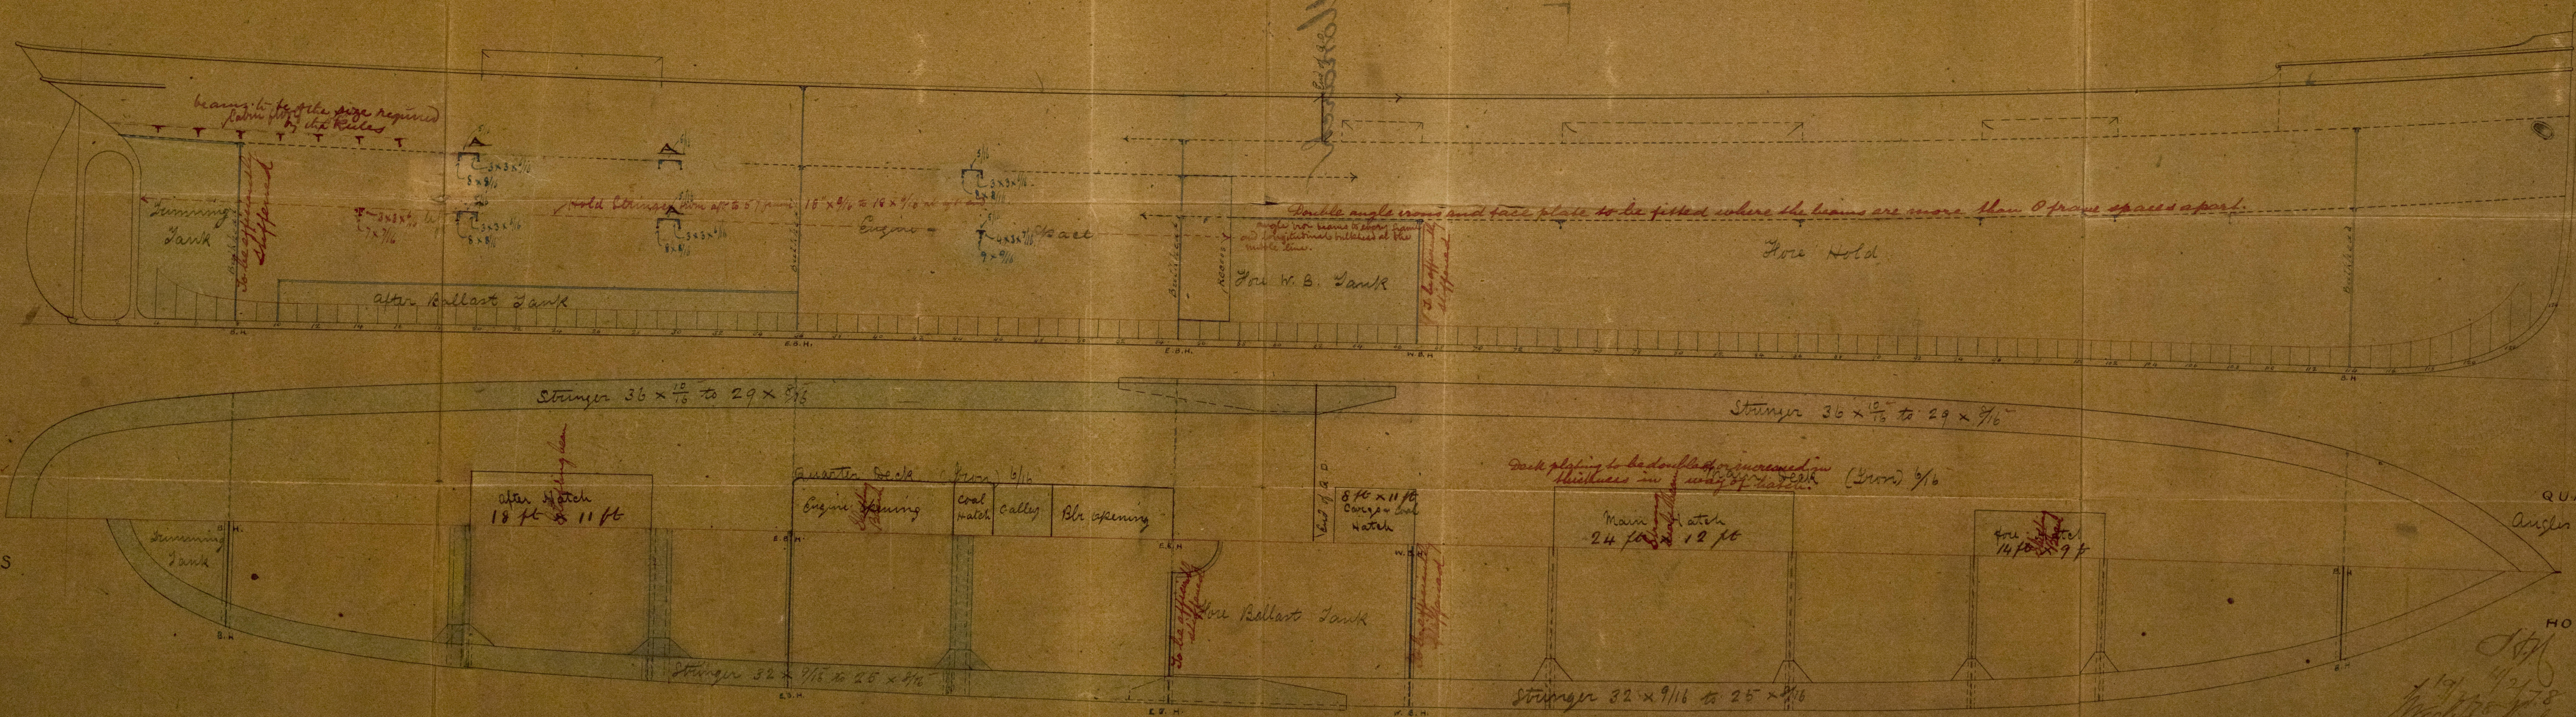

10/2/18
W. J. Richardson
Newcastle upon Tyne 9th Feb 1888

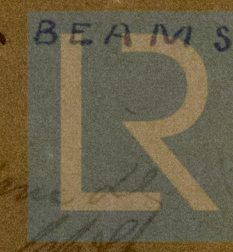

Lloyd's Register Foundation

s/5 cllonarch

IRON529-0057



© 2021

Lloyd's Register
Foundation