


19/2/78

3  
Amsterdam  
19/2/78

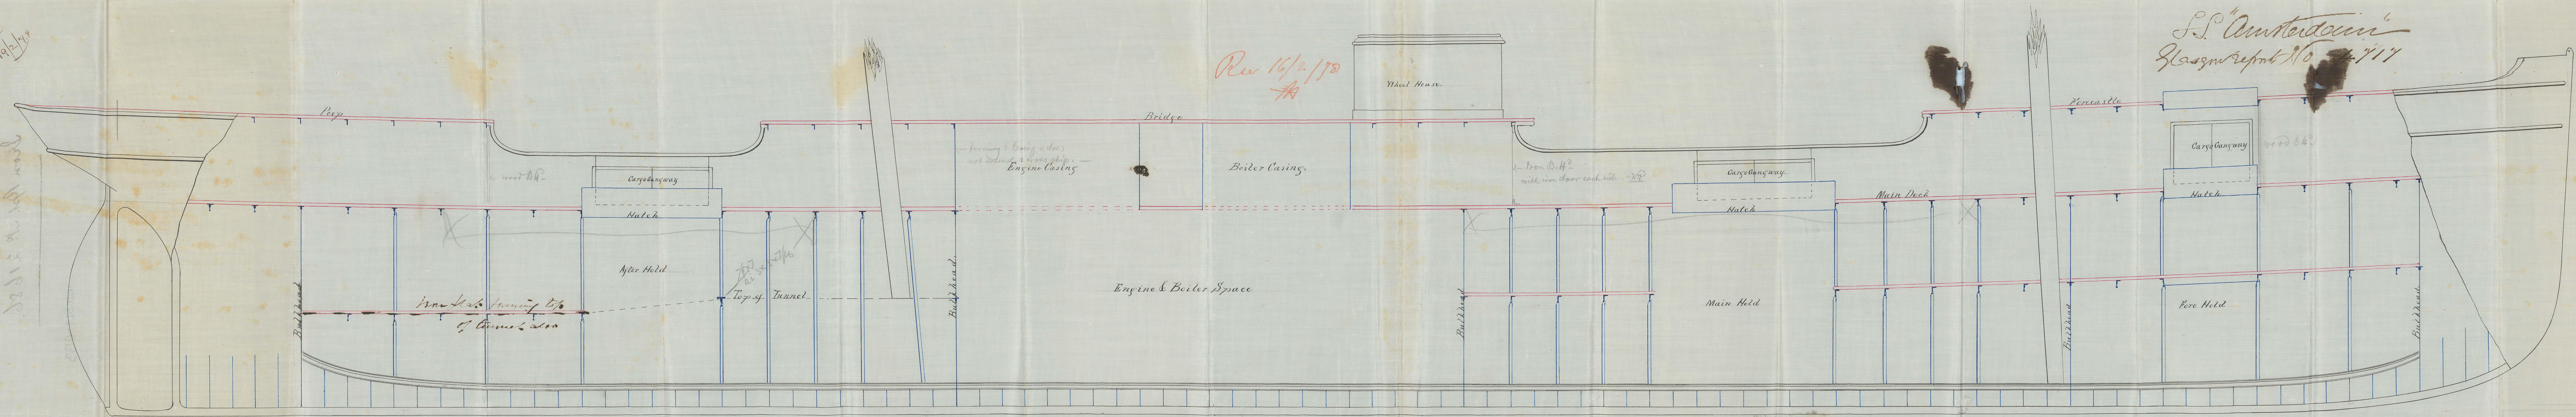

Rev 16/2/78  
HA

S.S. "Amsterdam"  
Glasgow Regt No 717

Sheer Plan.  
S.S. N<sup>o</sup> 31.  
Scale 1/4 in = One foot.


18/2/78



Is. "Amsterdam"

---

Iron Rpt. No. 21686

---

© 2021

Lloyd's Register  
Foundation

IRON 529-0133