

S.L. Annandale
Report No. 4061

MIDSHIP SECTION

Length over all	274.6
Between Posts	264.5
Breadth extreme	33.4
Mounted	33.2
Depth	20.0 1/2
of Hold to floors	19.0
Class 100 A1	10000
	18700


Scale 1/2" = 1 foot

Length for Numbers	263.0
Mounted Breadth	18.4
Depth to Deck	20.2 1/2
Small Numbers	20.1 1/2
Large Numbers	18.602
Equipment	10528

1 1/2 - 8 Breadth to Length
 12 - 13 Depth


Rev 2/3/28 & 13/3/75
JP

Section thro. Engine Room

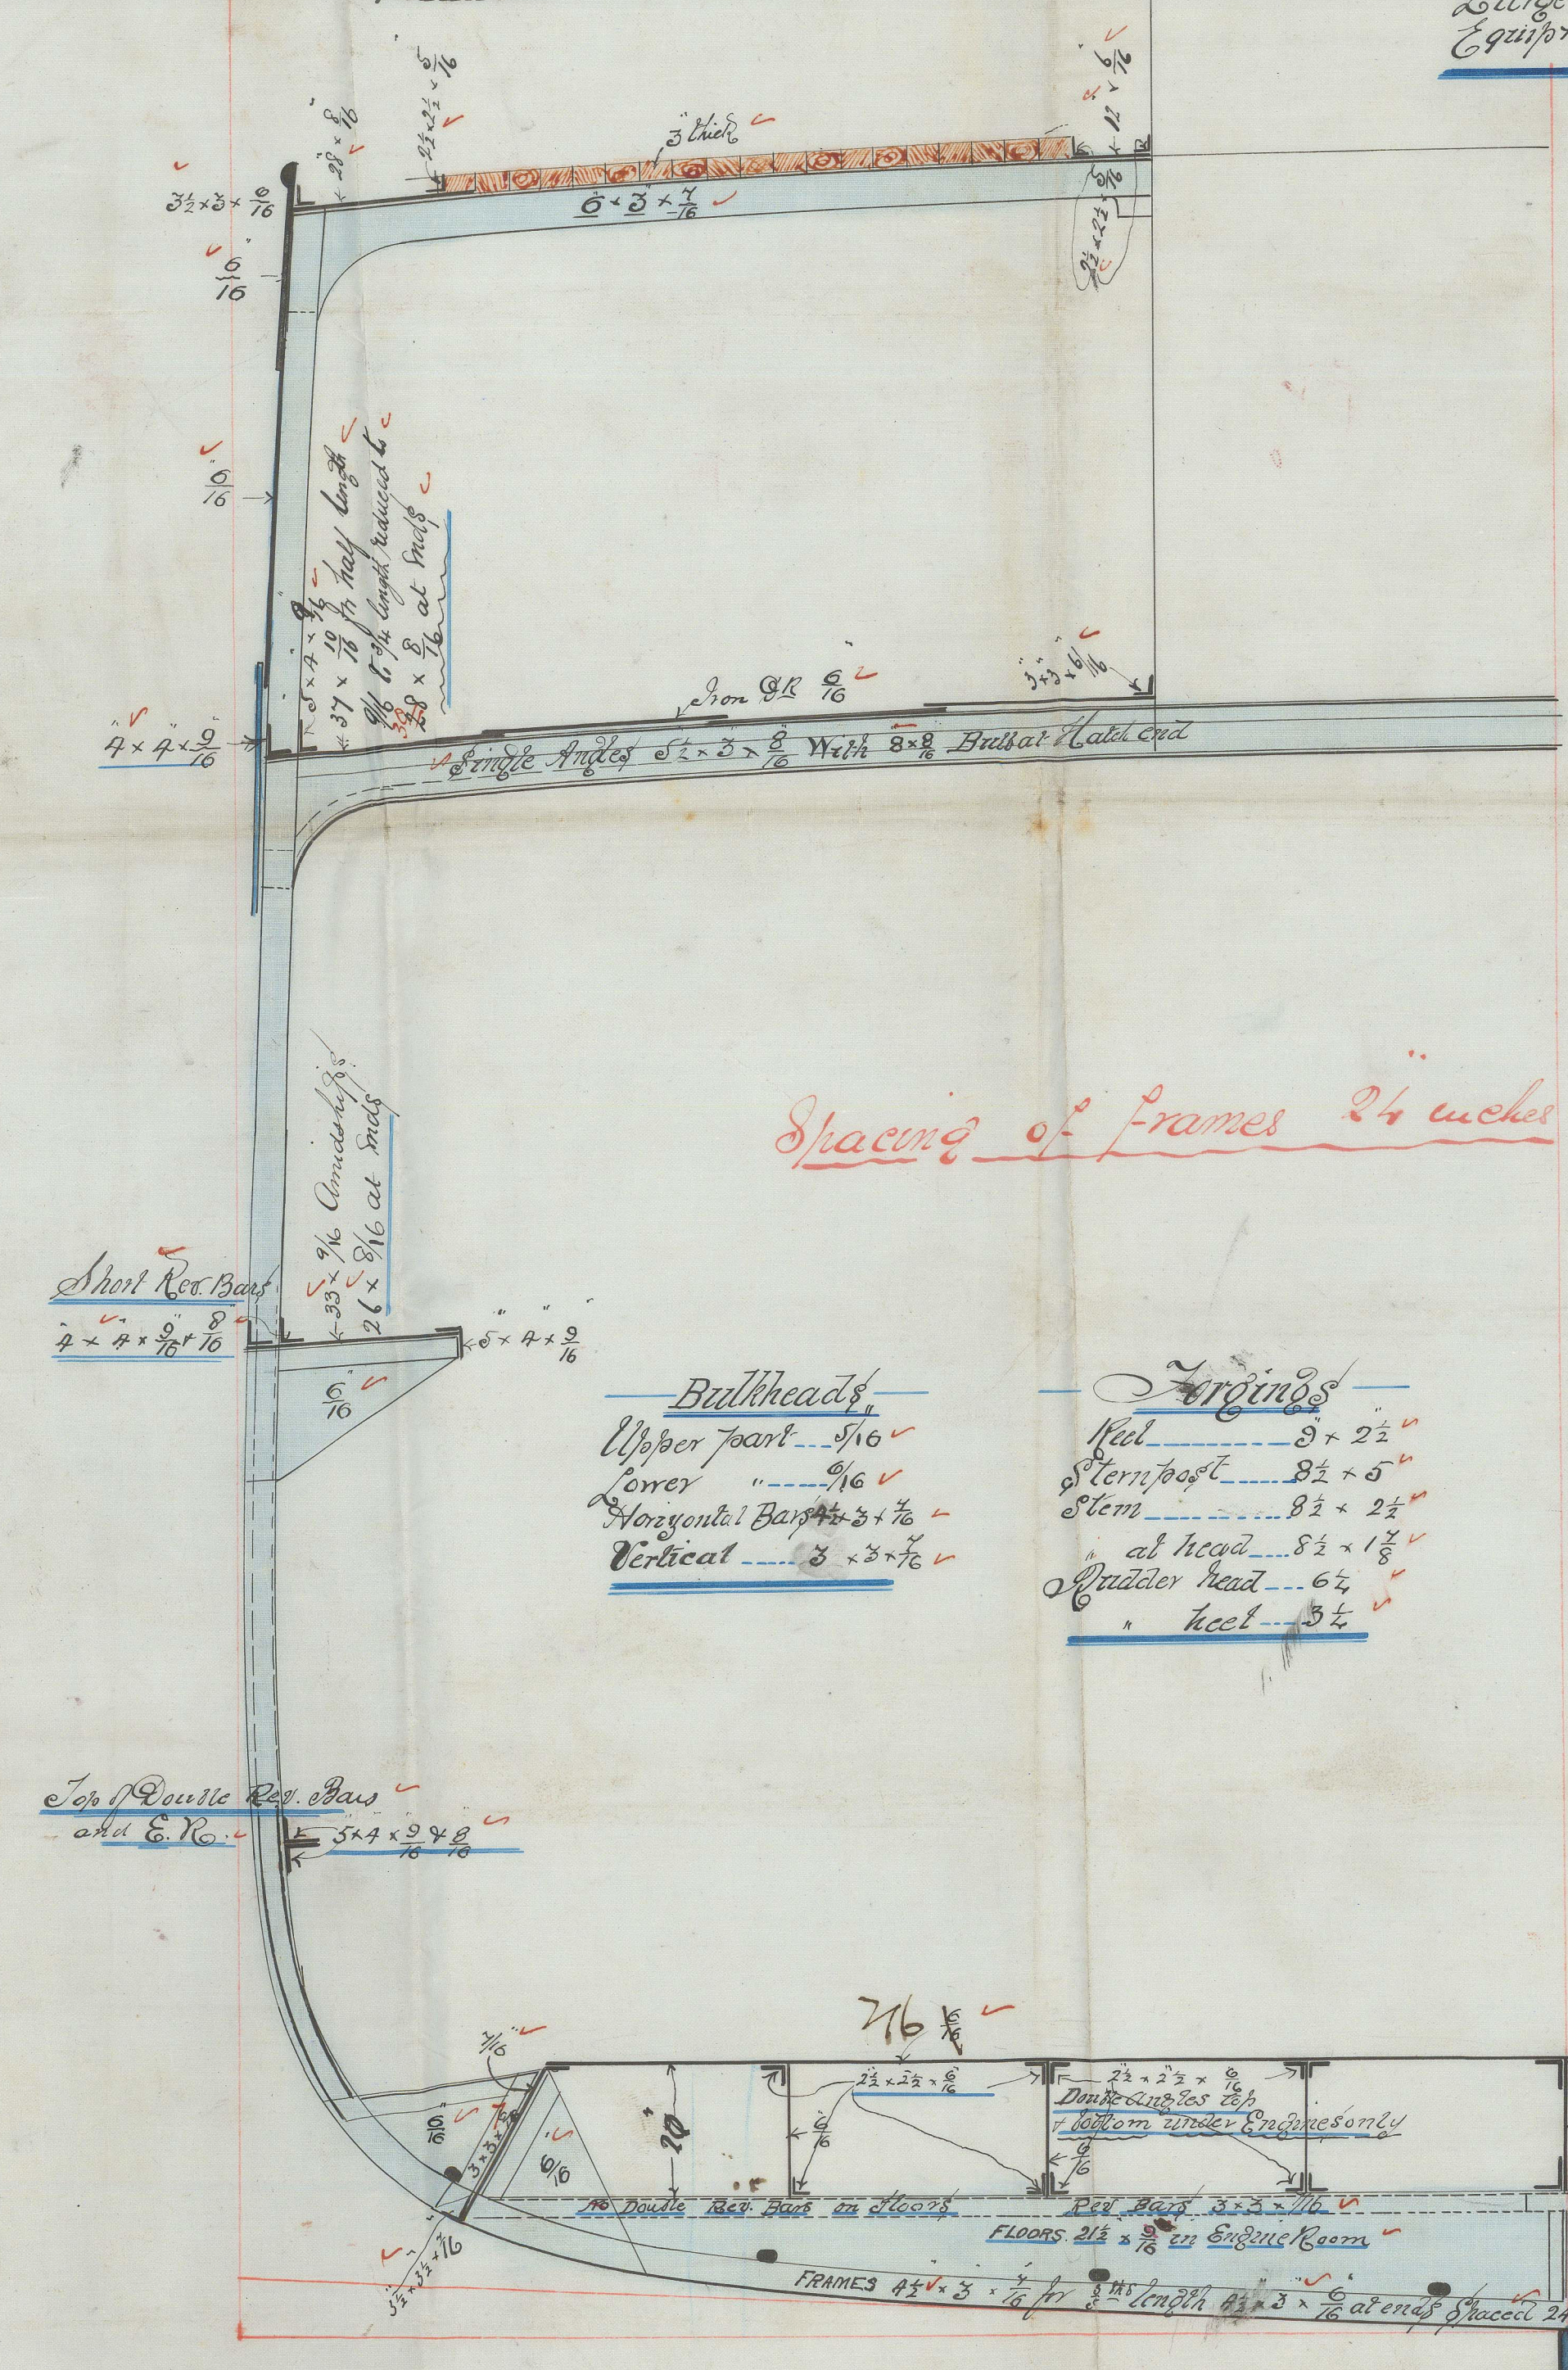

Bulkheads	Girders
Upper part 1/16	Mid 3 x 2 1/2
Lower 1/16	Stem post 8 1/2 x 5
Horizontal Bars 3 x 1 1/2	Stem 8 1/2 x 2 1/2
Vertical 8 x 3 x 1/2	at head 8 1/2 x 1 1/2
	Quicker head 6 1/2
	heel 3 1/2


Section of Deck at Centre

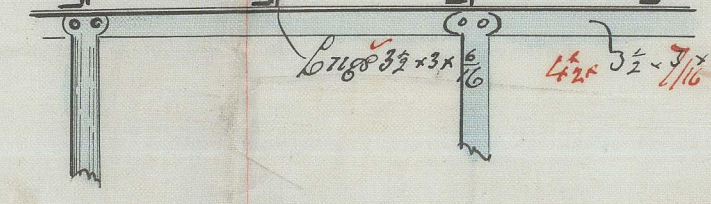


T. J. Forecastle

Beams built	8 1/2 x 3/4
Angles	2 1/2 x 2 1/4 x 1/4
Stringer plate	2 1/2 x 1/4
etc	9 x 1/4
Gravels	3 1/2 x 3 x 1/4
Waterway	2 1/2 x 2 1/2 x 1/4
Shell plates	1/4

Section thro. Fore Hold

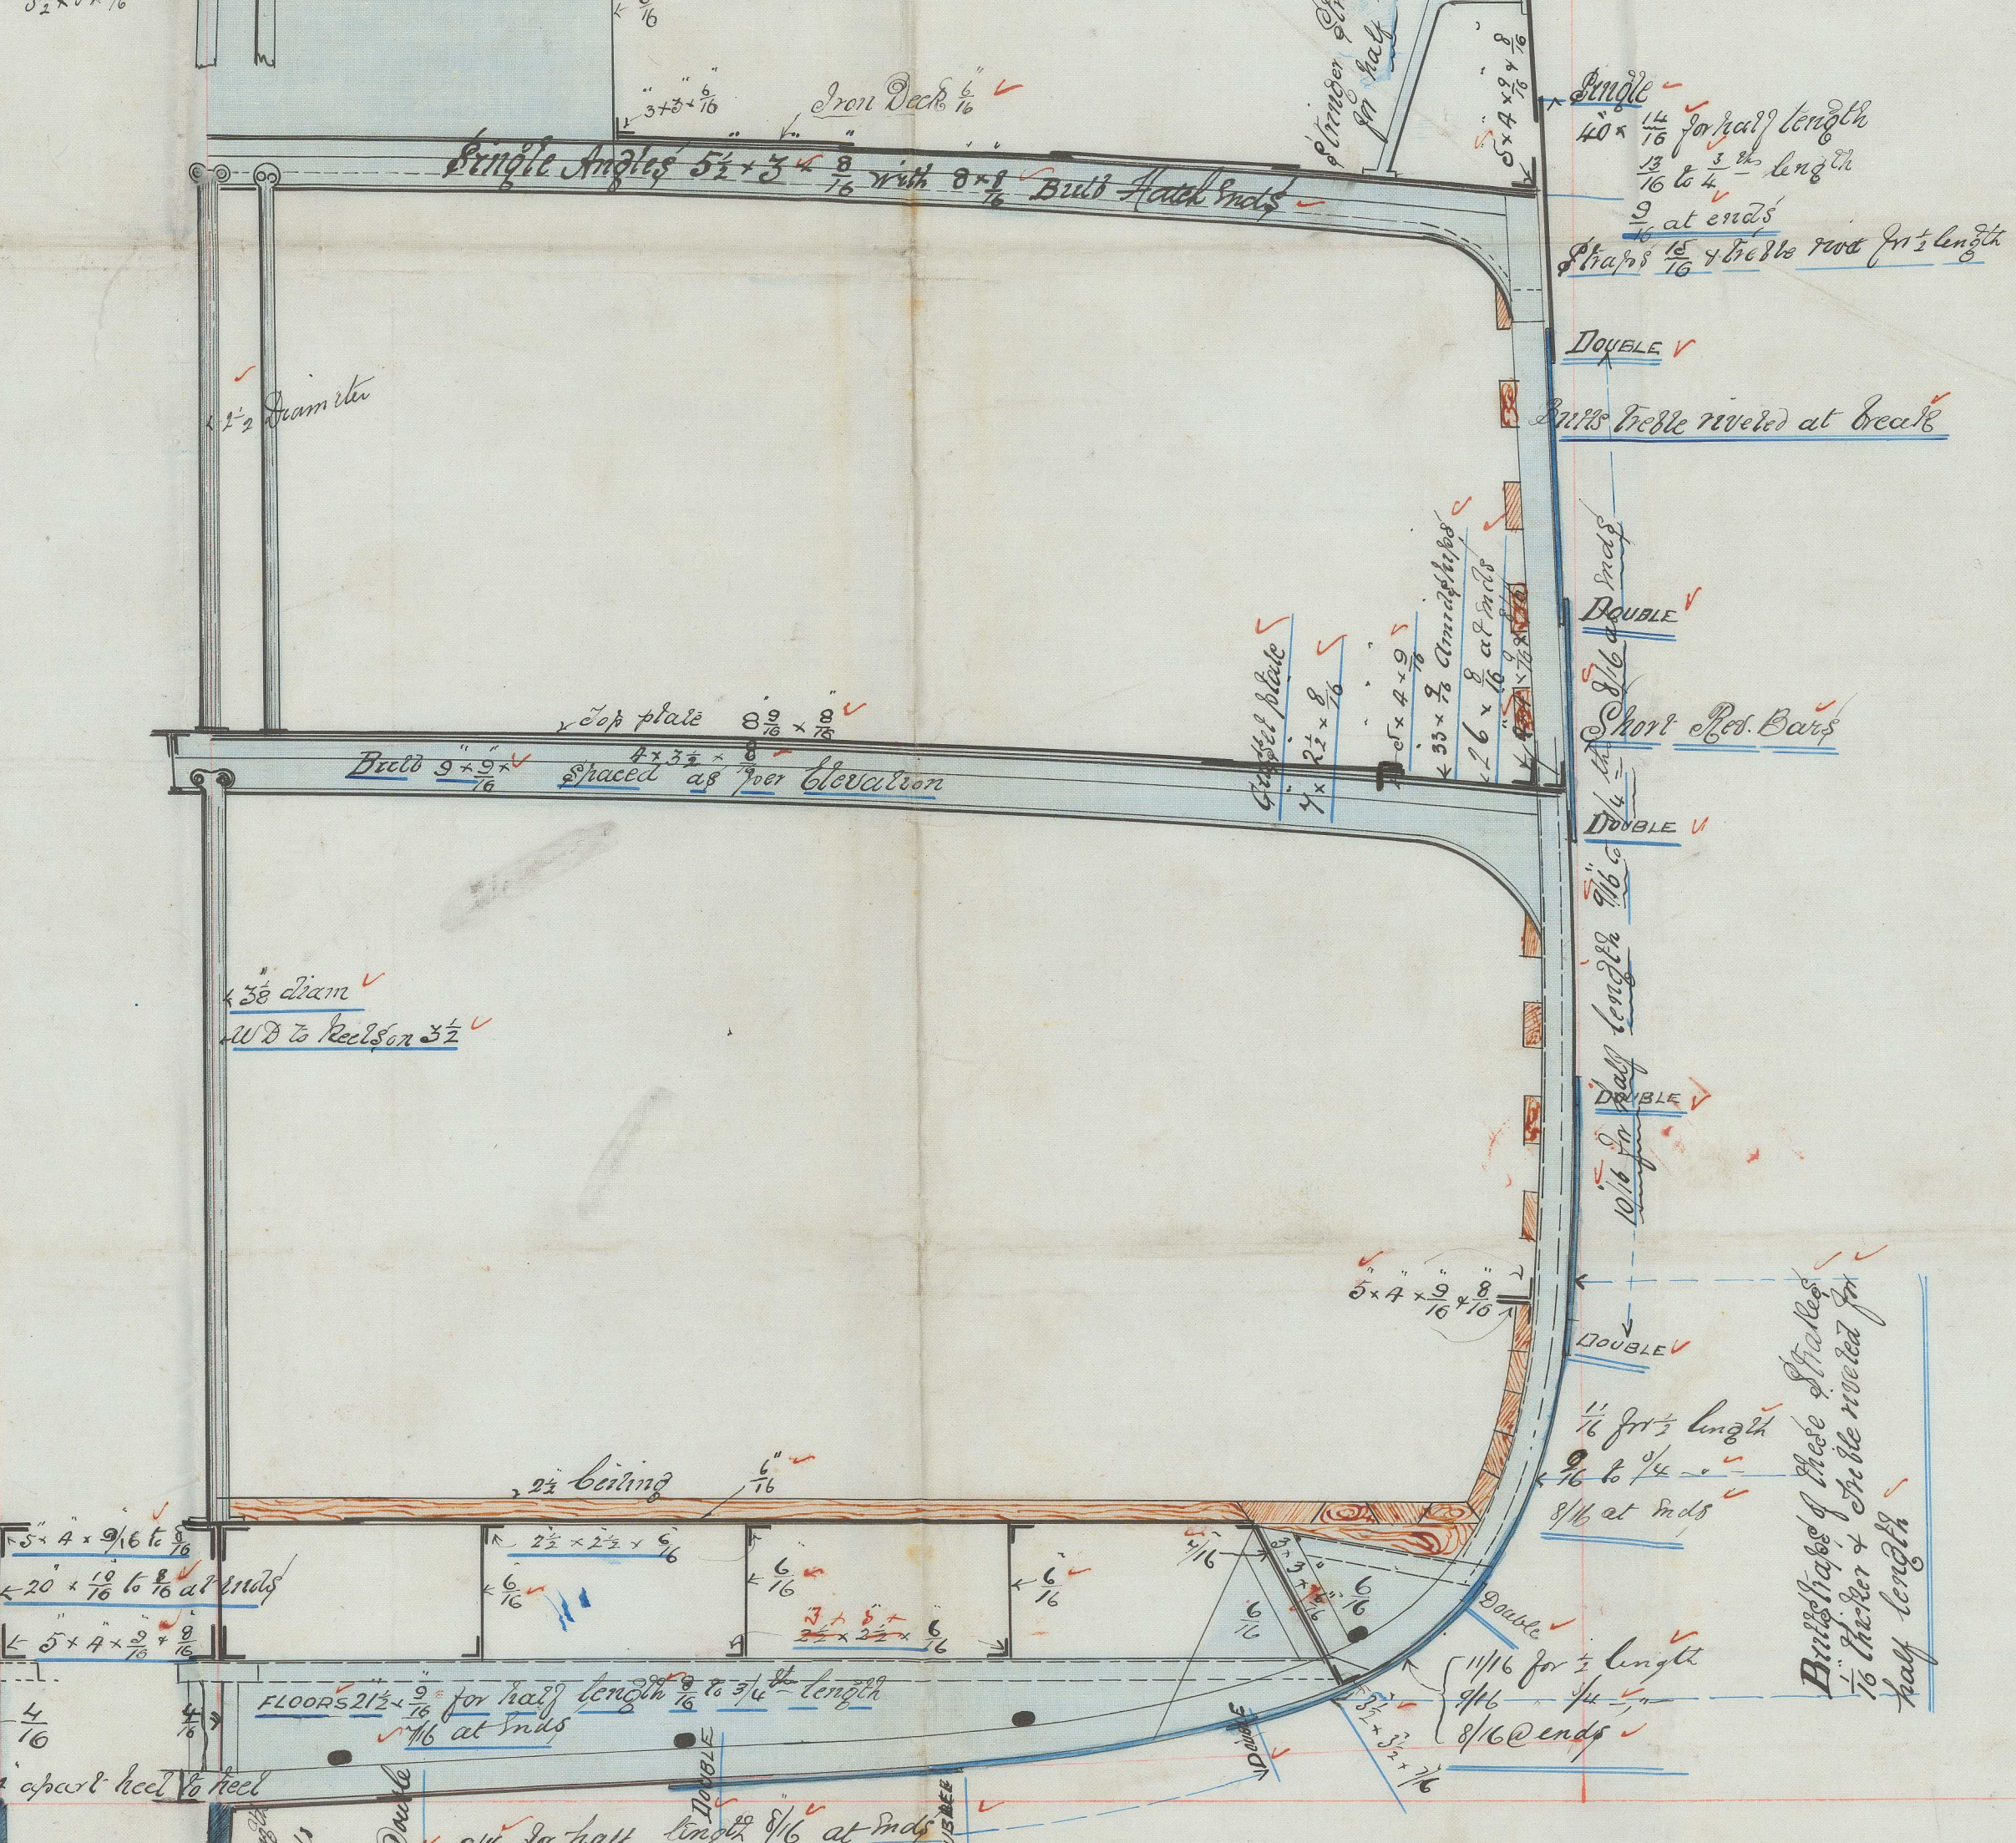

Section thro. After Hold

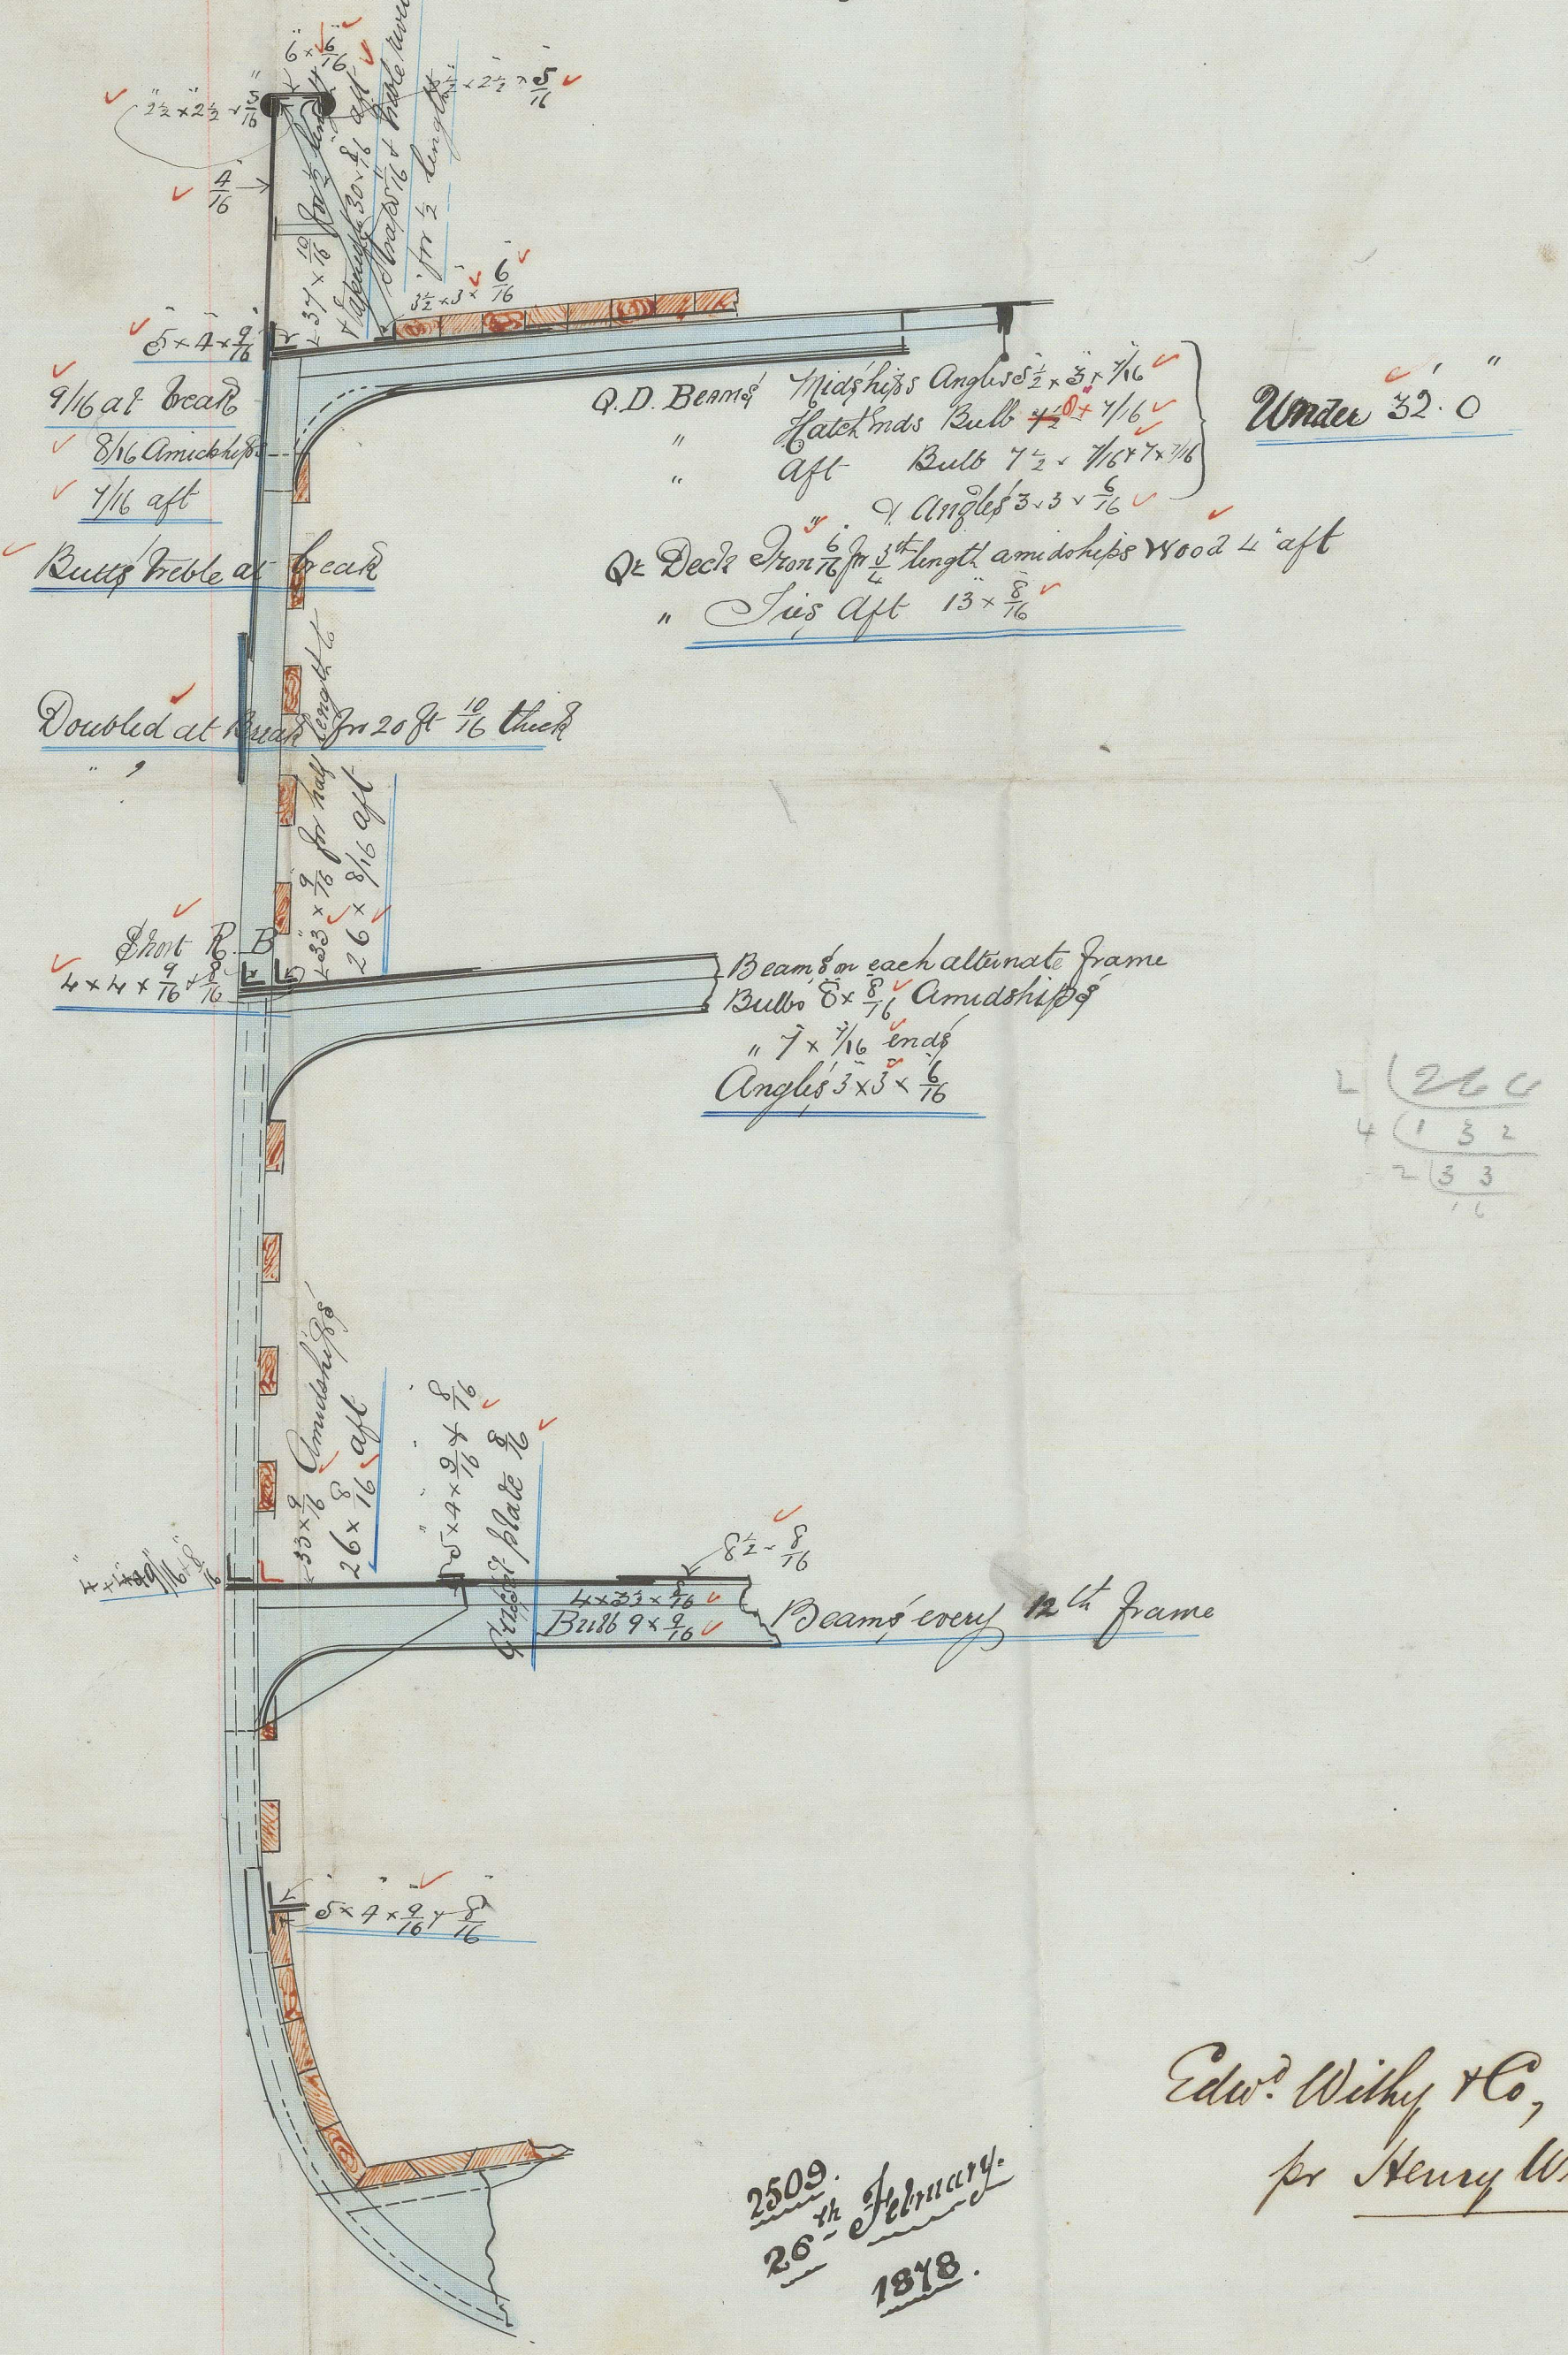

Edw. W. W. Co.,
for Henry W. W.

2509
 26th February
 1878

No 75 SS

21806

CTION

54. 45

204. 2

4. 22

IRON 530 - 0025. 22

20. 02

0. 01

10000
18400

14001

12-8-13
12-8-13

204. 01

Rev 2/3/28

10. 41

20. 02

22. 22

20. 11

120. 2

18002

20028

W. J. Gordon

Beatty Bros

W. J. Gordon

W. J. Gordon

© 2021

Lloyd's Register
Foundation

