


12/6/78

Scale  $\frac{1}{2}$  inch = 1 foot

Rec. 11/6/98  
of letter to angle iron

10/6/78

Forecastle Beams to be of full strength now  
as required by the Rules. —

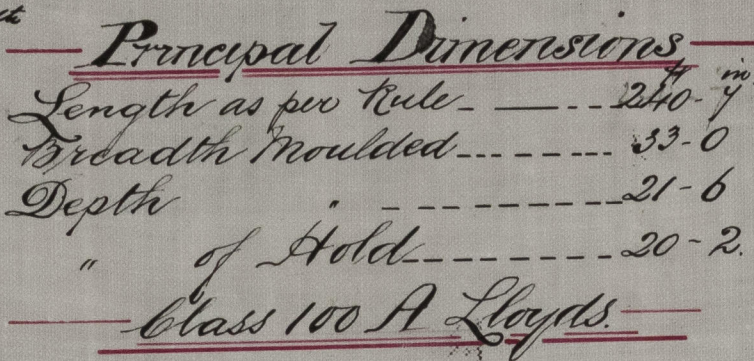

$\frac{1}{2}$  Length-----35.34  
 $\frac{1}{2}$  Breadth-----16.50  
 Depth-----32.08

$32.08$   
 $43.95 \times 340.58 = 14989$

Breadth to Length --- 7.29 ✓  
Depth " " --- 10.89 ✓

Equipment Number 18946 with  $\frac{1}{15}$  added  
 $\frac{1}{15}$  added 18976 for 100% ac

3 3/8 dia.  
long pillar  
3 3/4 dia.

15/16 Shell plating reduced 1/16" in range of Double Bottom  
all Shell plating from A to B inclusive reduced to 8/16 at ends. as per Rule  
Let's rivetting of Shell Butts as per Rule

IRON 531 - 0066

11/6/78

Storn post 8 Dec 5